

- DURABLE 4 INCH WHITE LINE, POLYUREA**
- (A1) STA. 18+00.00, RT. - STA. 304+50.00, LT. (SOLID) (540')
 - (A2) STA. 18+00.00, RT. - STA. 301+25.00, LT. (SOLID) (416')
 - (A5) STA. 18+00.00, RT. - STA. 21+63.70, RT. (SOLID) (364')
 - (A6) STA. 18+00.00, RT. - STA. 302+01.26, RT. (SOLID) (429')
 - (A7) STA. 701+56.46, RT. - STA. 702+46.84, RT. (SOLID) (92')
 - (A9) STA. 304+50.00, RT. - STA. 23+50.00, LT. (SOLID) (194')
 - (A12) STA. 602+55.61, LT. - STA. 602+51.42, LT. (SOLID) (4')
 - (A14) STA. 303+53.18, LT. - STA. 23+50.00, LT. (SOLID) (134')
- DURABLE 4 INCH YELLOW LINE, POLYUREA**
- (B1) STA. 18+00.00, LT. - STA. 21+29.82, LT. (DOUBLE) (786')
 - (B2) STA. 702+46.84, RT. - STA. 703+33.88, RT. (129')
 - (B3) STA. 603+75.88, LT. - STA. 602+55.61, LT. (102')
 - (B4) STA. 22+29.99, RT. - STA. 23+50.00, RT. (DOUBLE) (240')
 - (B5) STA. 301+25.00, CL. - STA. 301+70.67, CL. (DOUBLE) (91')
 - (B6) STA. 302+07.19, CL. - STA. 302+43.66, CL. (DOUBLE) (73')
 - (B7) STA. 303+09.59, CL. - STA. 303+47.25, CL. (DOUBLE) (75')
 - (B8) STA. 303+83.39, CL. - STA. 304+50.00, CL. (DOUBLE) (133')

- DURABLE 8 INCH WHITE LINE, POLYUREA**
- (D1) STA. 19+48.49, RT. - STA. 20+48.47, RT. (GORE MARKINGS) (81')
 - (D2) STA. 23+35.85, LT. - STA. 23+50.00, LT. (GORE MARKINGS) (18')
- DURABLE 24 INCH STOP BAR, POLYUREA**
- STA. 703+74.91, LT. (29')
 - STA. 302+42.66, RT. (11')
 - STA. 303+10.59, LT. (11')
 - STA. 603+76.91, RT. (27')
- DURABLE LETTER OR SYMBOL, POLYUREA**
- STA. 19+09.34, CL "↖" STA. 302+32.37, RT "STOP"
 - STA. 701+16.85, CL "↗" STA. 303+20.88, LT "STOP"
 - STA. 20+42.44, CL "ONLY" STA. 302+32.41, RT. "STOP"
 - STA. 21+53.82, CL "↖" STA. 603+66.59, CL "STOP"
 - STA. 21+53.82, RT "↑" STA. 22+41.15, CL "↖"
 - STA. 703+64.59, CL "STOP" STA. 22+41.15, LT "↑"



TRAFFIC SIGNS, TYPE A
SEE TRAFFIC SIGN SUMMARY SHEET

SQUARE TUBE SIGN POST AND ANCHOR
SEE TRAFFIC SIGN SUMMARY SHEET

REMOVING SIGNS
AS SHOWN - 5

MATCHLINE - STA. 18+00 - SEE SIGNS AND MARKINGS SHEET 1

MATCHLINE - STA. 23+50 - SEE SIGNS AND MARKINGS SHEET 3

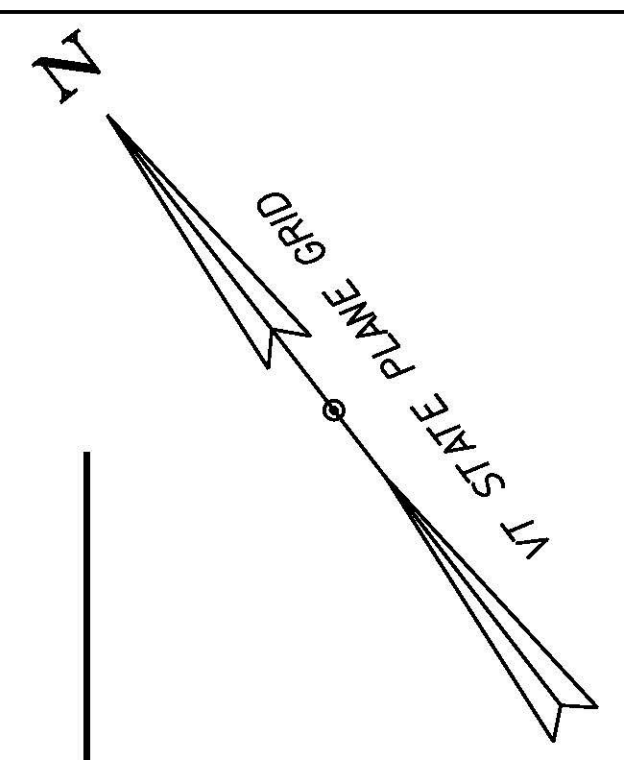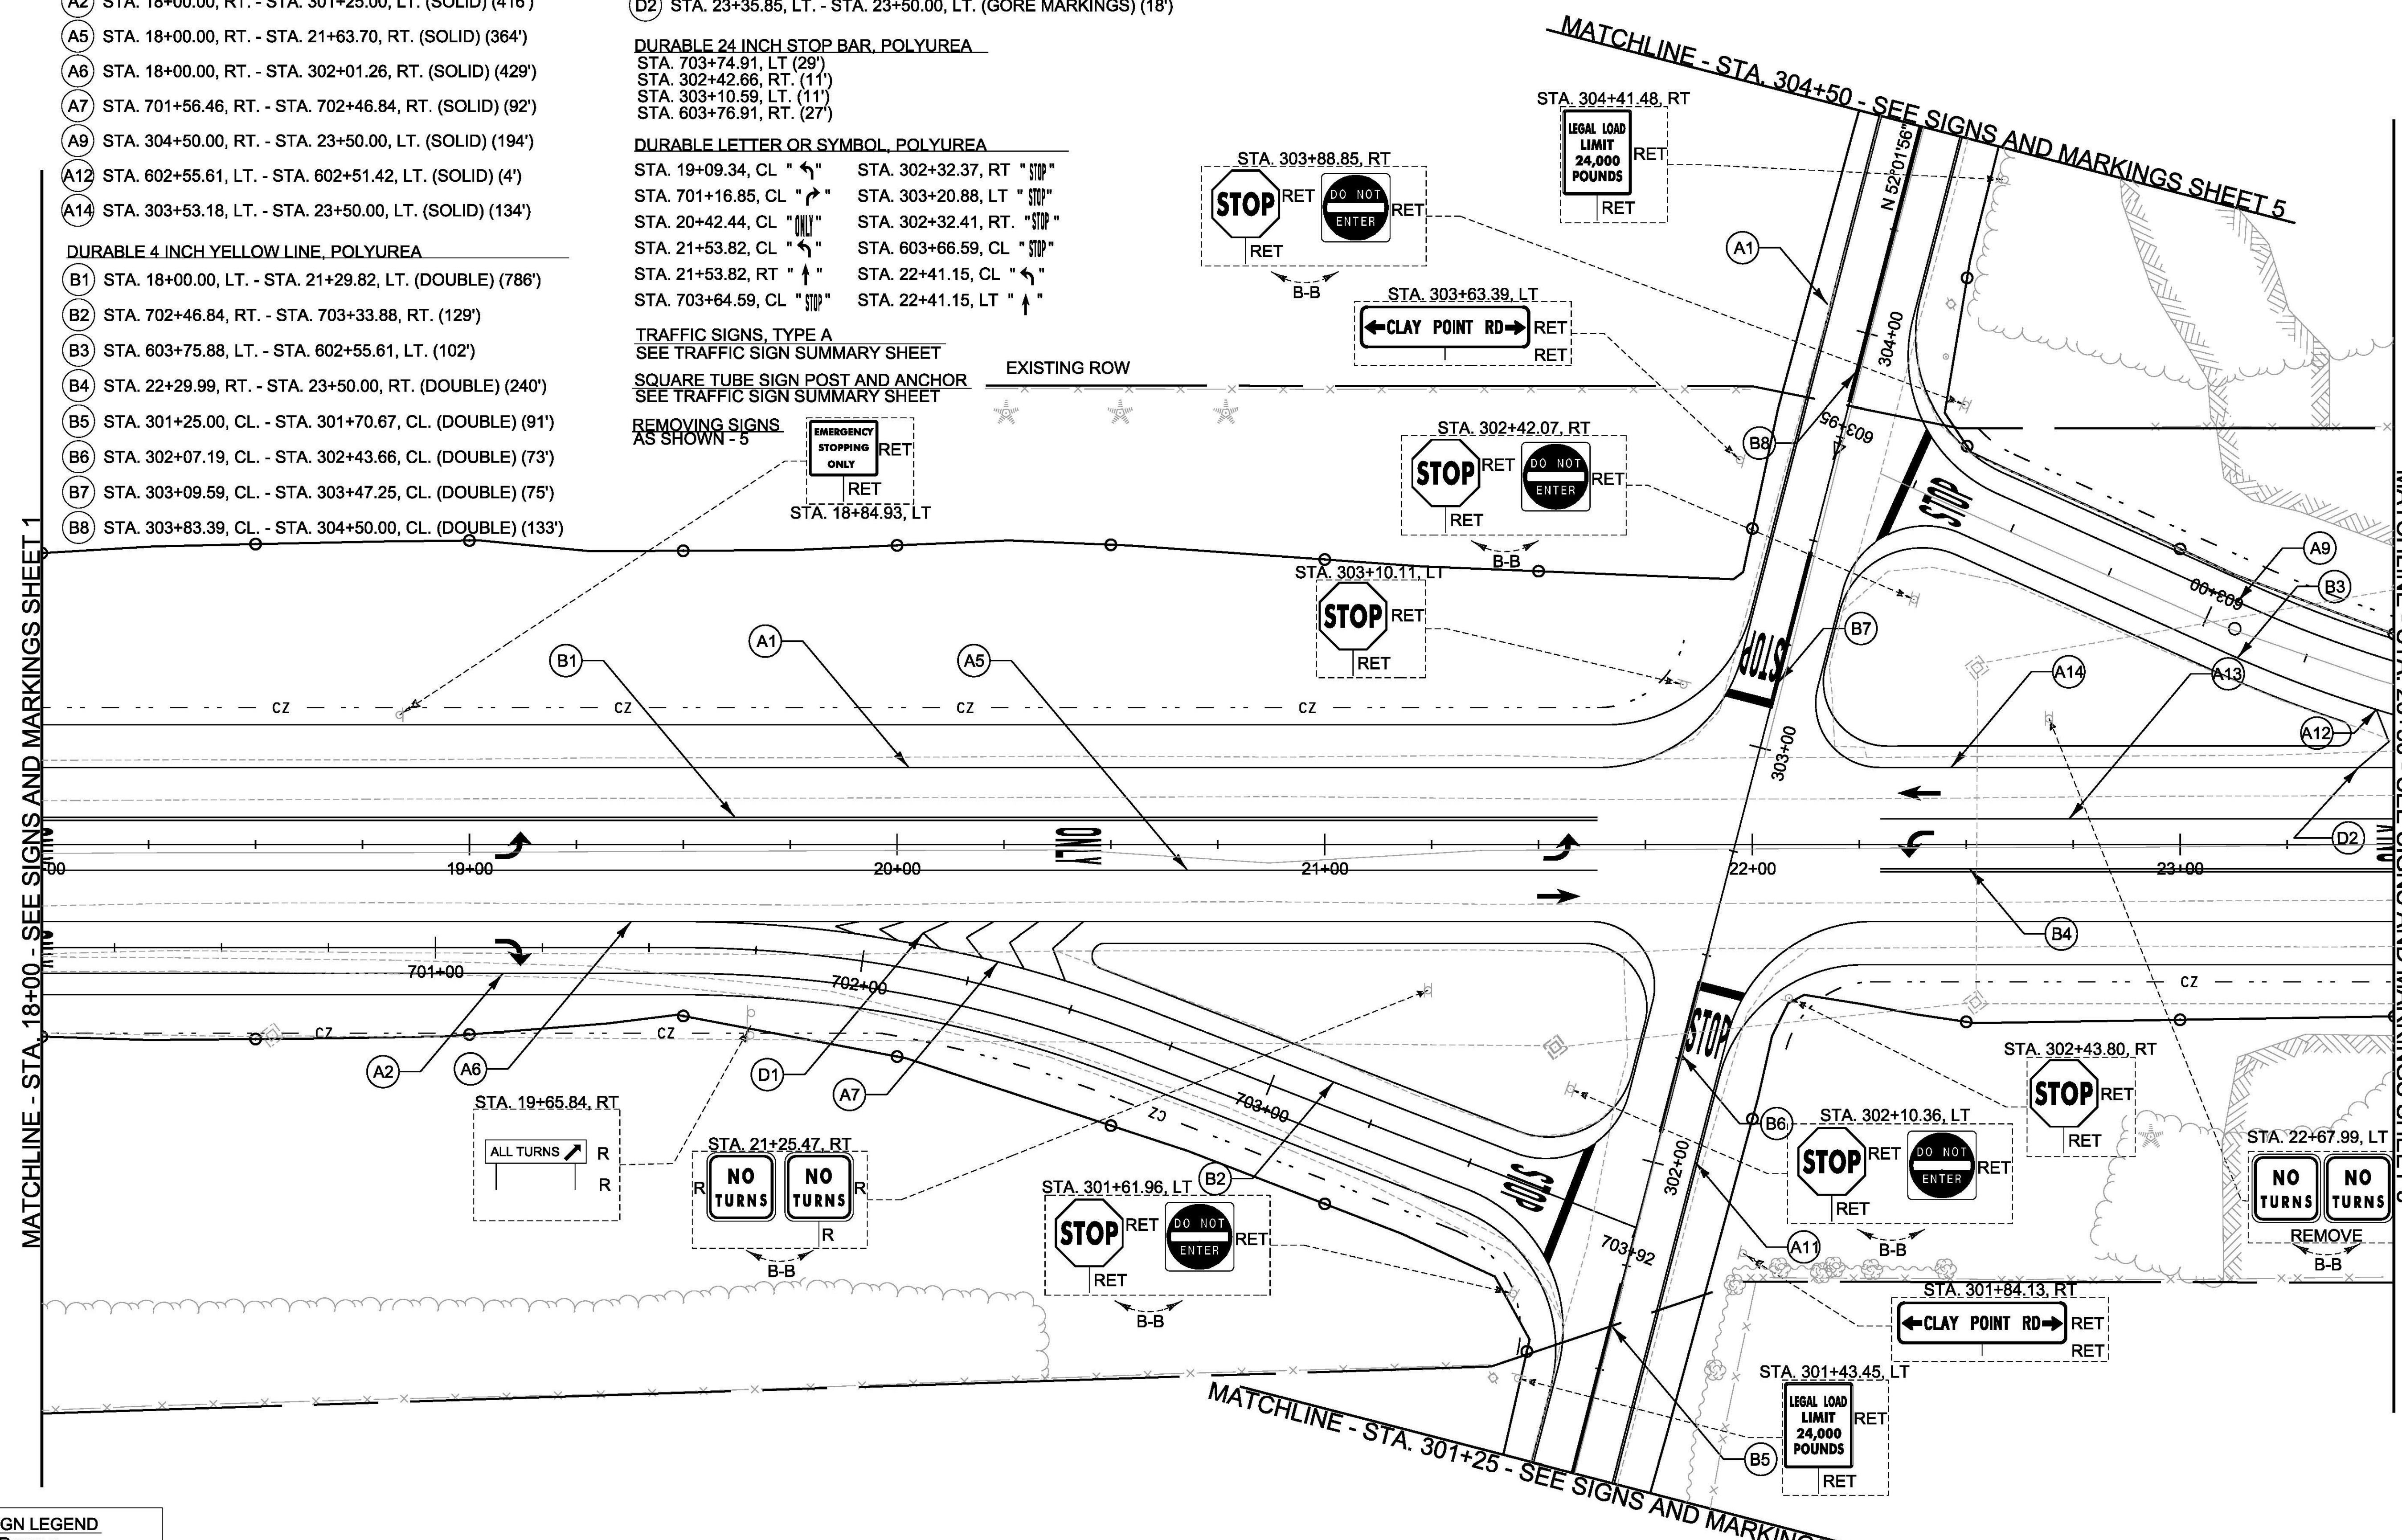

SIGN LEGEND	
R	= Remove
S	= Salvage
N	= New
RET	= Retain
T&T	= Thinning & Trimming
B-B	= Back to Back
Existing	-----
NEW	-----



PROJECT NAME:	COLCHESTER	PLOT DATE:	11/23/2015
PROJECT NUMBER:	HES 028-1(28)	DRAWN BY:	M. BOGACZYK
FILE NAME:	t13b028+sl.dgn	CHECKED BY:	M. LACROIX
PROJECT LEADER:	P. COBURN	TRAFFIC SIGN & PAVEMENT MARKING SHEET	2 SHEET 58 OF 91