

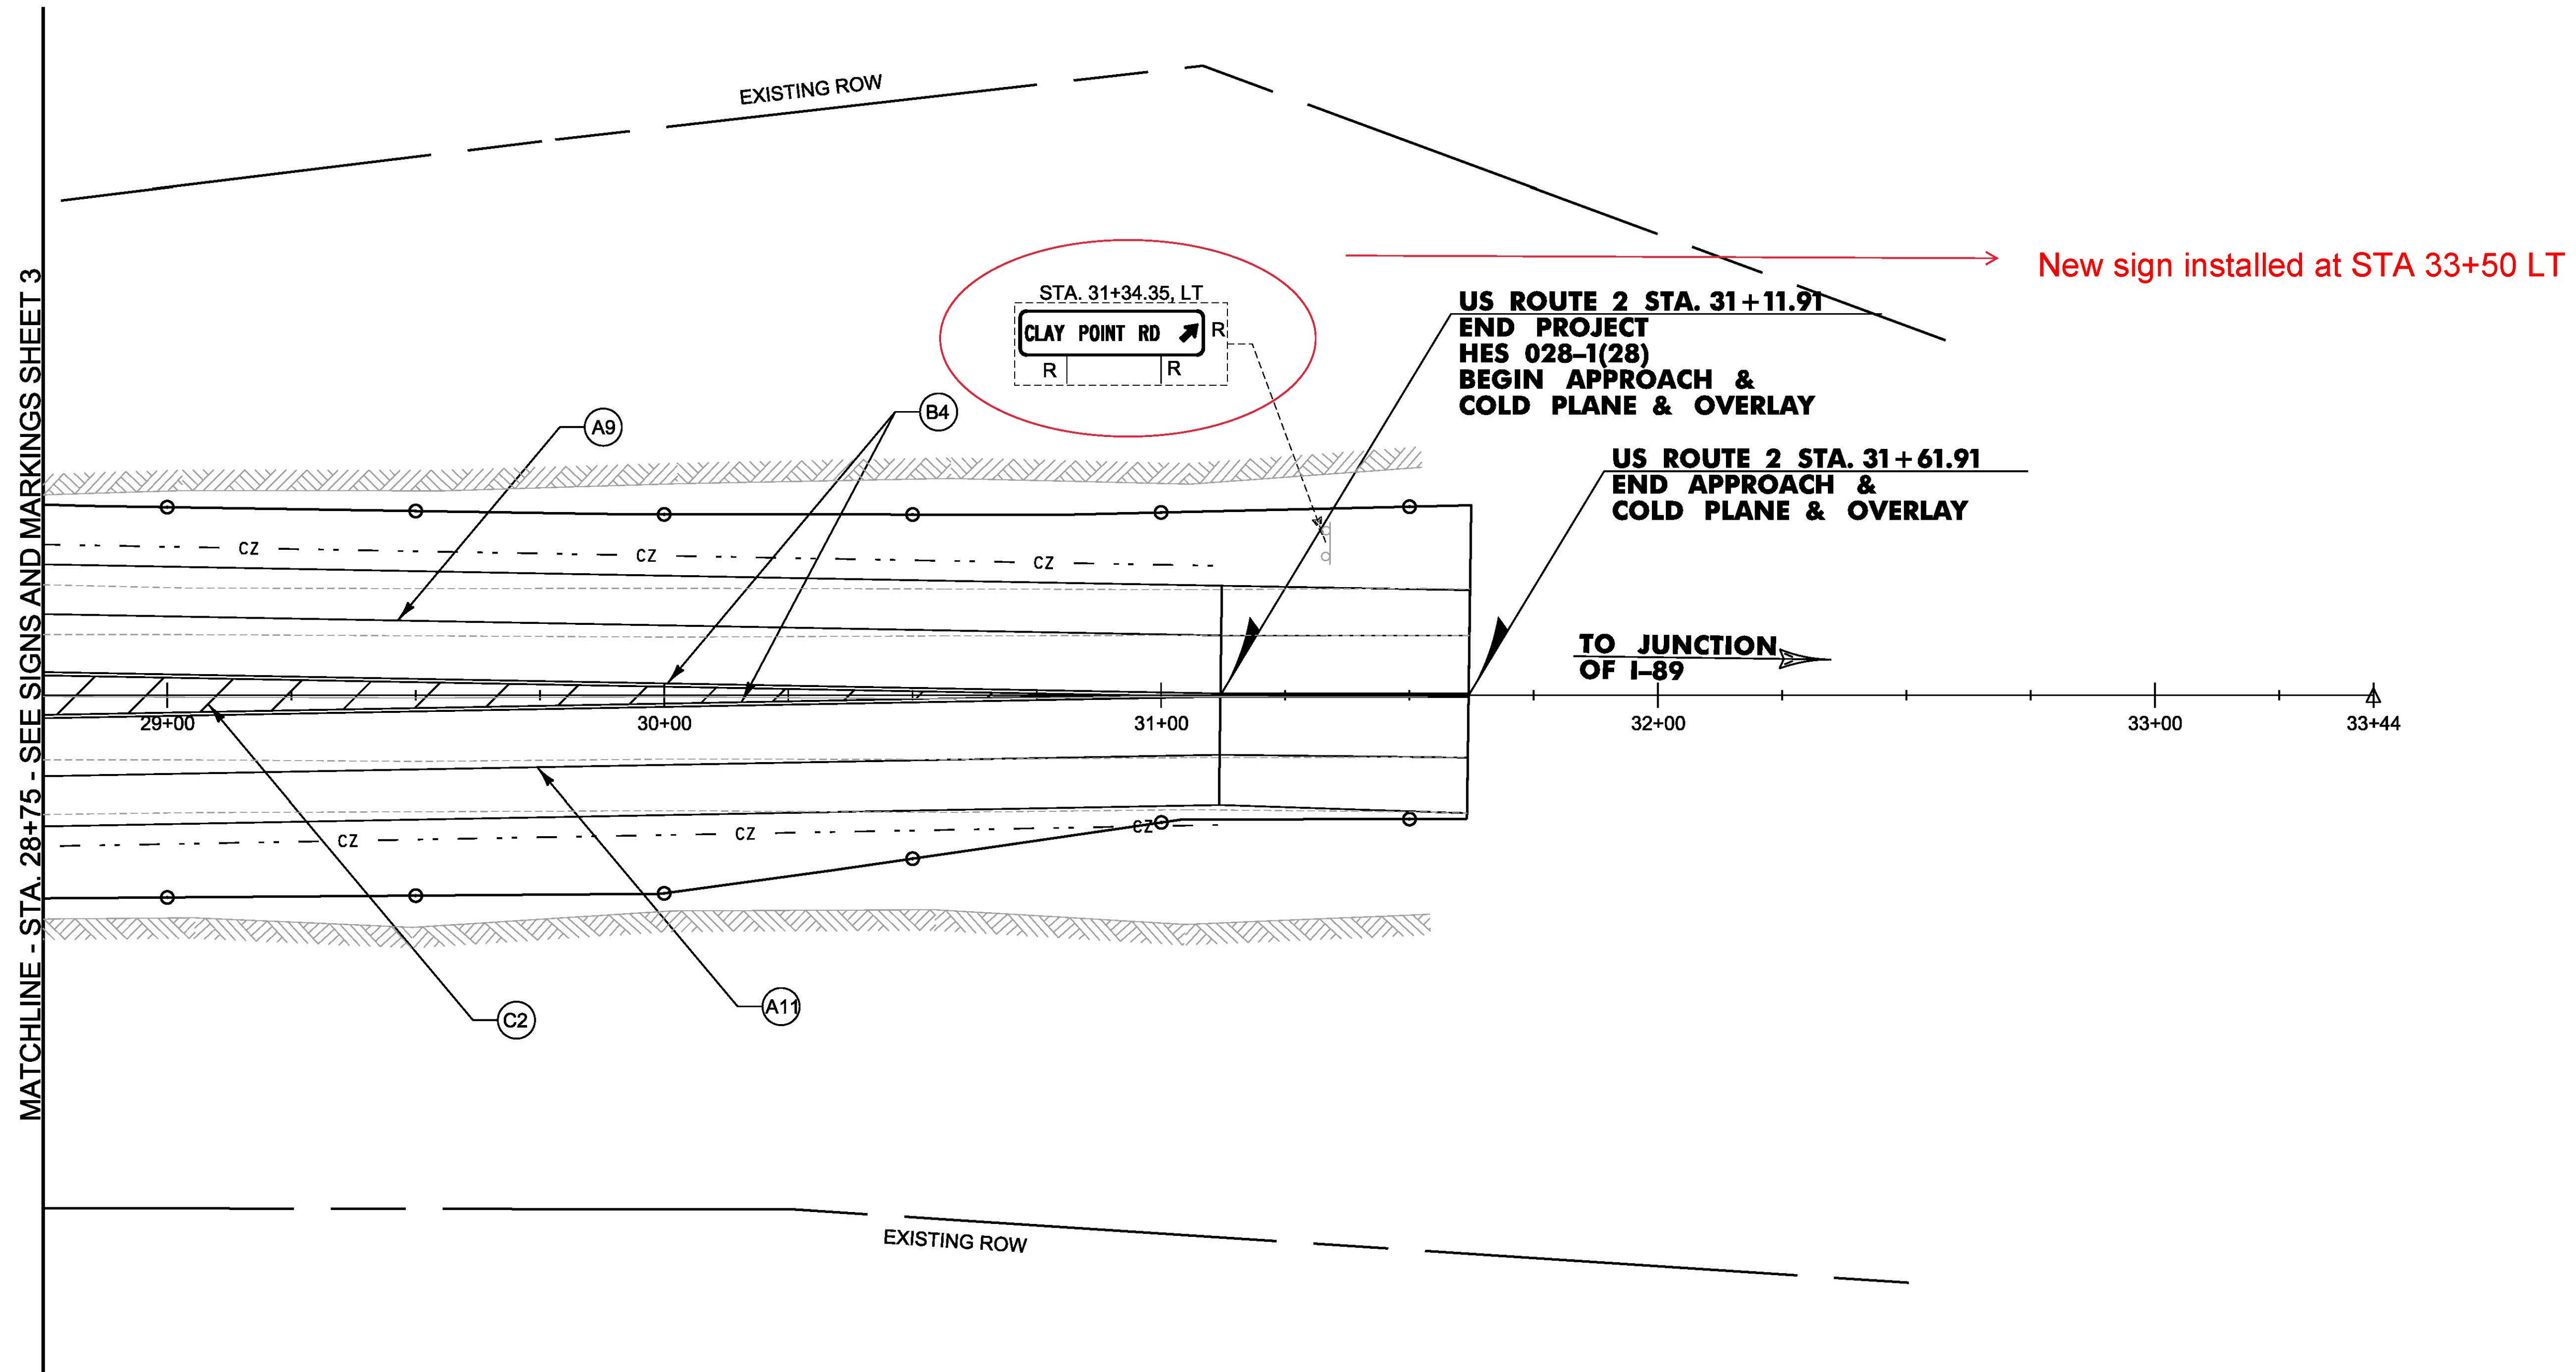


- DURABLE 4 INCH WHITE LINE, POLYUREA
- (A9) STA. 28+75.00, LT - STA. 31+61.91, LT (SOLID) (287')
- (A11) STA. 28+75.00, RT - STA. 31+61.91, RT (SOLID) (287')
- DURABLE 4 INCH YELLOW LINE, POLYUREA
- (B4) STA. 28+75.00, RT. - STA. 31+61.91, CL. (DOUBLE) (1011')
- DURABLE 8 INCH YELLOW LINE, POLYUREA
- (C2) STA. 28+75.00, CL. - STA. 30+93.62, RT. (DIAGONALS) (87')

- TRAFFIC SIGNS, TYPE A
SEE TRAFFIC SIGN SUMMARY SHEET
- SQUARE TUBE SIGN POST AND ANCHOR
SEE TRAFFIC SIGN SUMMARY SHEET
- REMOVING SIGNS
AS SHOWN - 1

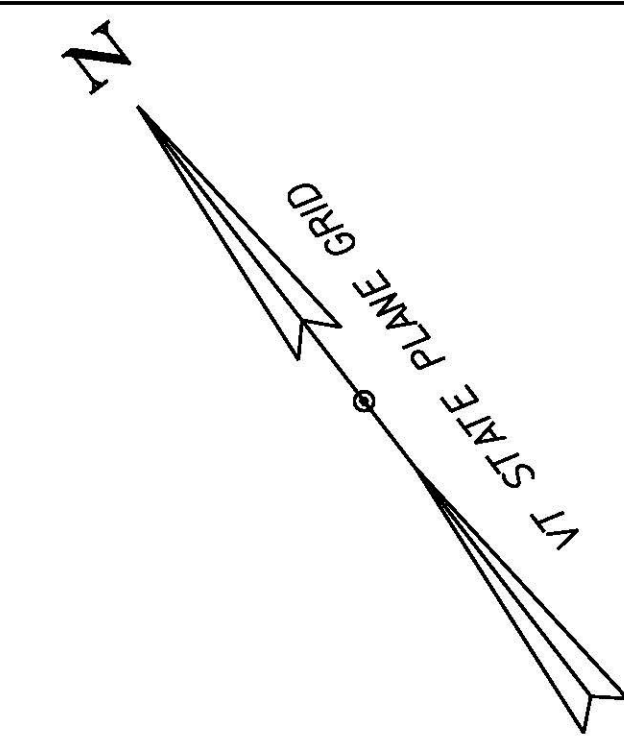

SIGN LEGEND	
R	= Remove
S	= Salvage
N	= New
RET	= Retain
T&T	= Thinning & Trimming
B-B	= Back to Back
Existing	-----
NEW	_____

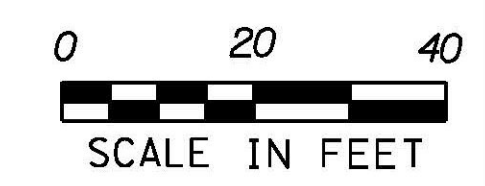

PROJECT NAME: COLCHESTER	PLOT DATE: 11/23/2015
PROJECT NUMBER: HES 028-1(28)	DRAWN BY: M. BOGACZYK
FILE NAME: t13b028+sl.dgn	CHECKED BY: M. LACROIX
PROJECT LEADER: P. COBURN	TRAFFIC SIGN & PAVEMENT MARKING SHEET 4 SHEET 60 OF 91
DESIGNED BY: M. BOGACZYK	