




14+50

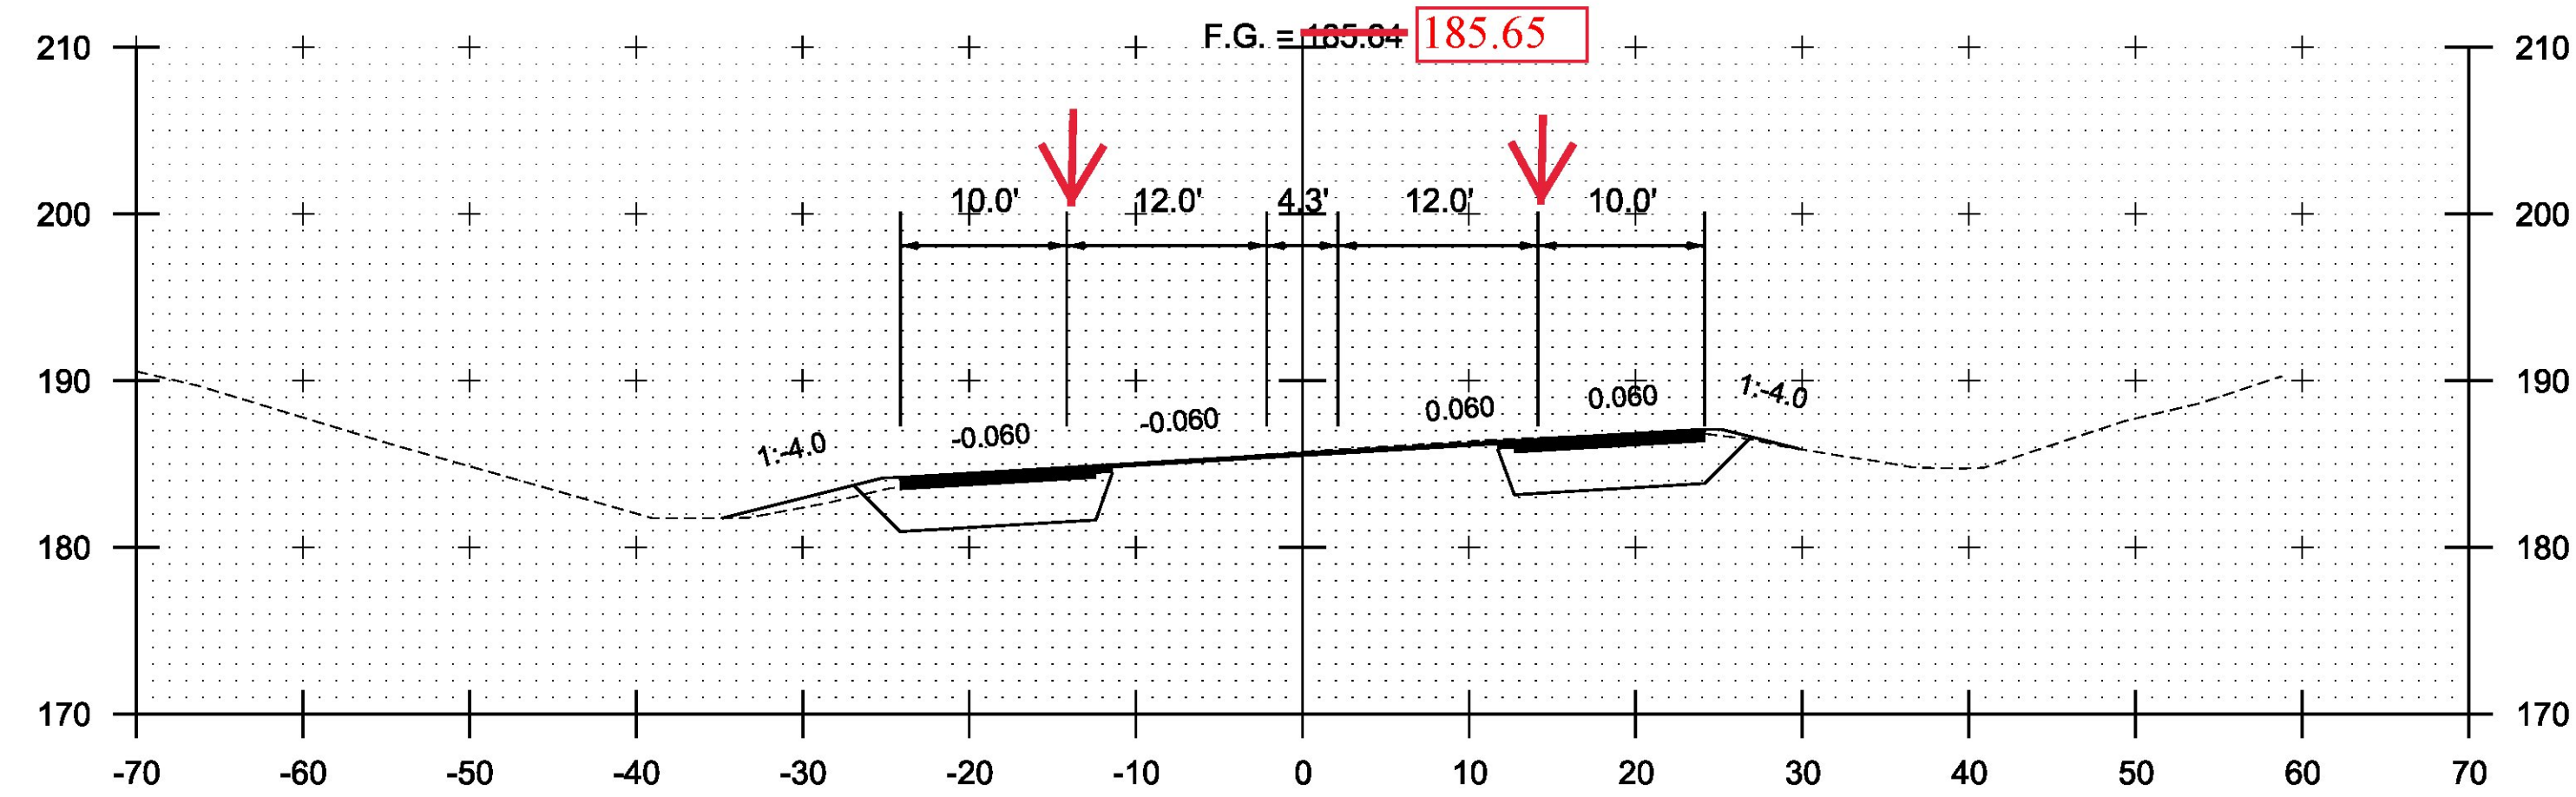


14+00

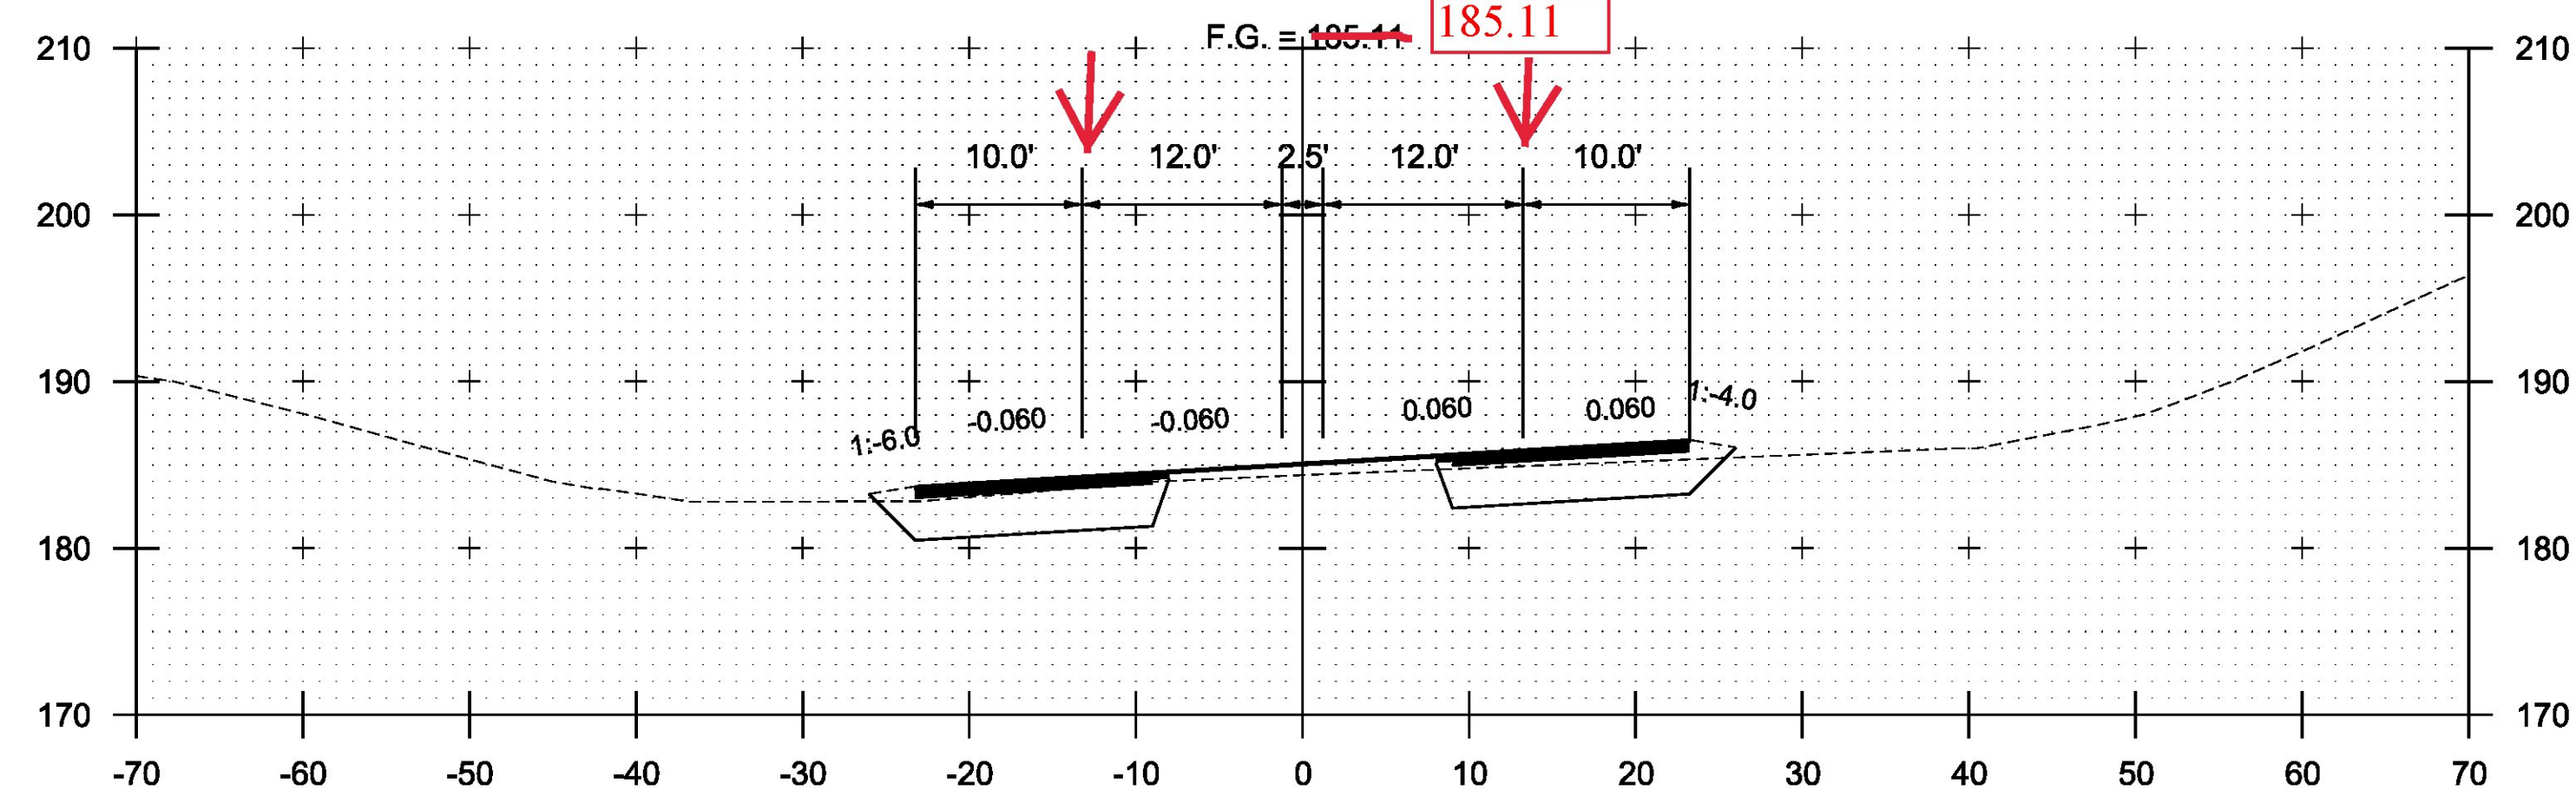


13+50

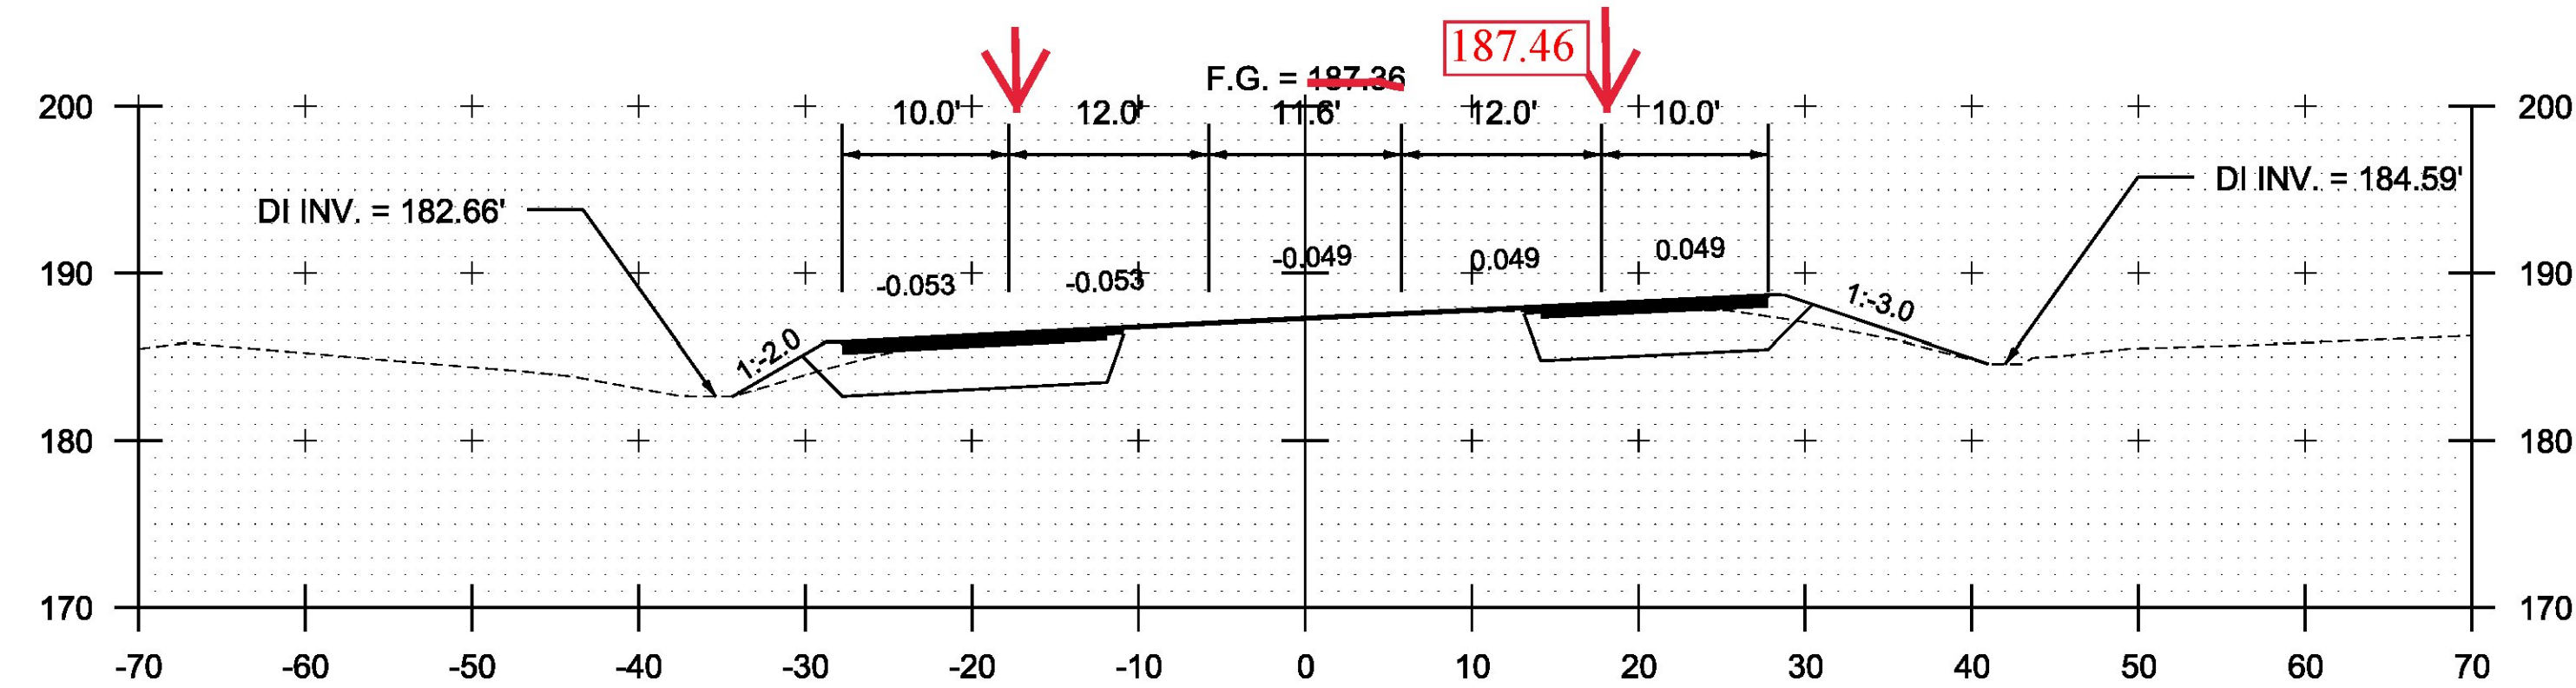


16+00

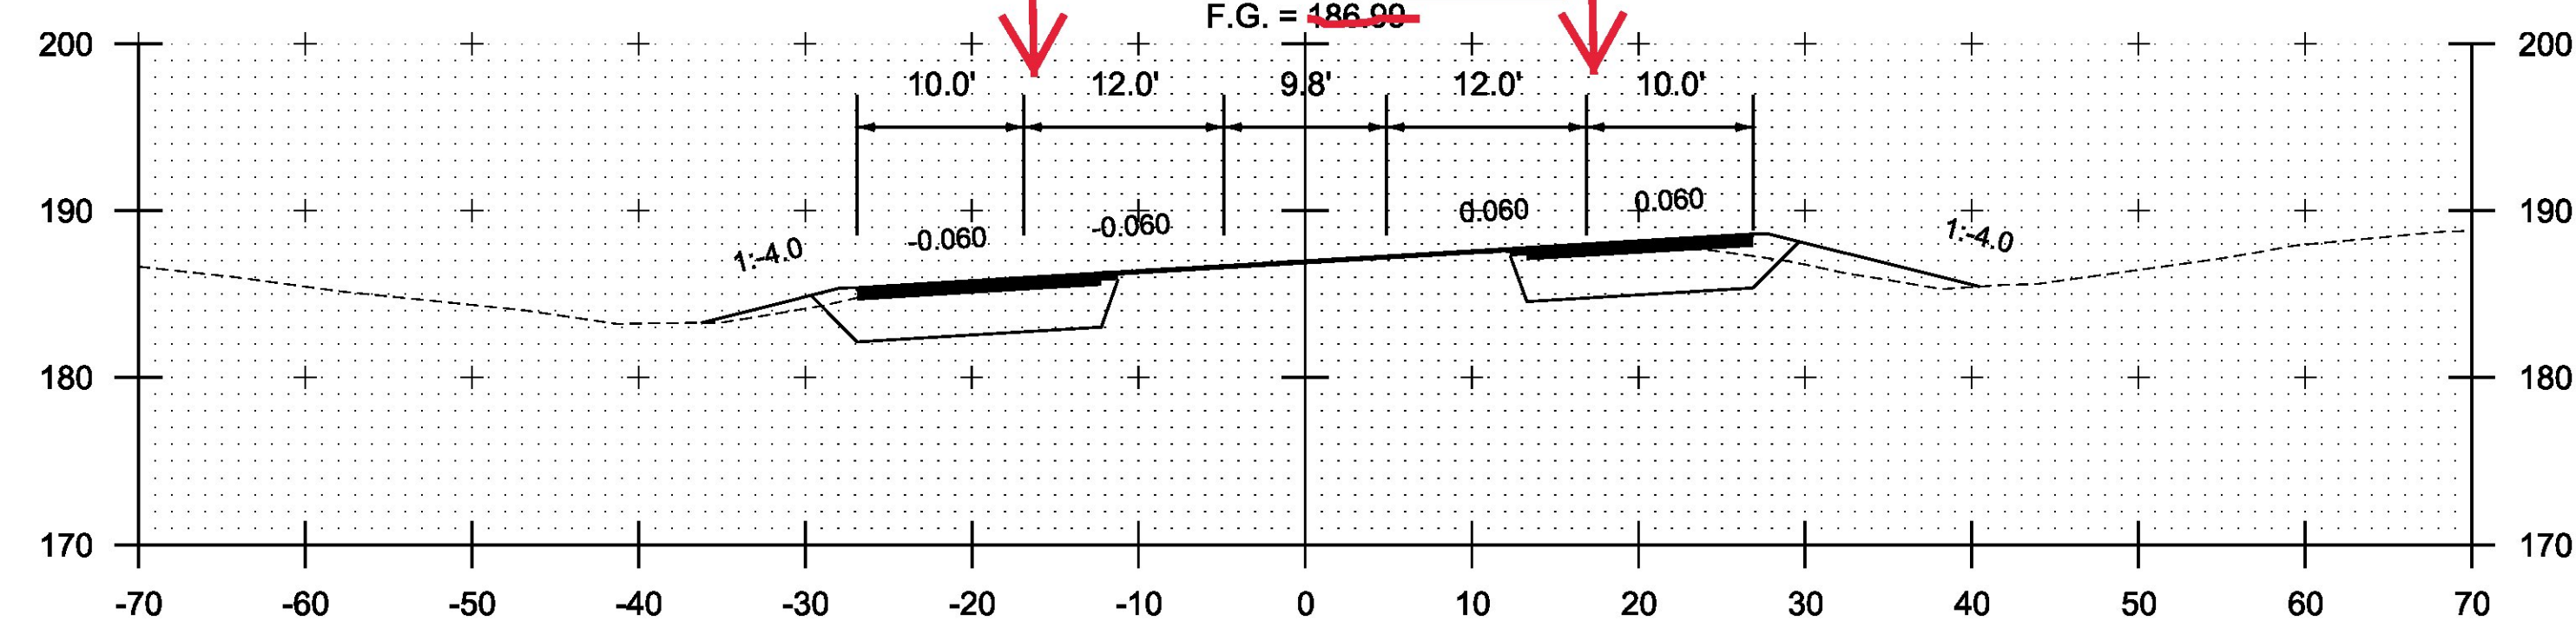

15+50

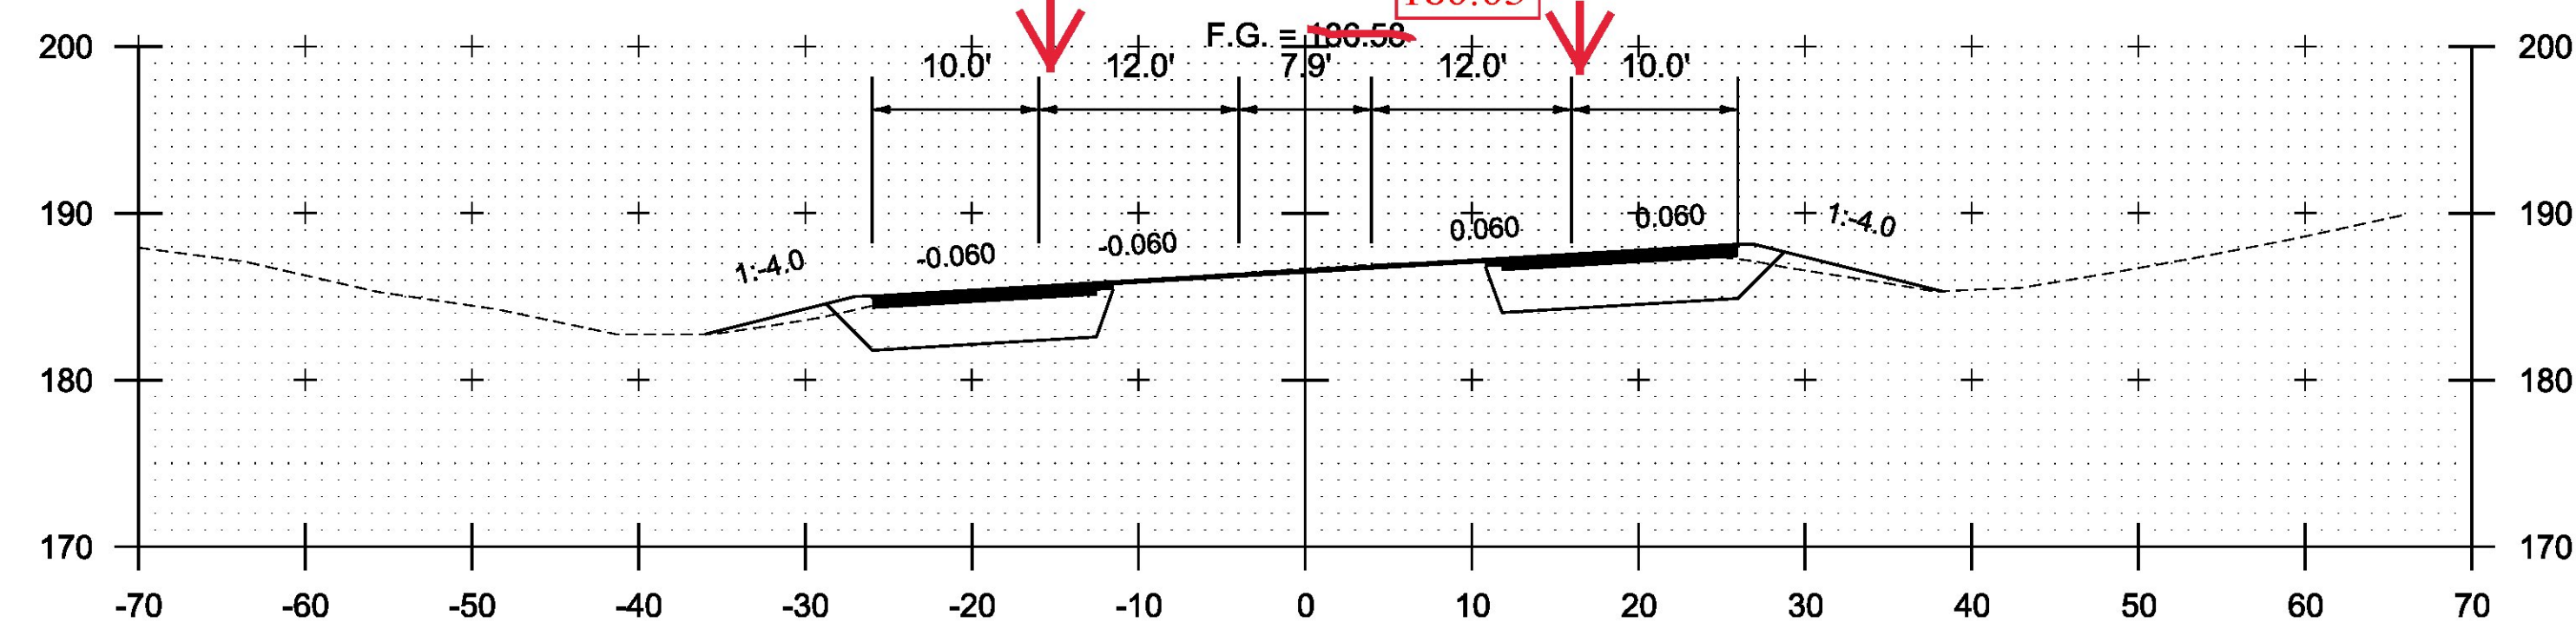

15+00

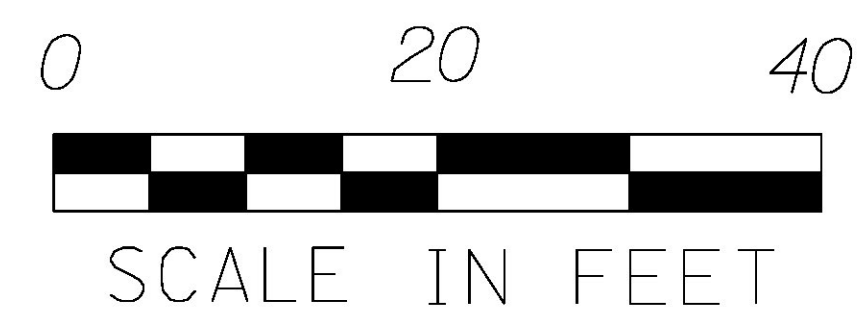

STA. 13+50 TO STA. 16+00

PROJECT NAME: COLCHESTER	
PROJECT NUMBER: HES 028-1(28)	
FILE NAME: i3b028xsl.dgn	PLOT DATE: 12/7/2015
PROJECT LEADER: COBURN	DRAWN BY: M. BOGACZYK
DESIGNED BY: M. BOGACZYK	CHECKED BY: M. LACROIX
CROSS SECTION SHEET 2	SHEET 6 OF 9