


16+04.63

17+50

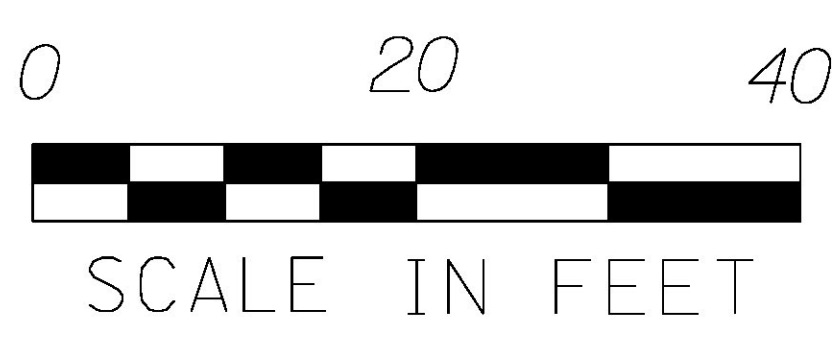

STA. 16+05 TO STA. 18+50

PROJECT NAME:	COLCHESTER
PROJECT NUMBER:	HES 028-1(28)
FILE NAME:	t13b028xsl.dgn
PROJECT LEADER:	P. COBURN
DESIGNED BY:	M. BOGACZYK
CROSS SECTION SHEET 3	
PLOT DATE:	12/7/2015
DRAWN BY:	M. BOGACZYK
CHECKED BY:	M. LACROIX
SHEET	65 OF 91