

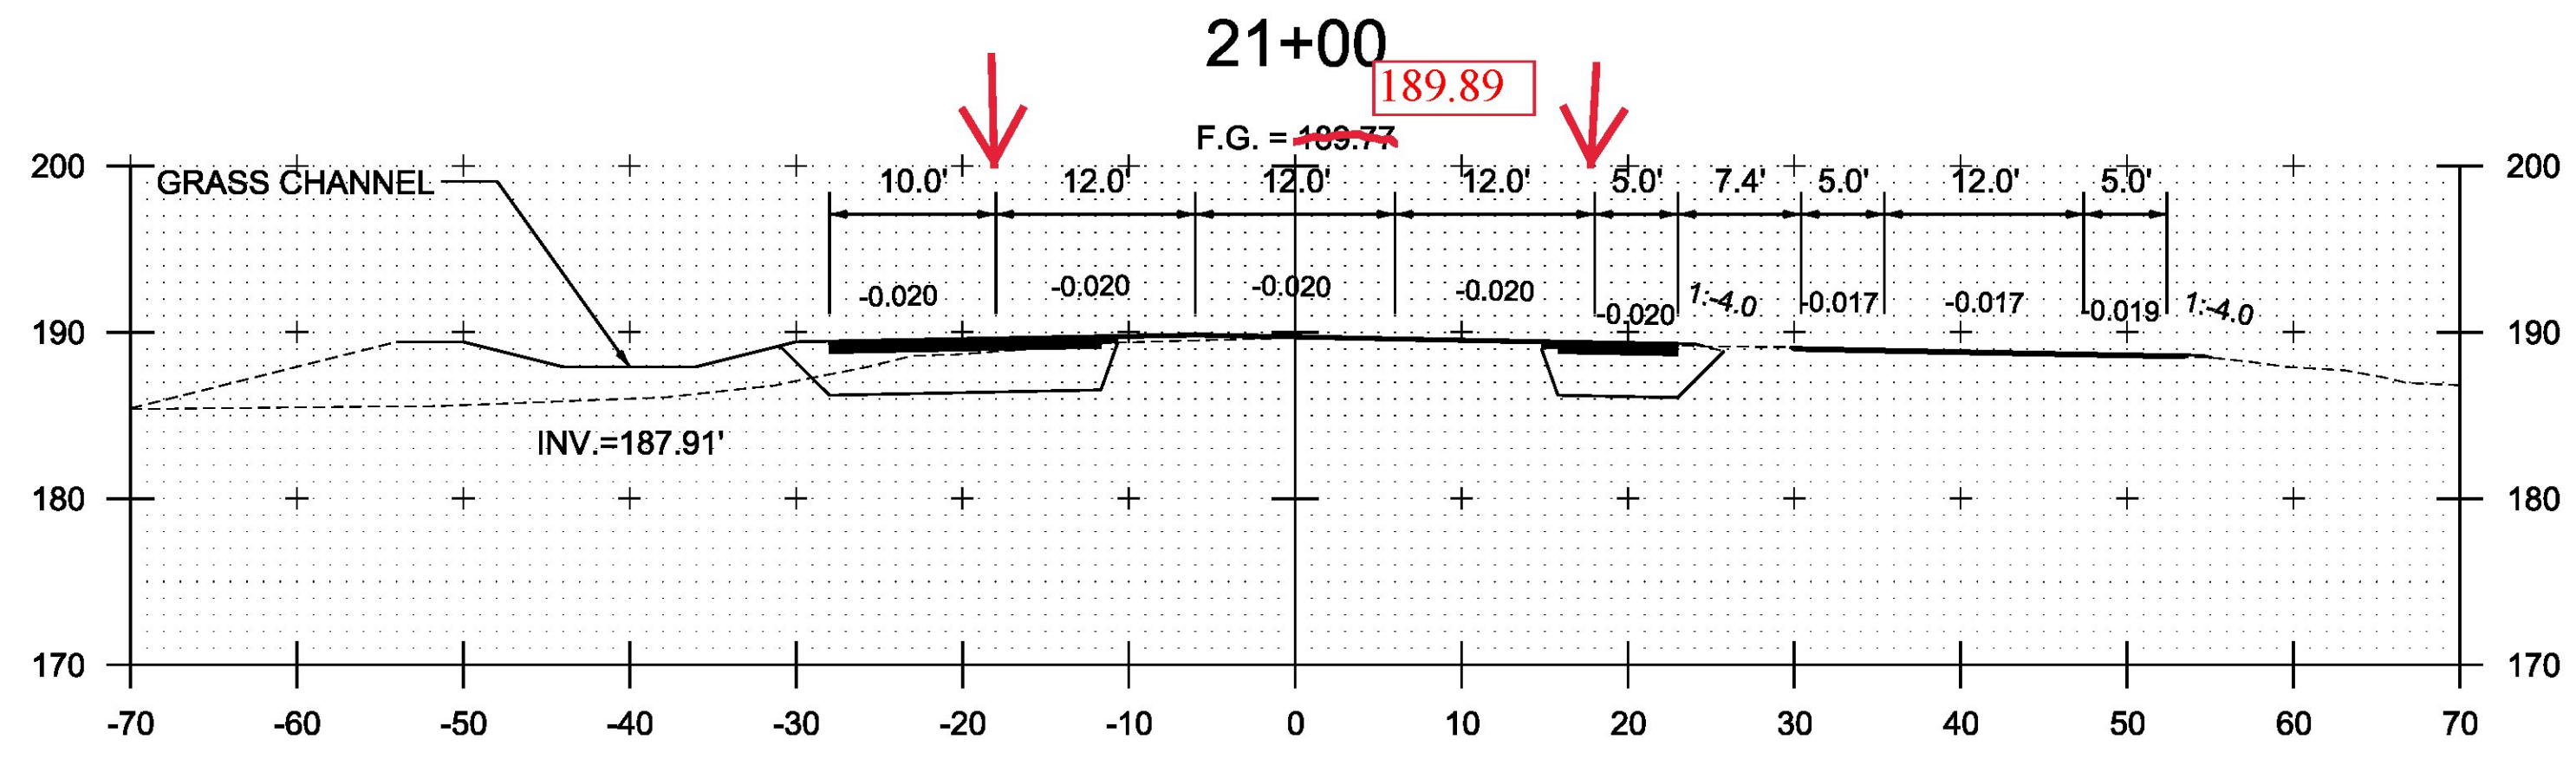


19+00

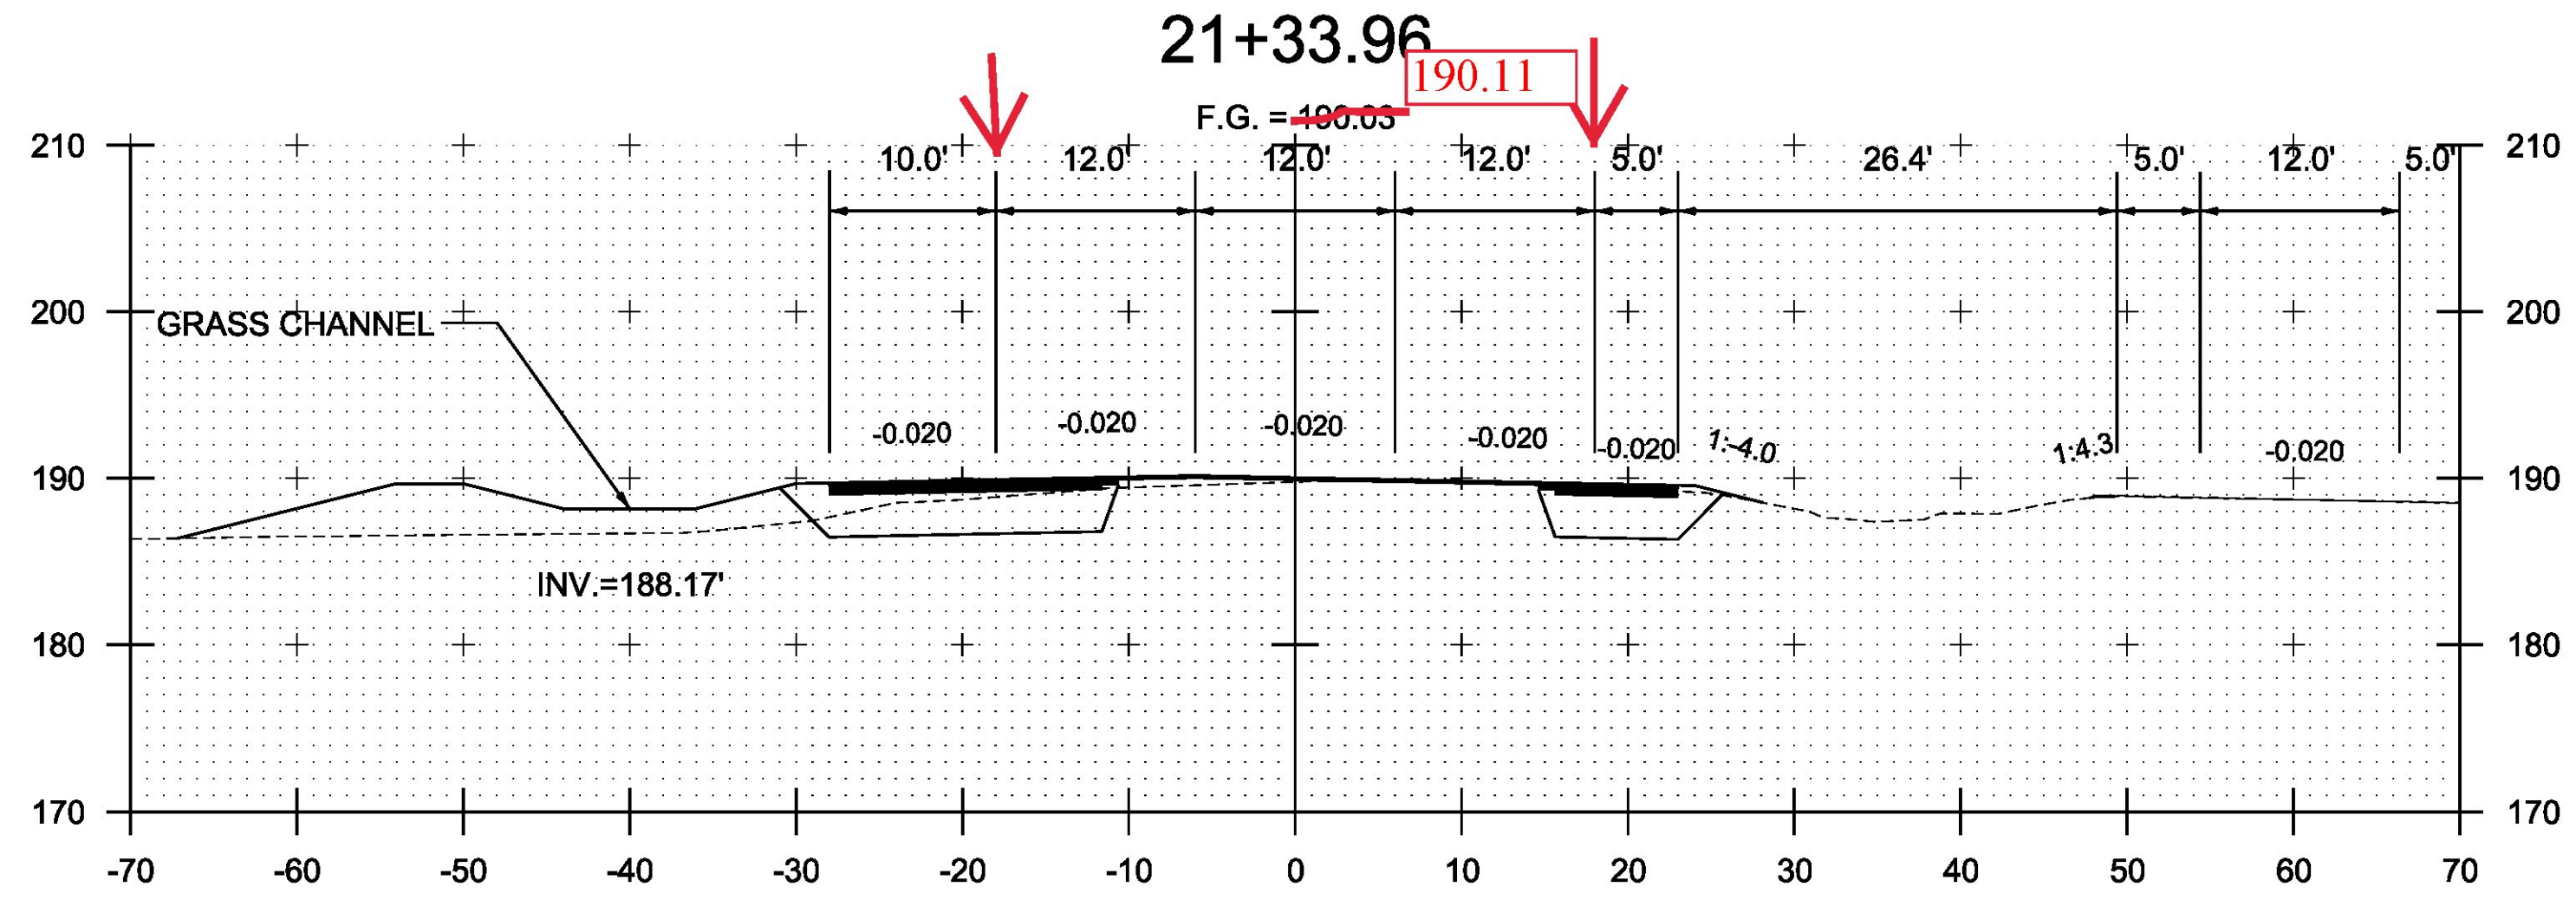

20+50

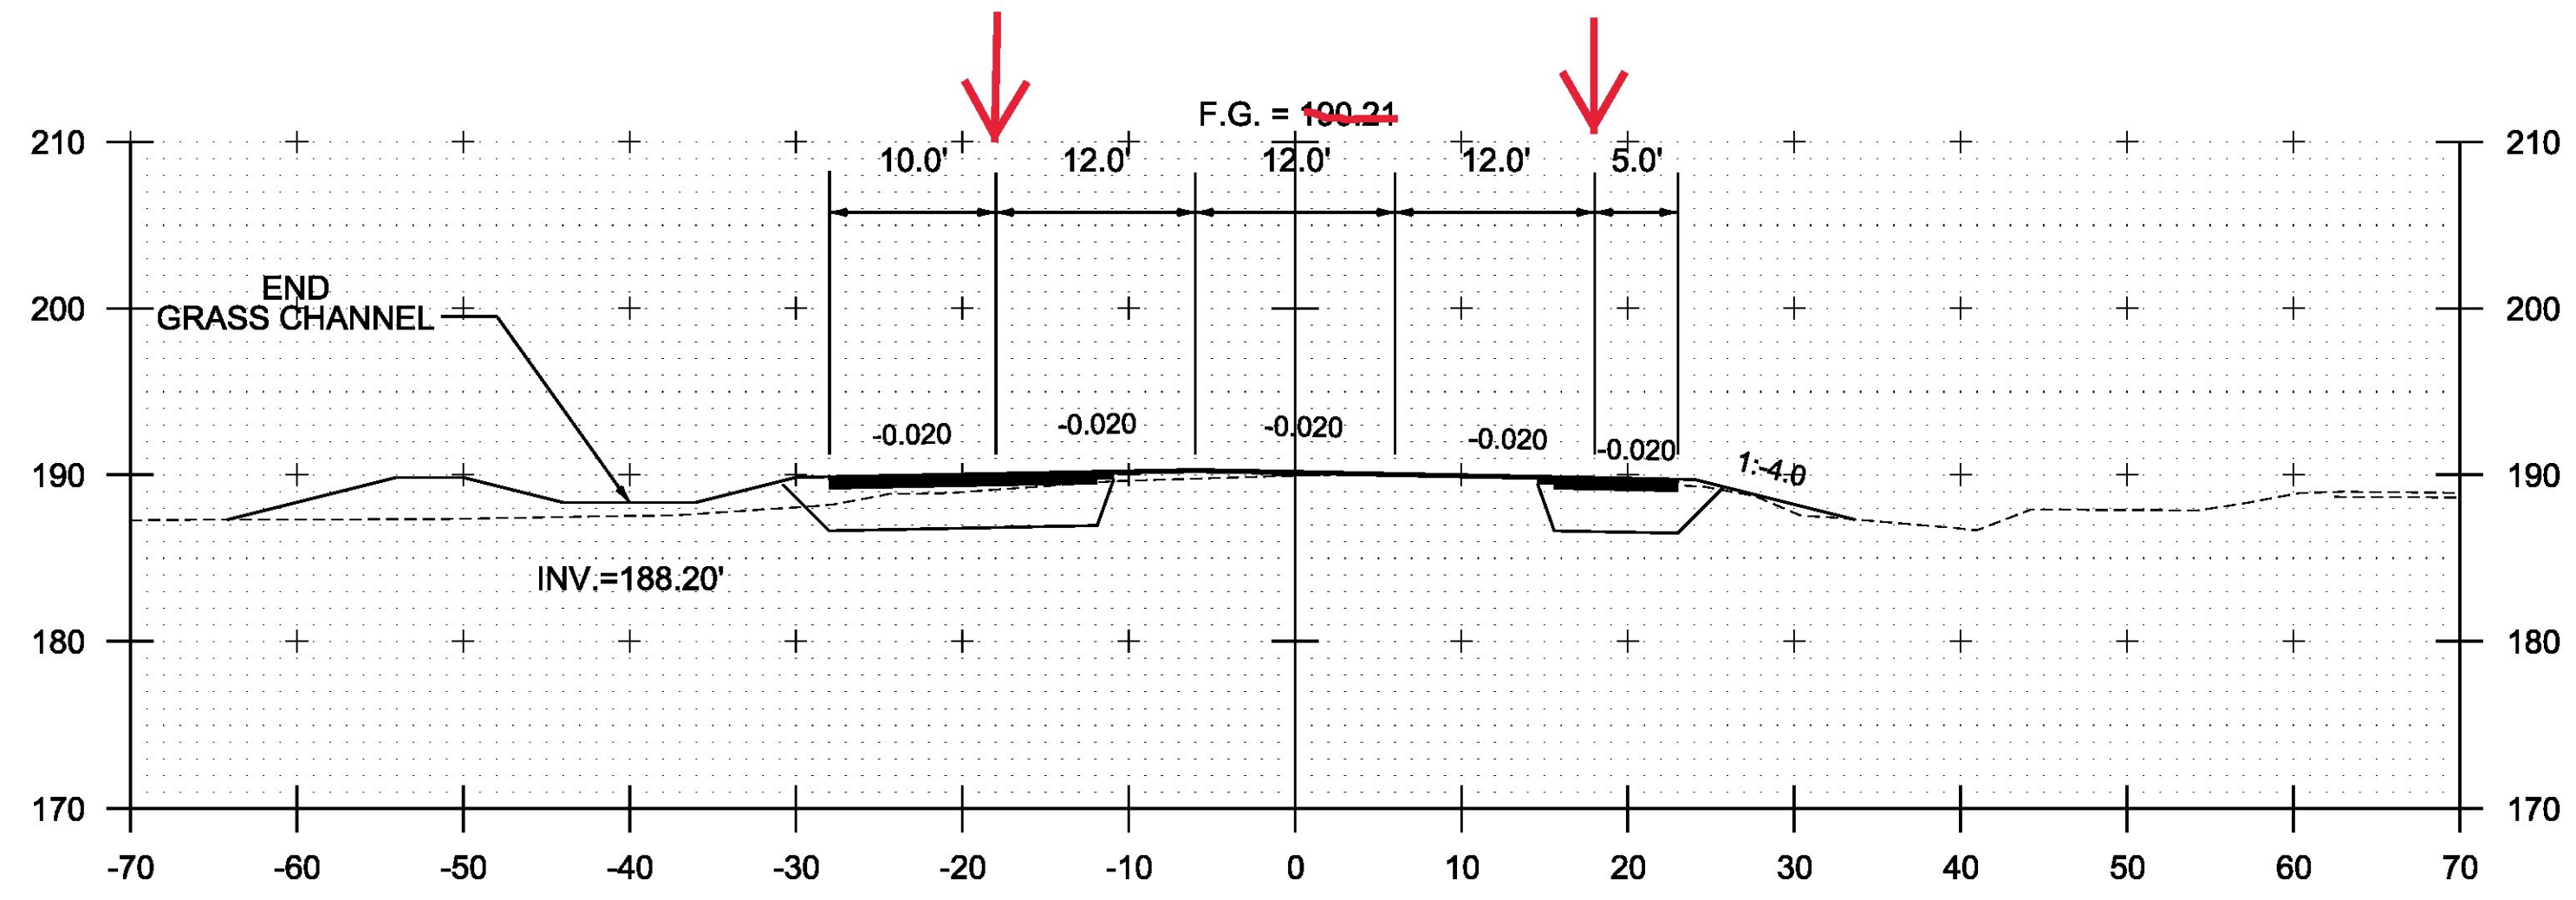

STA. 19+00 TO STA. 21+34

PROJECT NAME: COLCHESTER	
PROJECT NUMBER: HES 028-1(28)	
FILE NAME: t13b028xsl.dgn	PLOT DATE: 12/7/2015
PROJECT LEADER: P. COBURN	DRAWN BY: M. BOGACZYK
DESIGNED BY: M. BOGACZYK	CHECKED BY: M. LACROIX
CROSS SECTION SHEET 4	SHEET 66 OF 91