


30+00

31+11.91

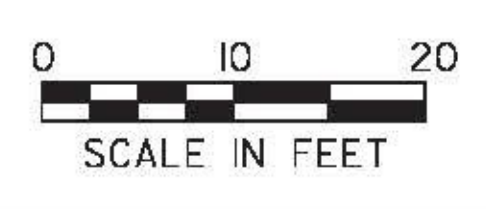

STA. 30+00 TO STA. 31+61.91

PROJECT NAME: COLCHESTER	
PROJECT NUMBER: HES 028-1(28)	
FILE NAME: i13b028xsl.dgn	PLOT DATE: 12/15/2015
PROJECT LEADER: COBURN	DRAWN BY: M. BOGACZYK
DESIGNED BY: M. BOGACZYK	CHECKED BY: M. LACROIX
CROSS SECTION SHEET 8	SHEET 70 OF 91