
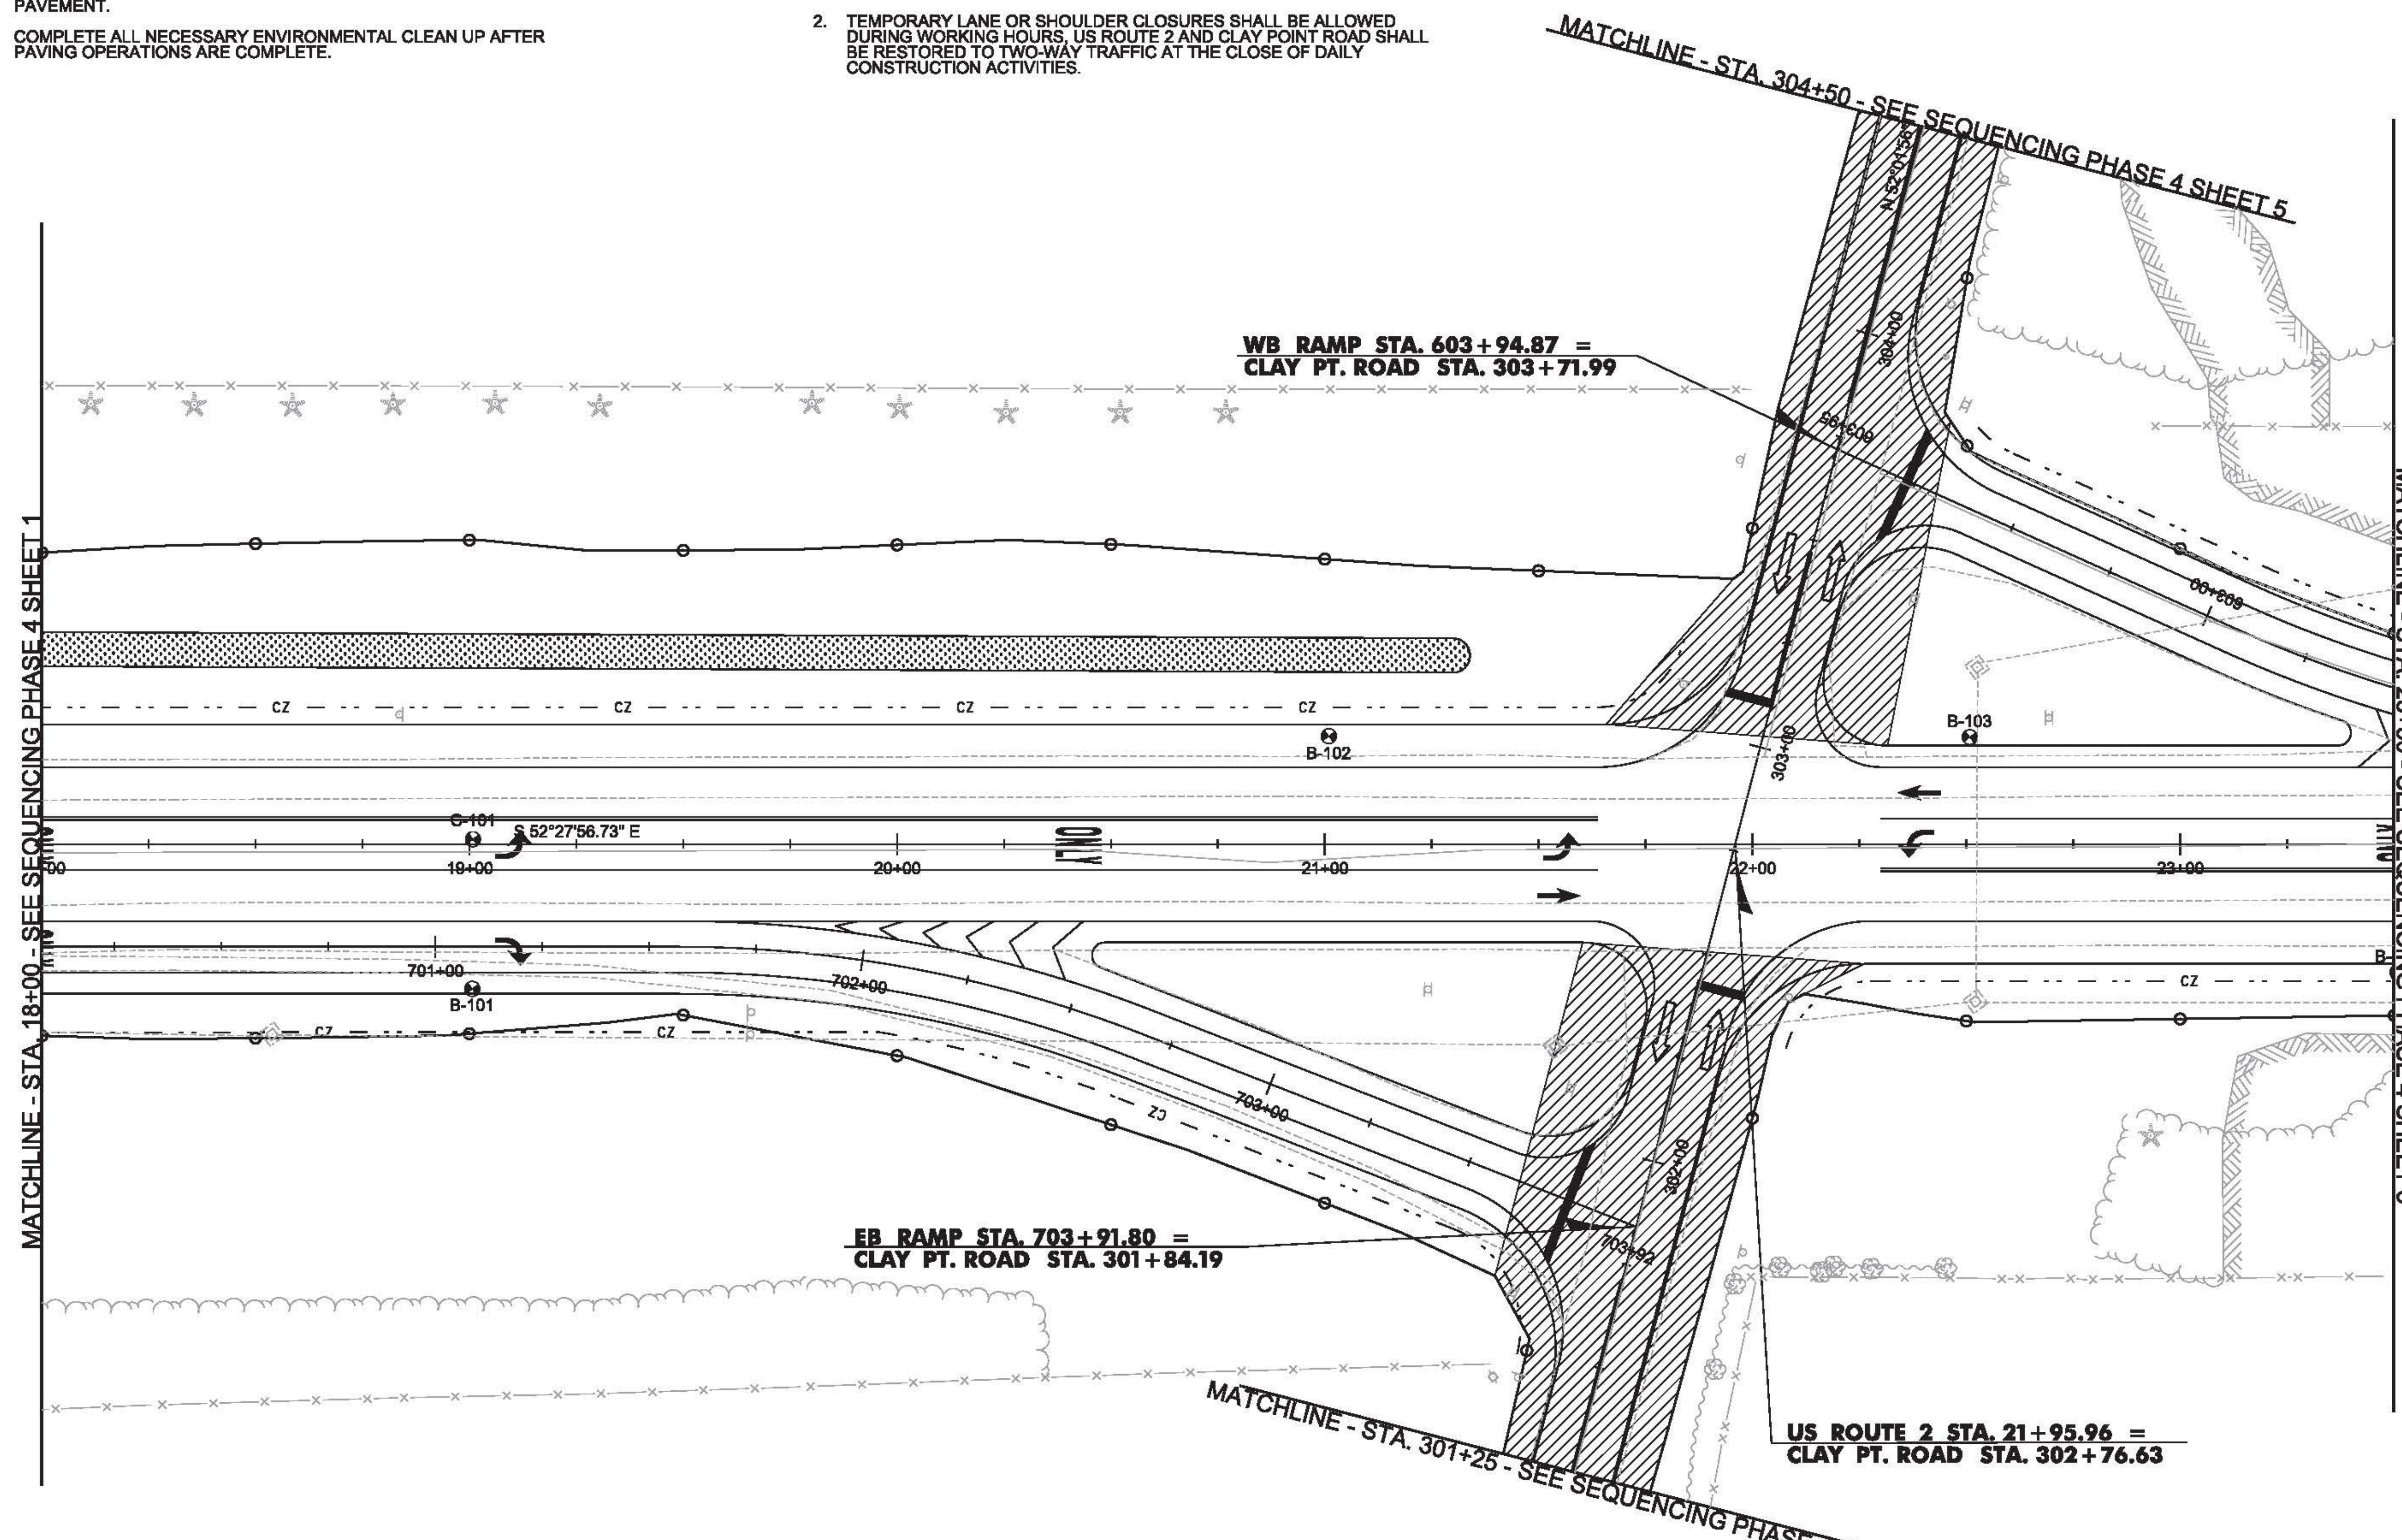


POTENTIAL ACTIVITIES ASSOCIATED WITH CONSTRUCTION PHASING

NOTES:

1. COLD PLANE CLAY POINT ROAD IN PREPERATION FOR 2 INCH OVERLAY OF NEW SUPERPAVE BITUMINOUS CONCRETE PAVEMENT.
2. COMPLETE ALL NECESSARY ENVIRONMENTAL CLEAN UP AFTER PAVING OPERATIONS ARE COMPLETE.

1. FOR TRAFFIC CONTROL GENERAL NOTES, SEE TRAFFIC CONTROL GENERAL NOTES AND DETAIL SHEET.
2. TEMPORARY LANE OR SHOULDER CLOSURES SHALL BE ALLOWED DURING WORKING HOURS, US ROUTE 2 AND CLAY POINT ROAD SHALL BE RESTORED TO TWO-WAY TRAFFIC AT THE CLOSE OF DAILY CONSTRUCTION ACTIVITIES.

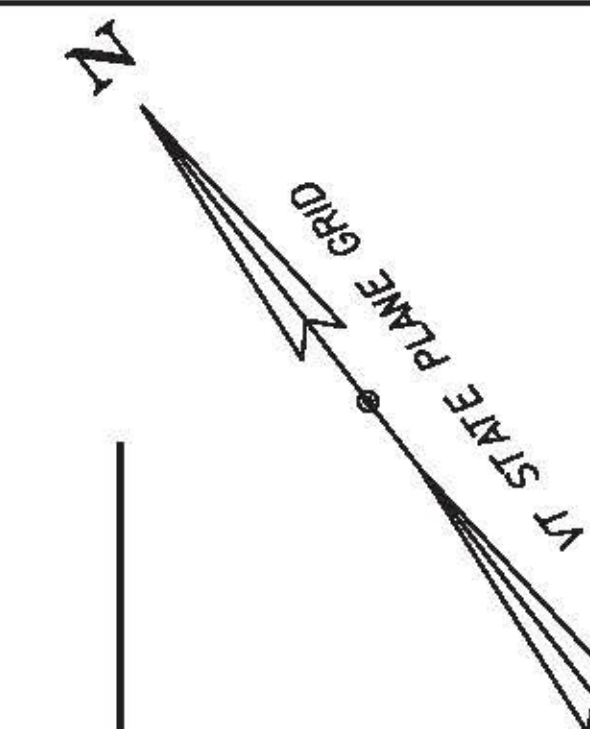


MATCHLINE - STA. 18+00 - SEE SEQUENCING PHASE 4 SHEET 1

MATCHLINE - STA. 23+50 - SEE SEQUENCING PHASE 4 SHEET 3

MATCHLINE - STA. 304+50 - SEE SEQUENCING PHASE 4 SHEET 5

MATCHLINE - STA. 301+25 - SEE SEQUENCING PHASE 4 SHEET 5

LEGEND	
	CONSTRUCTION AREA
	REFLECTORIZED PLASTIC DRUM
	FLOW OF TRAFFIC

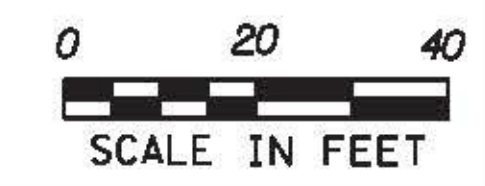

PROJECT NAME: COLCHESTER	PLOT DATE: 12/15/2015
PROJECT NUMBER: HES 028-(K28)	DRAWN BY: M. BOGACZYK
FILE NAME: i13b028+cp.dgn	CHECKED BY: M. LACROIX
DESIGNED BY: M. BOGACZYK	CONSTRUCTION SEQUENCING PHASE 4 SHEET 2 SHEET 88 OF 91