


ACCEPTED

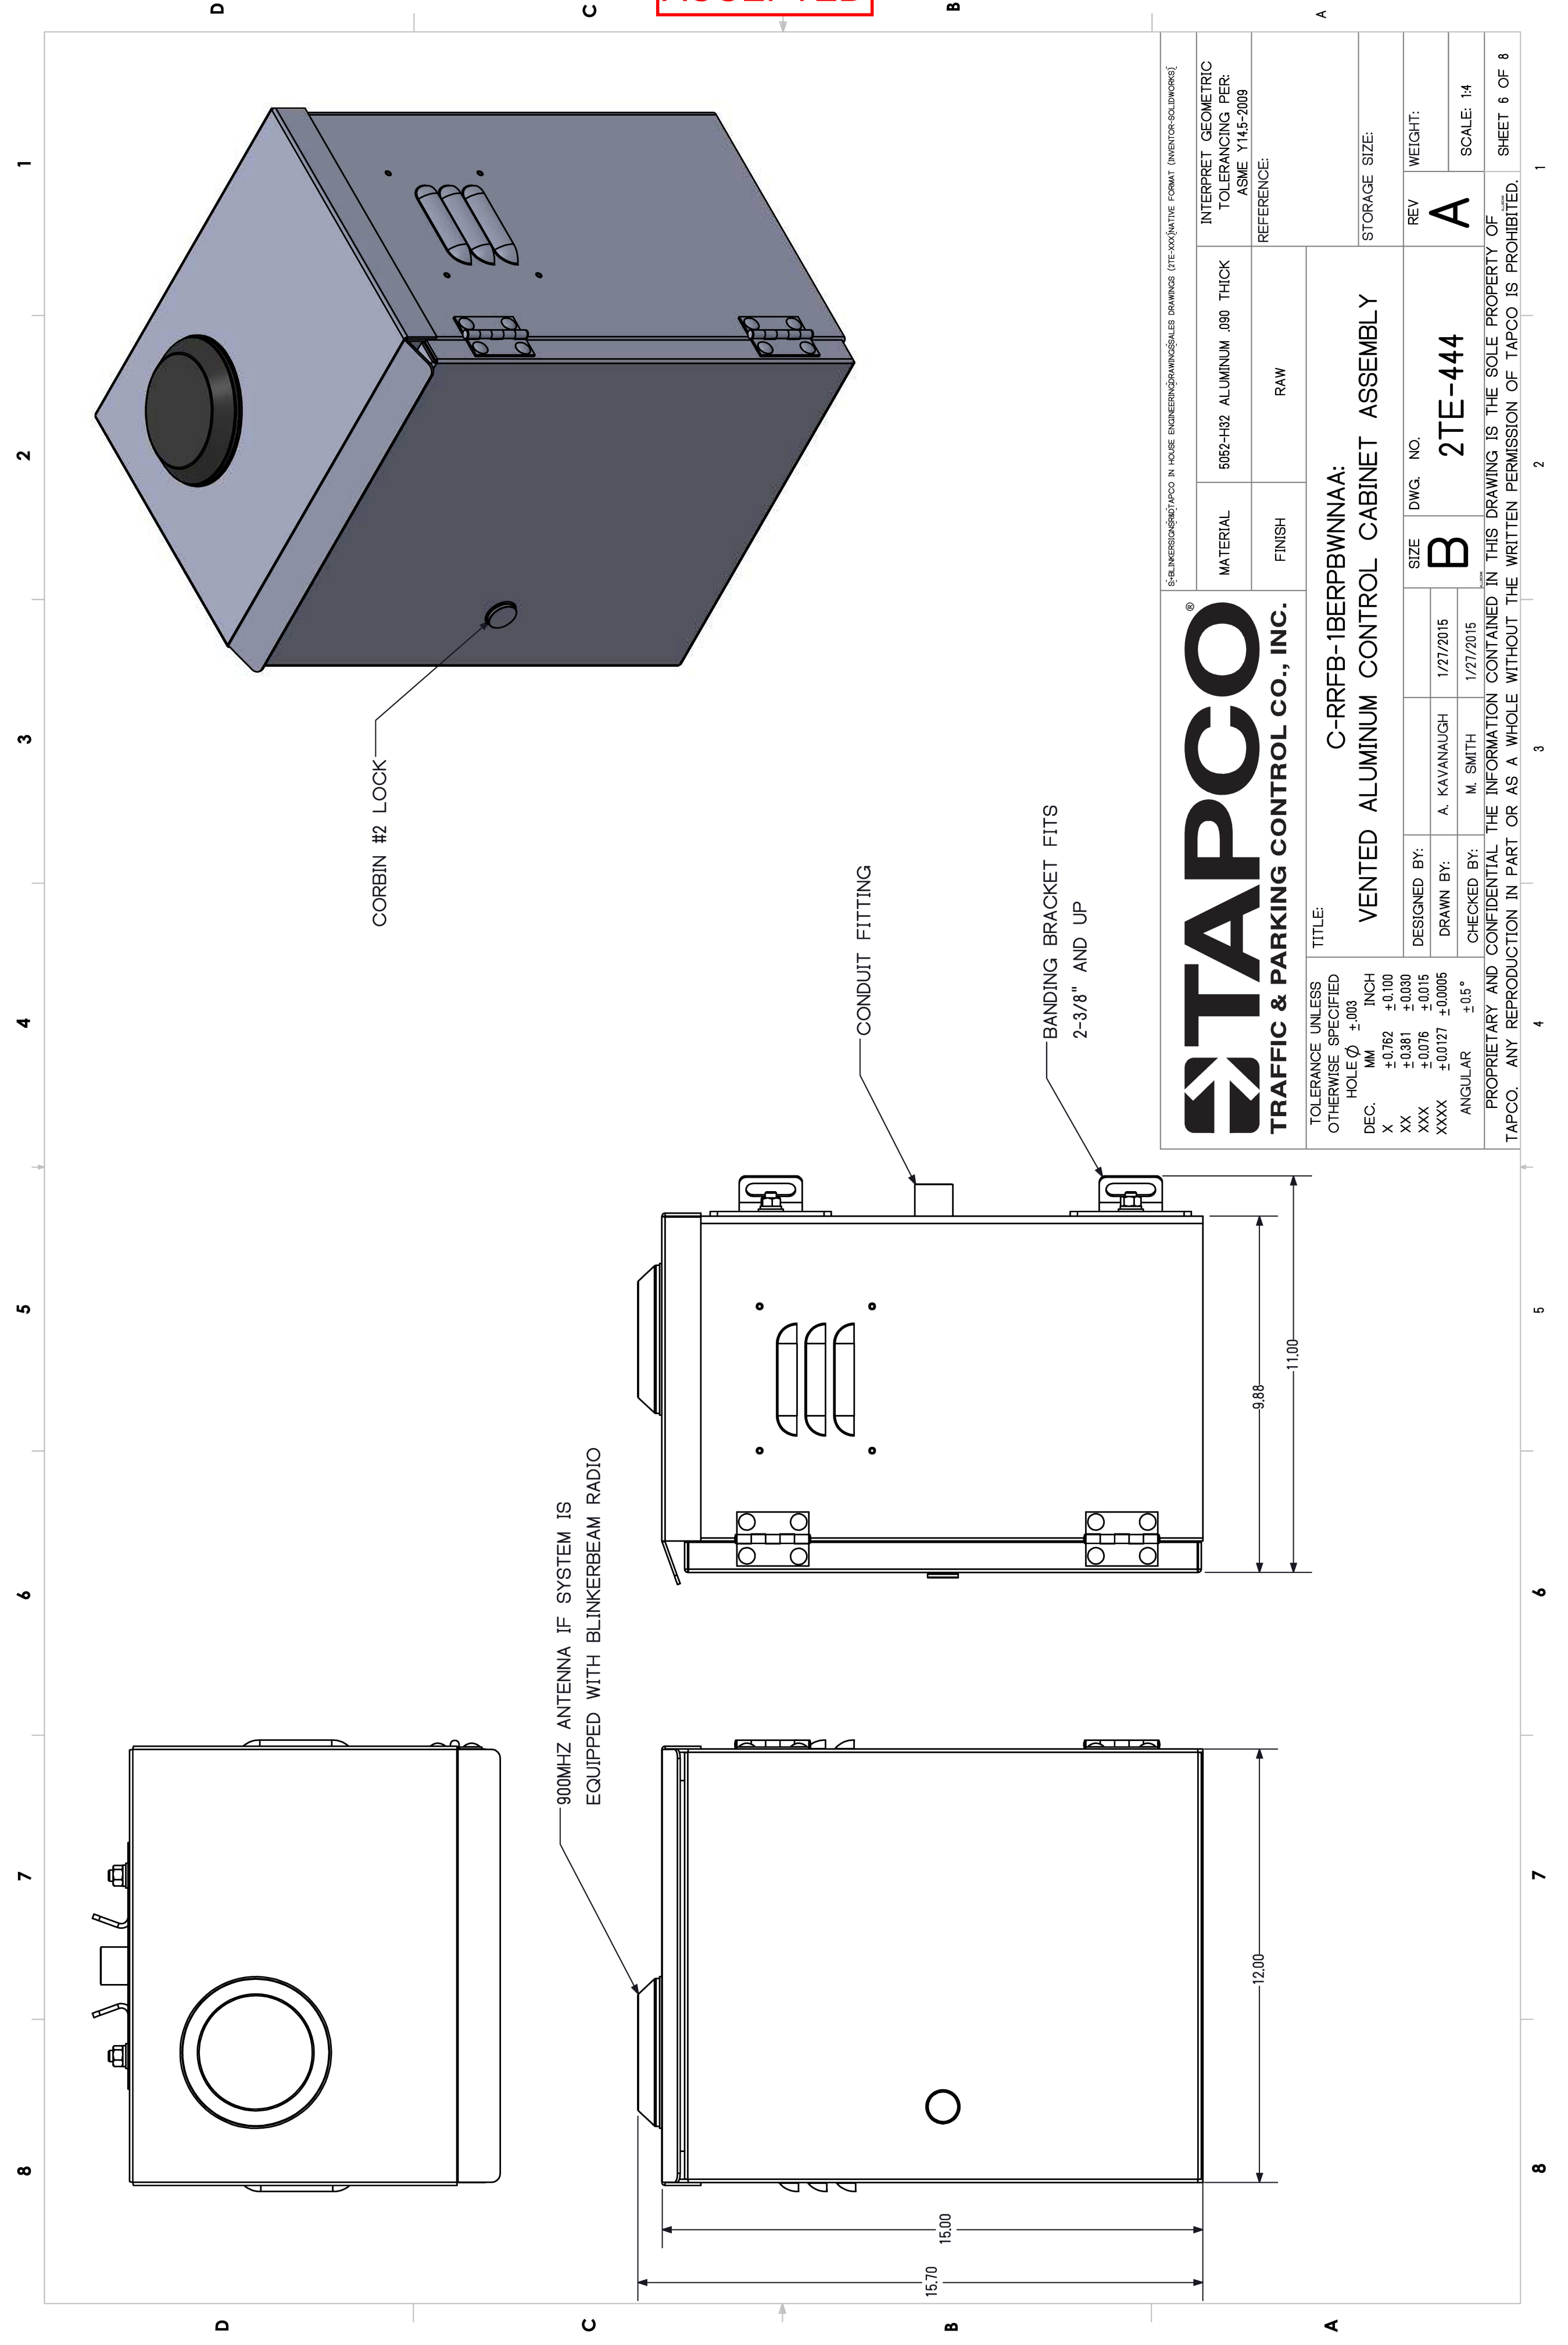

TITLE: C-RRFB-1BERPBWNNAA:  
VENTED ALUMINUM CONTROL CABINET ASSEMBLY

|              |              |           |
|--------------|--------------|-----------|
| DESIGNED BY: | A. KAVANAUGH | 1/27/2015 |
| DRAWN BY:    | M. SMITH     | 1/27/2015 |
| CHECKED BY:  |              |           |
| ANGULAR      | ±0.5°        |           |
| DEC.         | MM           | INCH      |
| X            | ±0.162       | ±0.100    |
| XX           | ±0.381       | ±0.030    |
| XXX          | ±0.076       | ±0.015    |
| XXXX         | ±0.027       | ±0.005    |

TOLENCE UNLESS OTHERWISE SPECIFIED  
HOLE Ø ±.003

|          |                              |
|----------|------------------------------|
| MATERIAL | 5082-H32 ALUMINUM .090 THICK |
| FINISH   | RAW                          |

INTERPRET GEOMETRIC TOLERANCING PER ASME Y14.5-2009 REFERENCE:

|     |         |
|-----|---------|
| REV | WEIGHT: |
| A   |         |

STORAGE SIZE:  
SCALE: 1:4  
SHEET 6 OF 6