


STATE OF VERMONT AGENCY OF TRANSPORTATION



PROPOSED IMPROVEMENT TOWNS OF FAIR HAVEN & WEST RUTLAND COUNTY OF RUTLAND PROJECT BF MEMB(35)

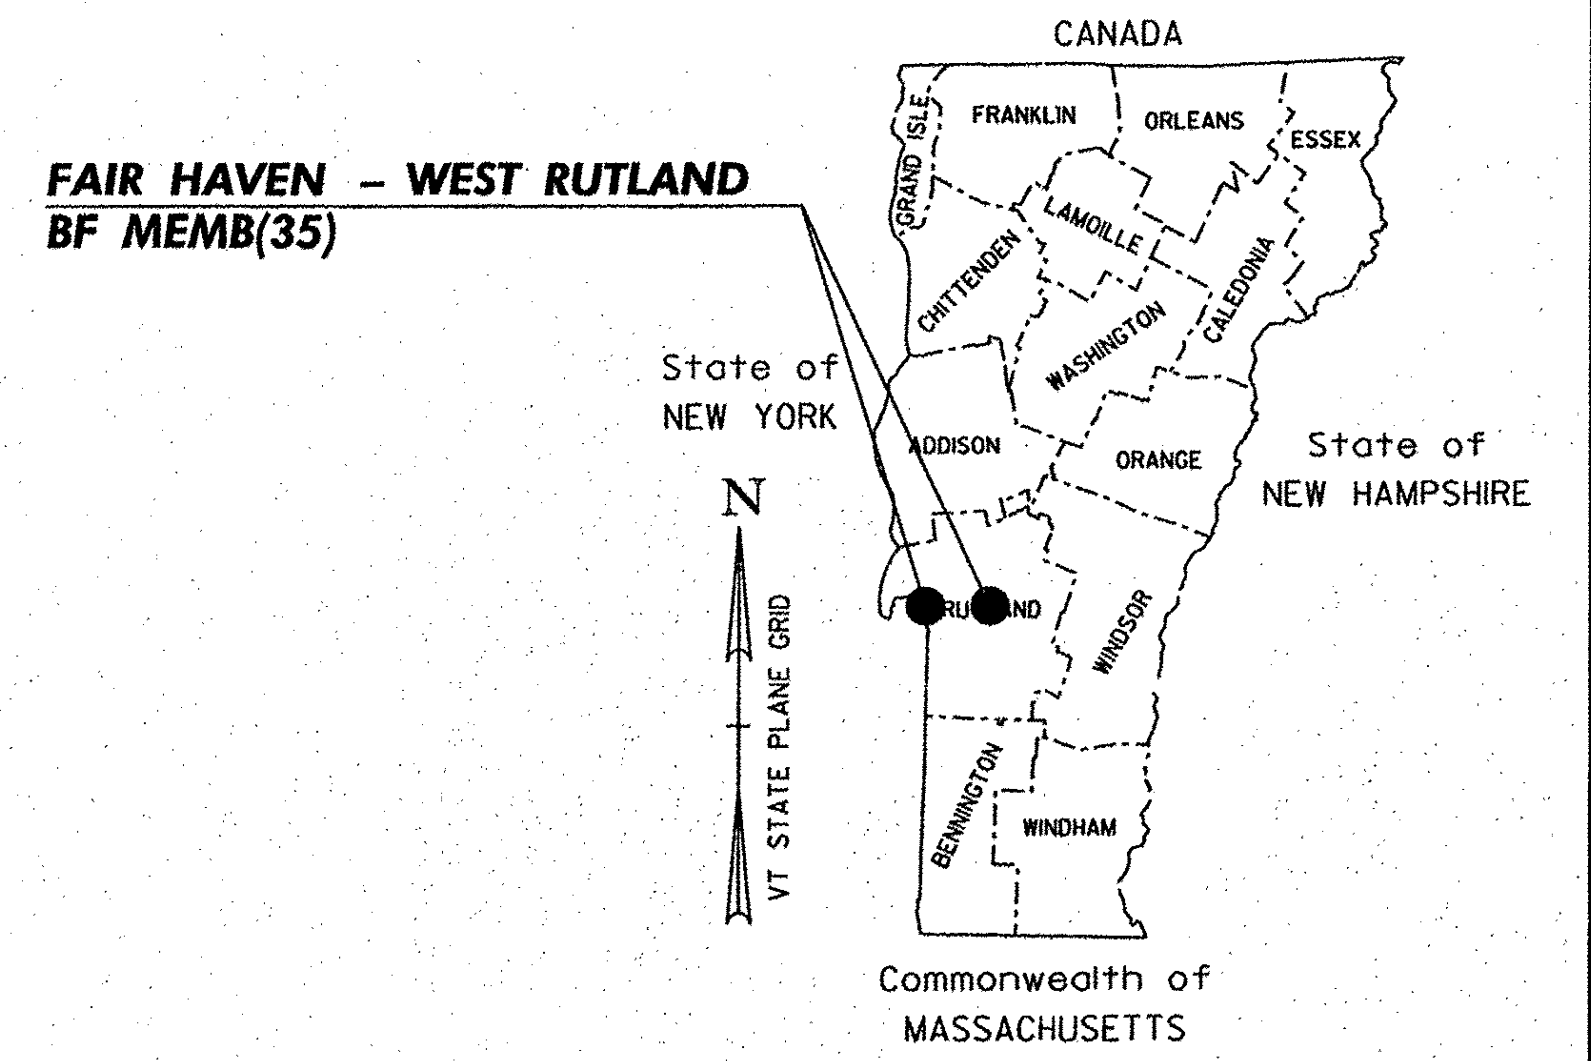

RECORD PLANS	
CONTRACTOR:	PECKHAM ROAD CORPORATION - WHITE PLAINS, NY
RESIDENT ENGINEER:	TIM POCKETTE
CONSTRUCTION BEGAN:	APRIL 13, 2015
CONSTRUCTION COMPLETE:	SEPTEMBER 28, 2015
RECORD PLANS BY:	TIM POCKETTE & AARON JAMES
I HEREBY CERTIFY THAT ALL THE CONSTRUCTION REQUIRED BY THIS SET OF DRAWINGS HAS BEEN ACCOMPLISHED AS INDICATED HEREIN.	
BY:	RESIDENT ENGINEER
DATE:	07-12-2016
NOTE: Any further information concerning final quantities, amounts or other details relative to this project may be found at Central Files in the electronic archives.	


ROUTE NO. : US4
 BRIDGE NO. : 5E, 5W, 13E, 15E
 PROJECT LOCATIONS:

FAIR HAVEN - BR 5E OVER VT 22A (MM 1.68)
 FAIR HAVEN - BR 5W OVER VT 22A (MM 1.68)
 WEST RUTLAND - BR 13E OVER CLARENDON PITTSFORD RAILROAD AND CASTLETON RIVER (MM 12.95)
 WEST RUTLAND - BR 15E OVER VT133 (MM 14.61)

PROJECT DESCRIPTION: THIS PROJECT INVOLVES REMOVING AND REPLACING THE SHEET MEMBRANE WATERPROOFING AND BITUMINOUS CONCRETE PAVEMENT ON THE BRIDGE AND ITS APPROACHES ALONG WITH MINOR RELATED WORK.

LENGTH OF STRUCTURES:

BR 5E	191.38'
BR 5W	203.49'
BR 13E	410.00'
BR 15E	96.48'
TOTAL LENGTH OF STRUCTURES:	901.35'

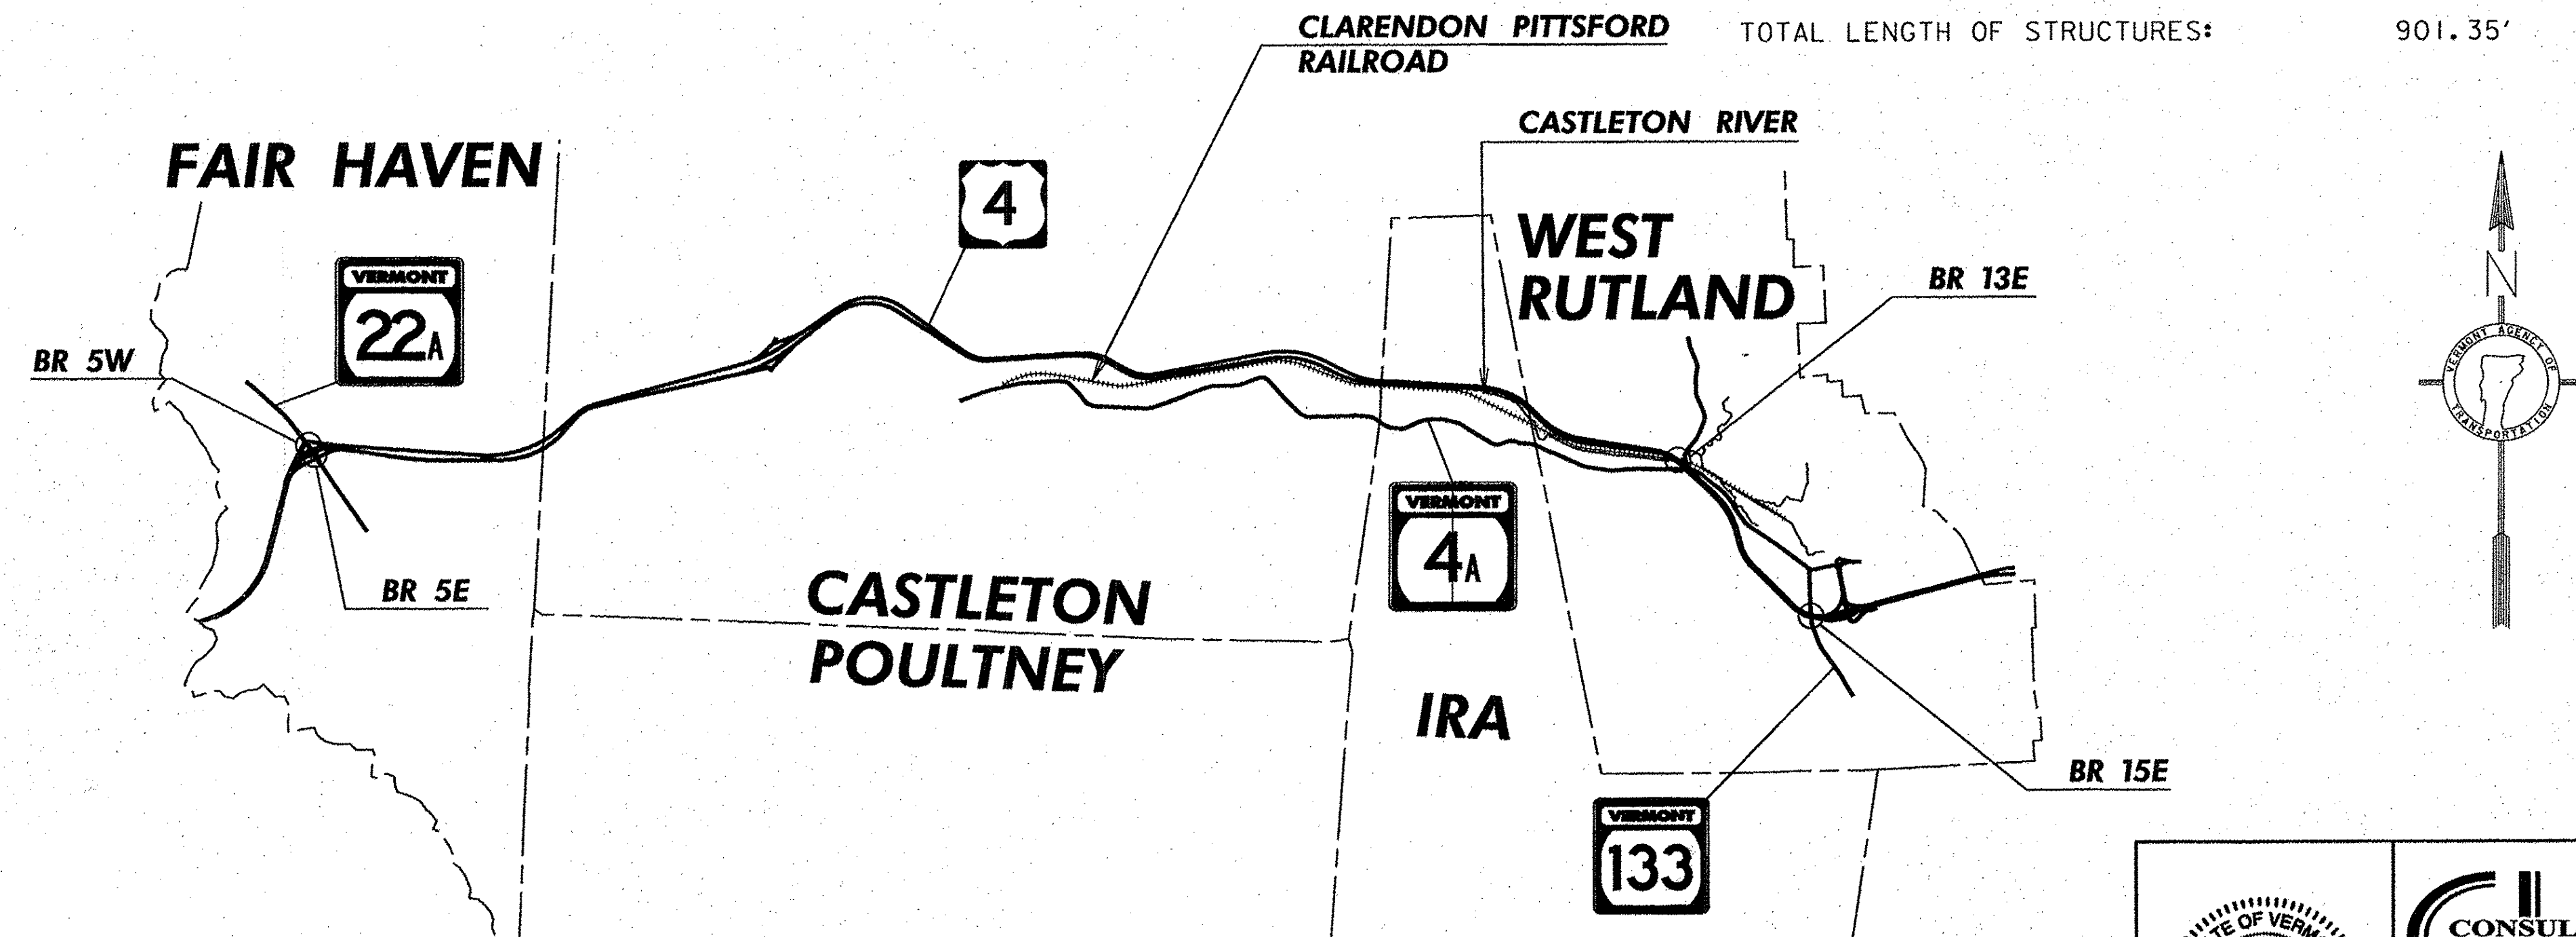

CONSTRUCTION IS TO BE CARRIED ON IN ACCORDANCE WITH THESE PLANS AND THE STANDARD SPECIFICATIONS FOR CONSTRUCTION DATED 2011, AS APPROVED BY THE FEDERAL HIGHWAY ADMINISTRATION ON JULY 20, 2011 FOR USE ON THIS PROJECT, INCLUDING ALL SUBSEQUENT REVISIONS AND SUCH REVISED SPECIFICATIONS AND SPECIAL PROVISIONS AS ARE INCORPORATED IN THESE PLANS.

QUALITY ASSURANCE PROGRAM : LEVEL I	
SURVEYED BY : XX	
SURVEYED DATE : XX	
DATUM	
VERTICAL	XX
HORIZONTAL	XX

	<p>540 Commercial Street Manchester, NH 03101 (603) 668-8223 www.cldengineers.com</p>	DIRECTOR OF PROJECT DELIVERY
		APPROVED DATE 12/16/2014
		PROJECT MANAGER : DOUGLAS BONNEAU, P.E.
		PROJECT NAME : FAIR HAVEN-WEST RUTLAND
		PROJECT NUMBER : BF MEMB (35)
		SHEET 1 OF 44 SHEETS