



PLAN  
Scale: 1/4" = 1'-0"


\*NOTE:  
Elevations are bottom  
of concrete girder

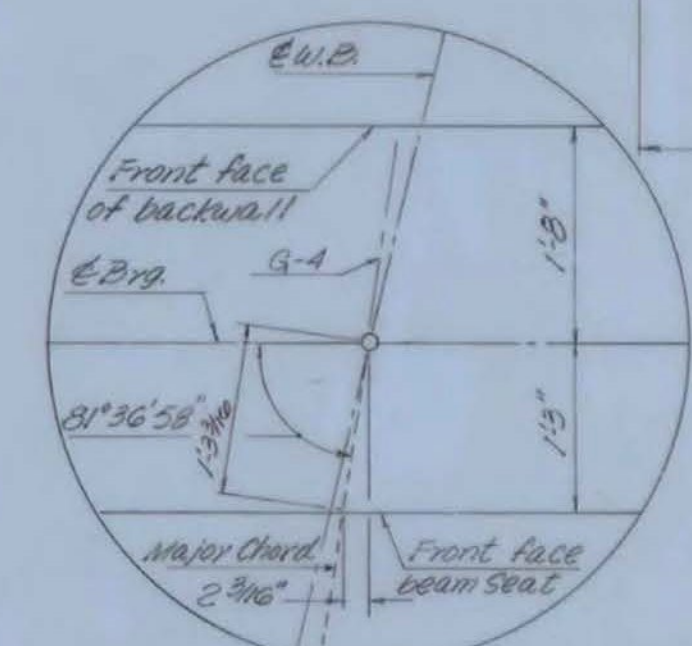


DETAIL A  
No Scale

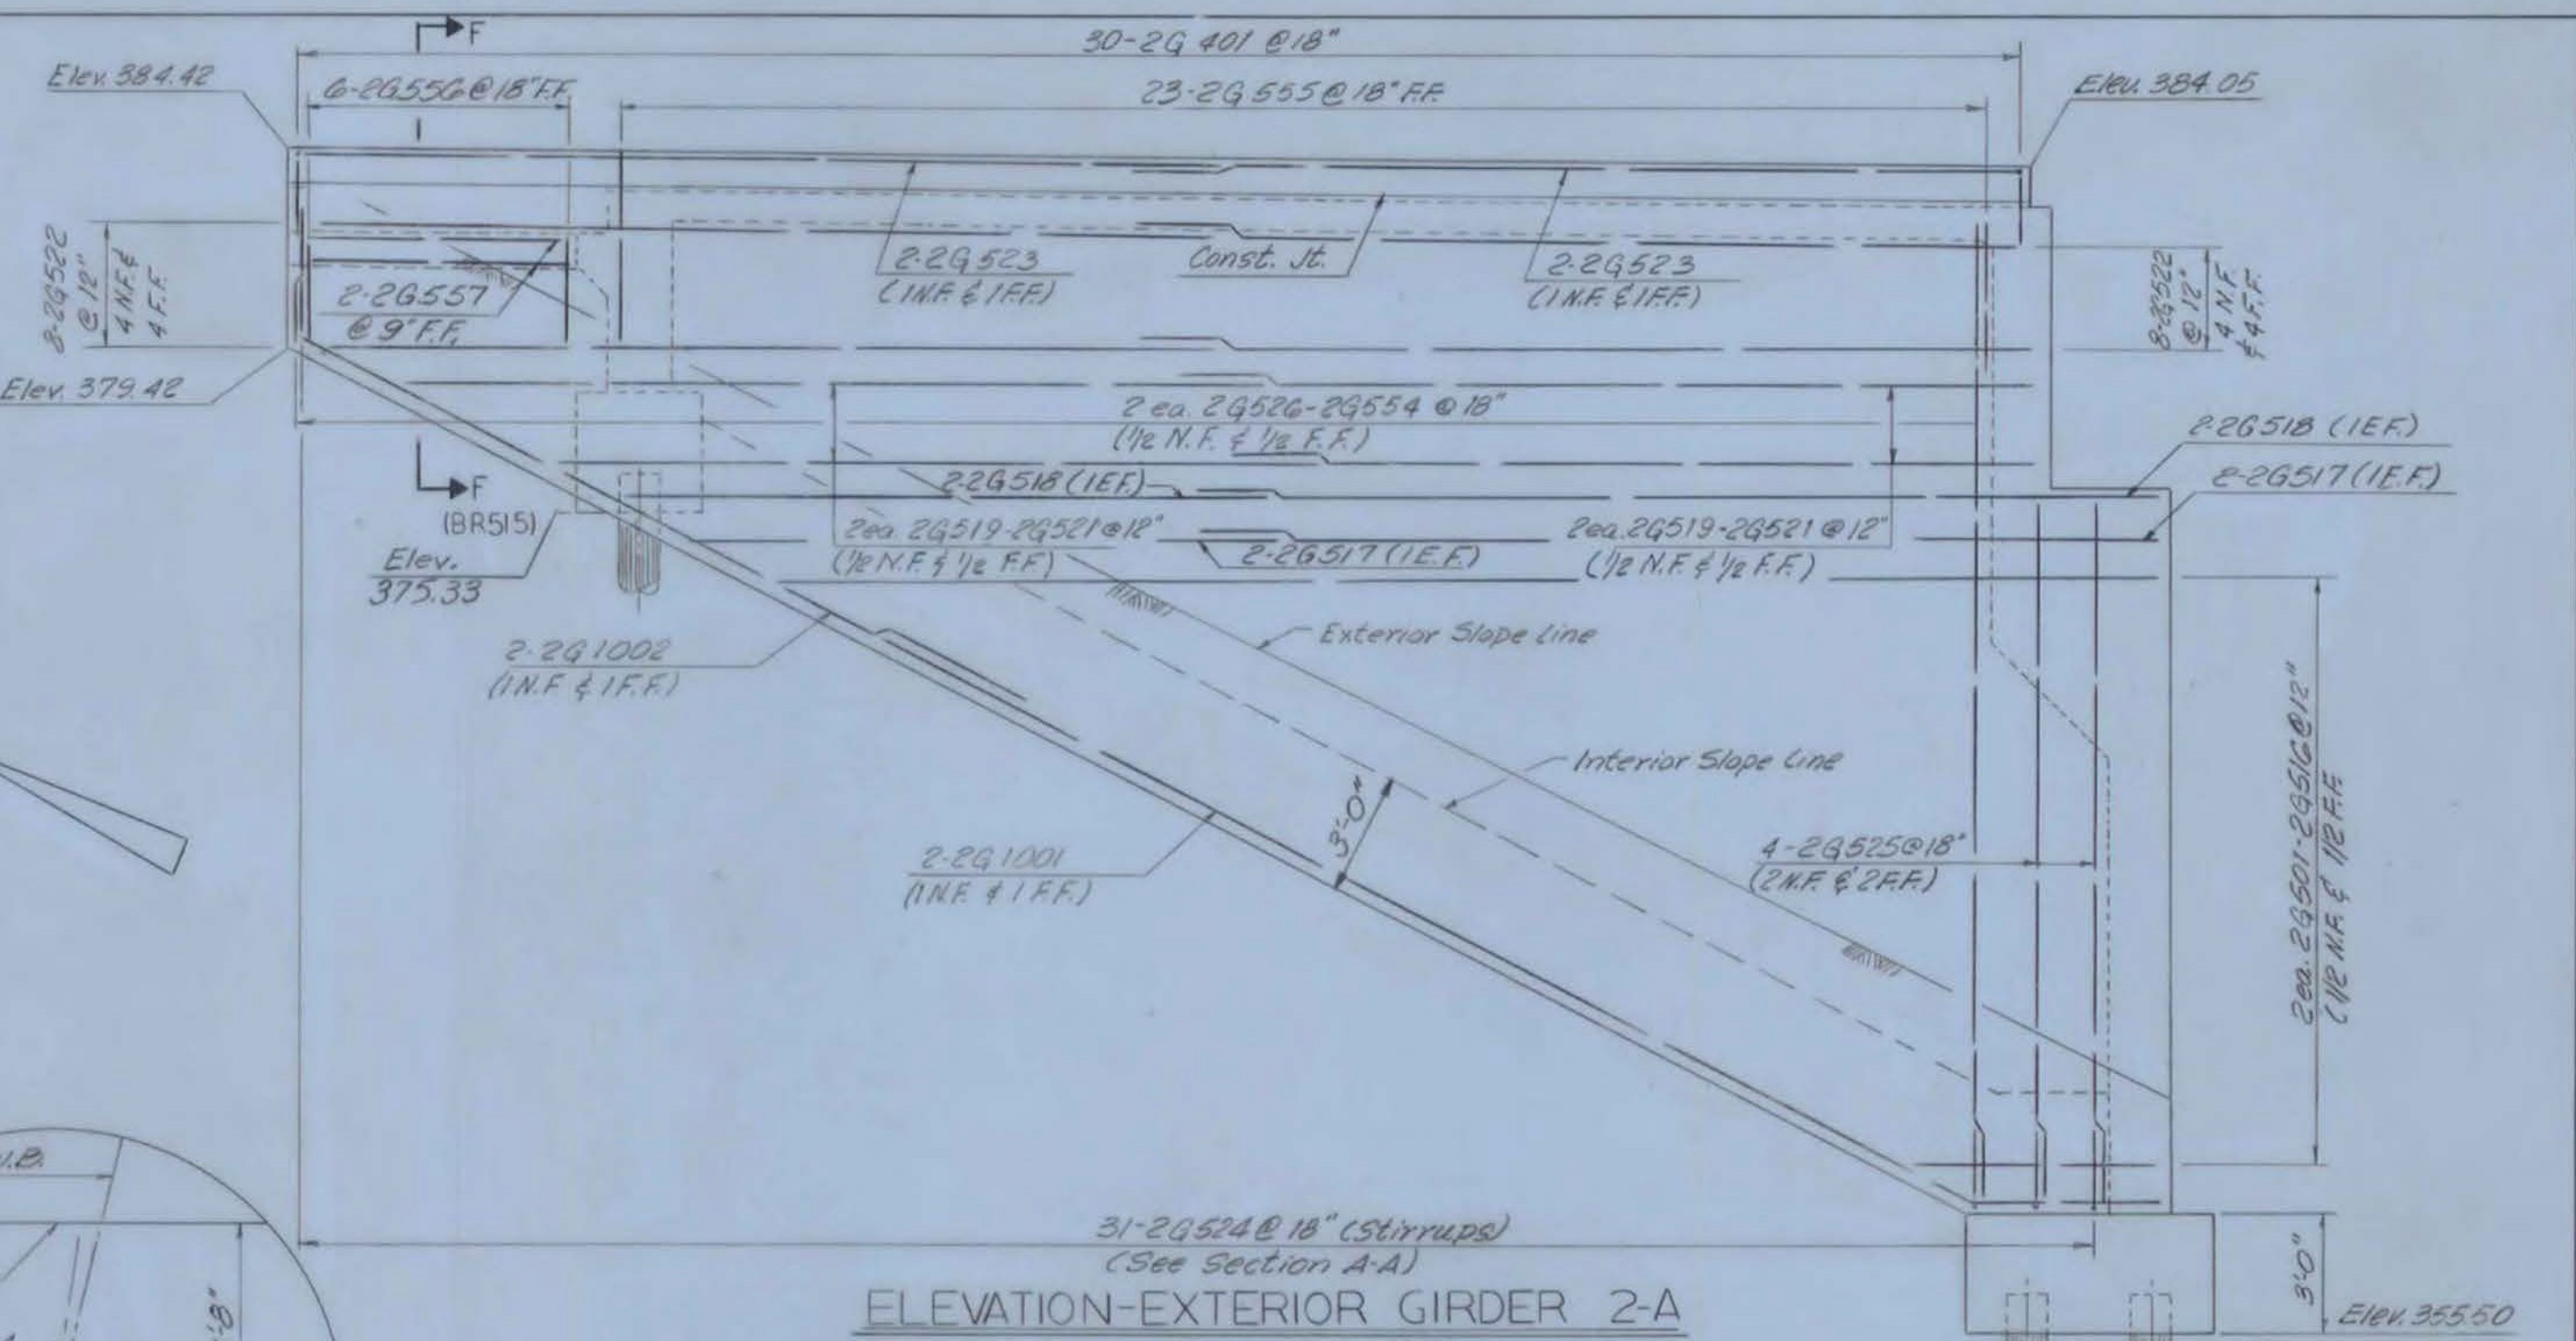

ELEVATION-EXTERIOR GIRDER 2-A  
Scale: 1/4" = 1'-0"

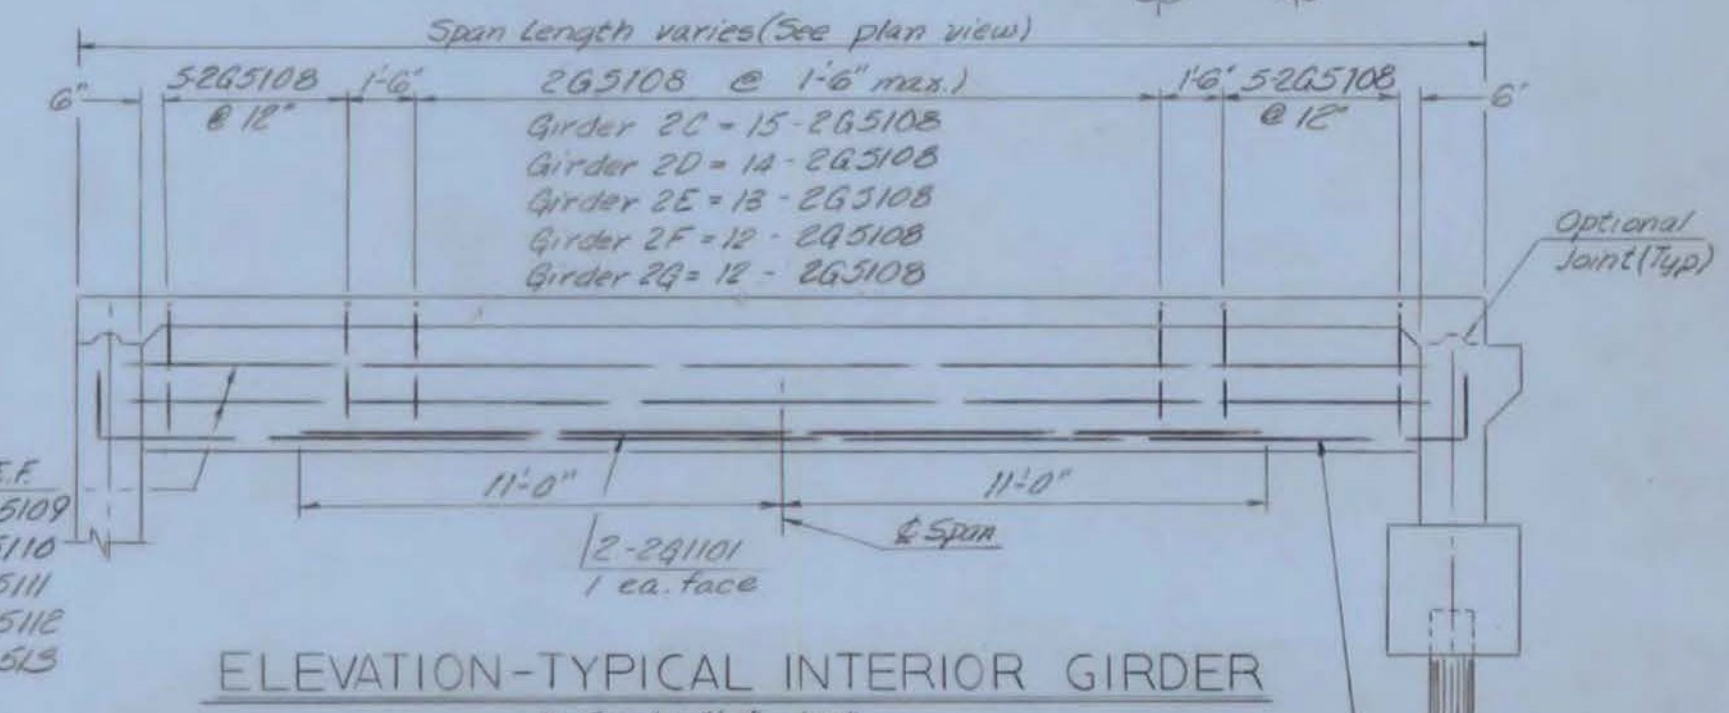


ELEVATION-TYPICAL INTERIOR GIRDER  
Scale: 1/4" = 1'-0"

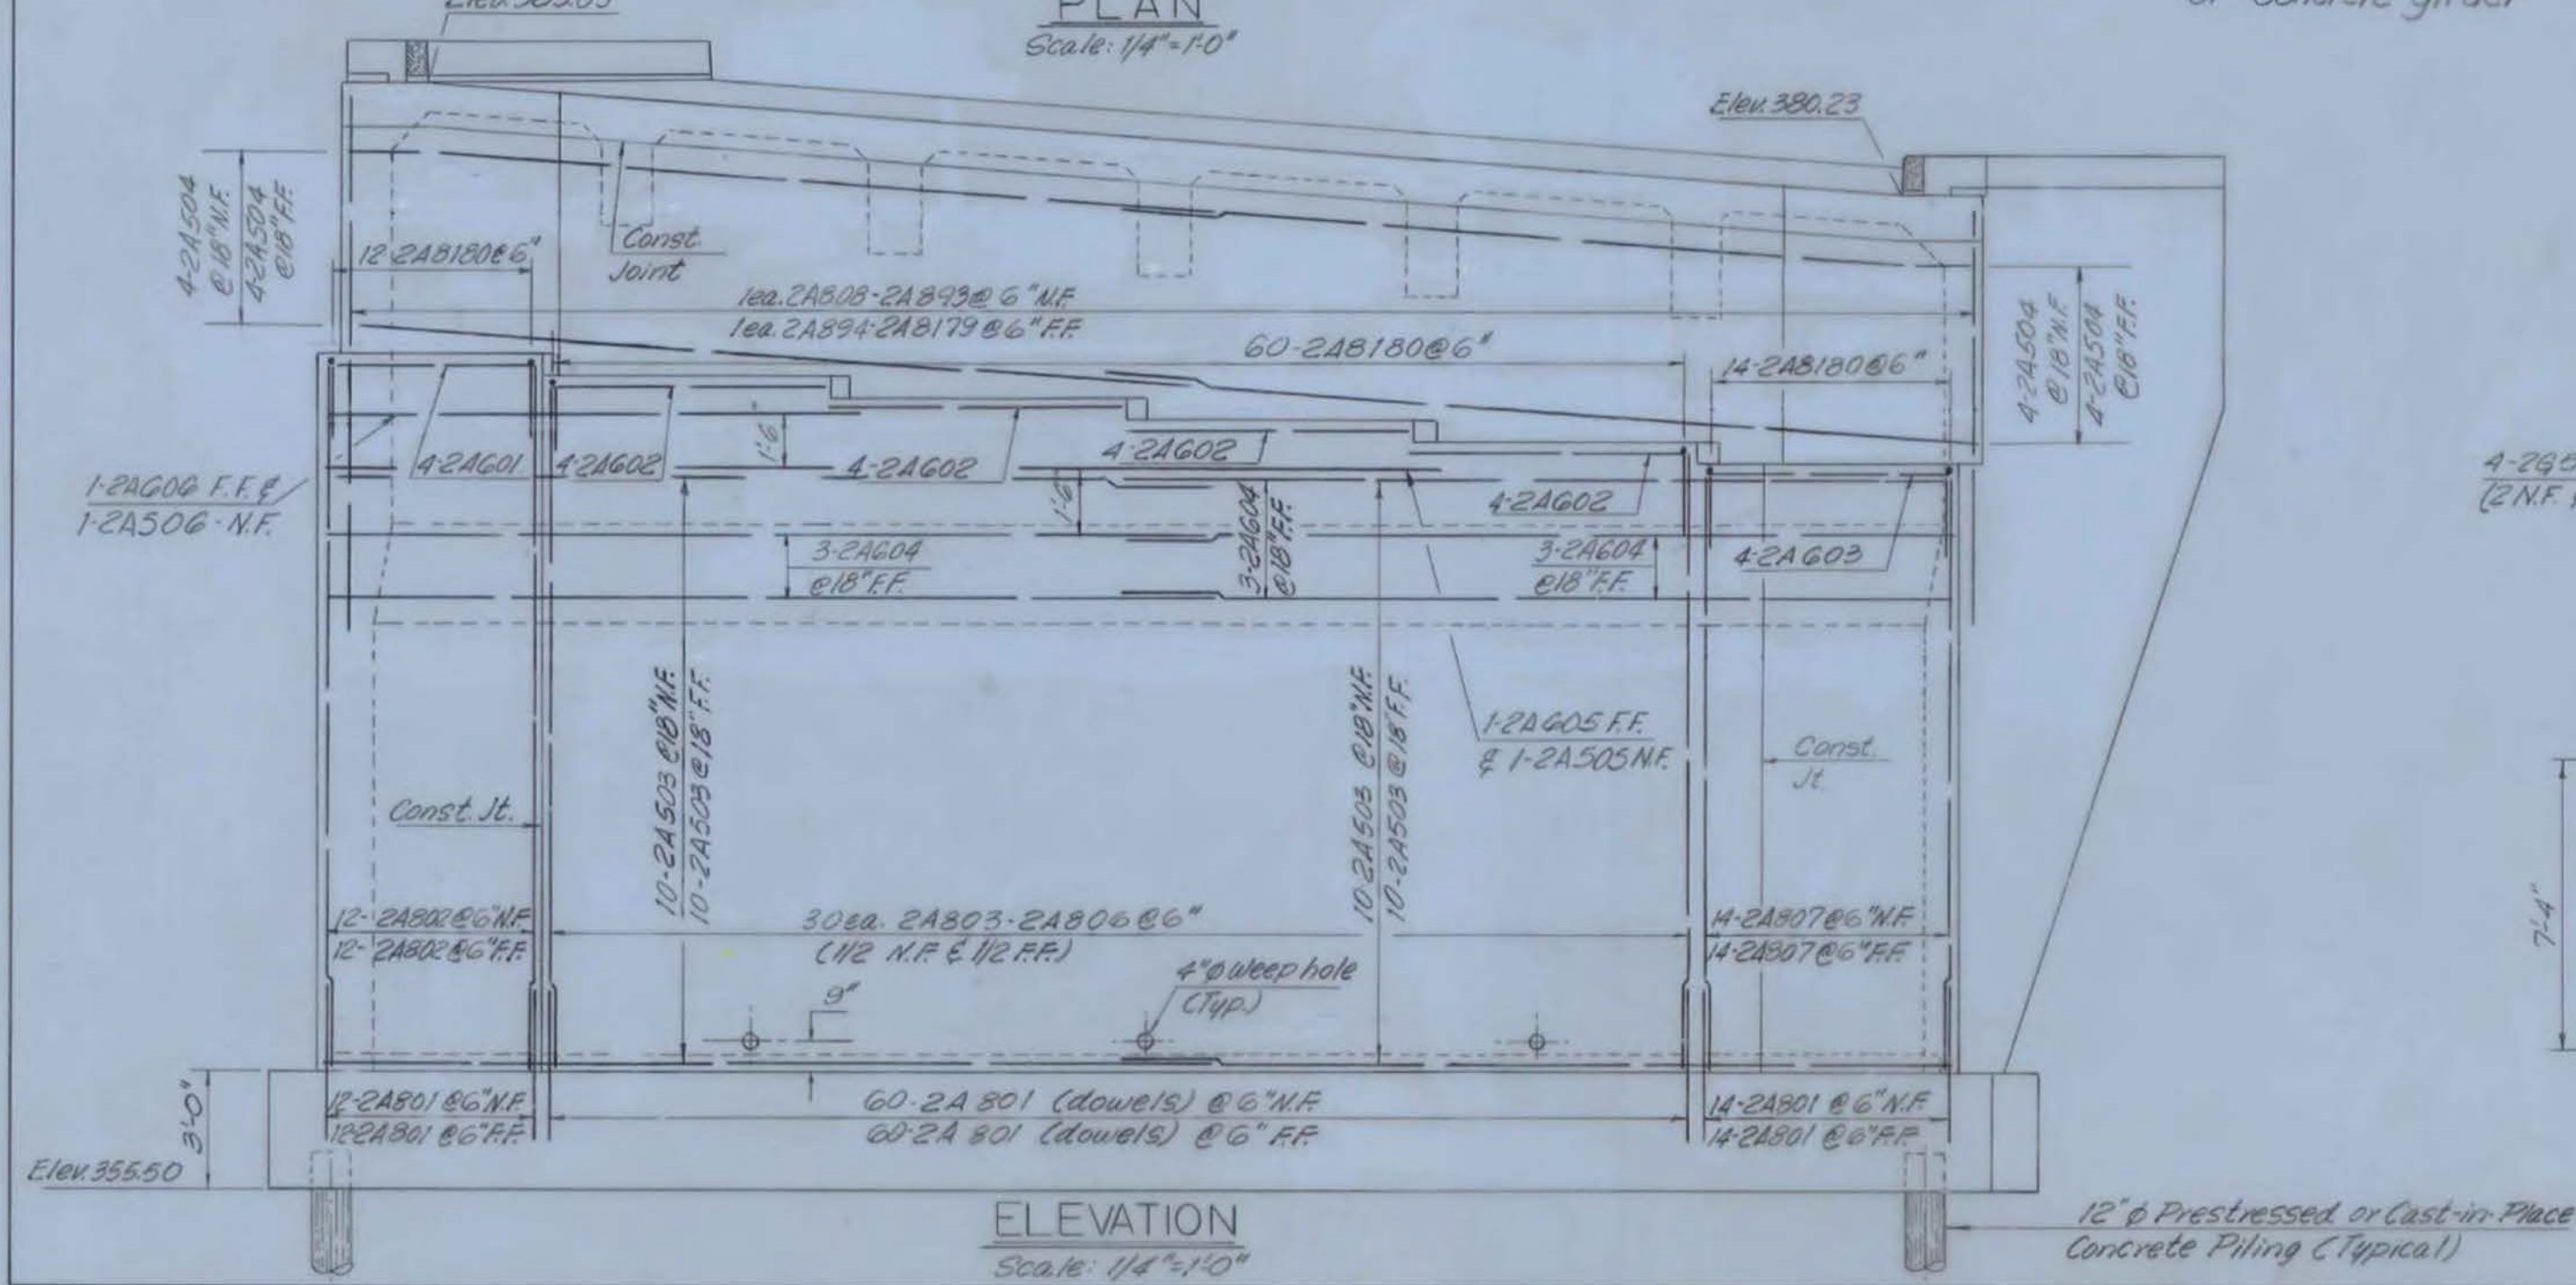

ELEVATION  
Scale: 1/4" = 1'-0"

12" @ Prestressed or Cast-in-Place  
Concrete Piling (Typical)

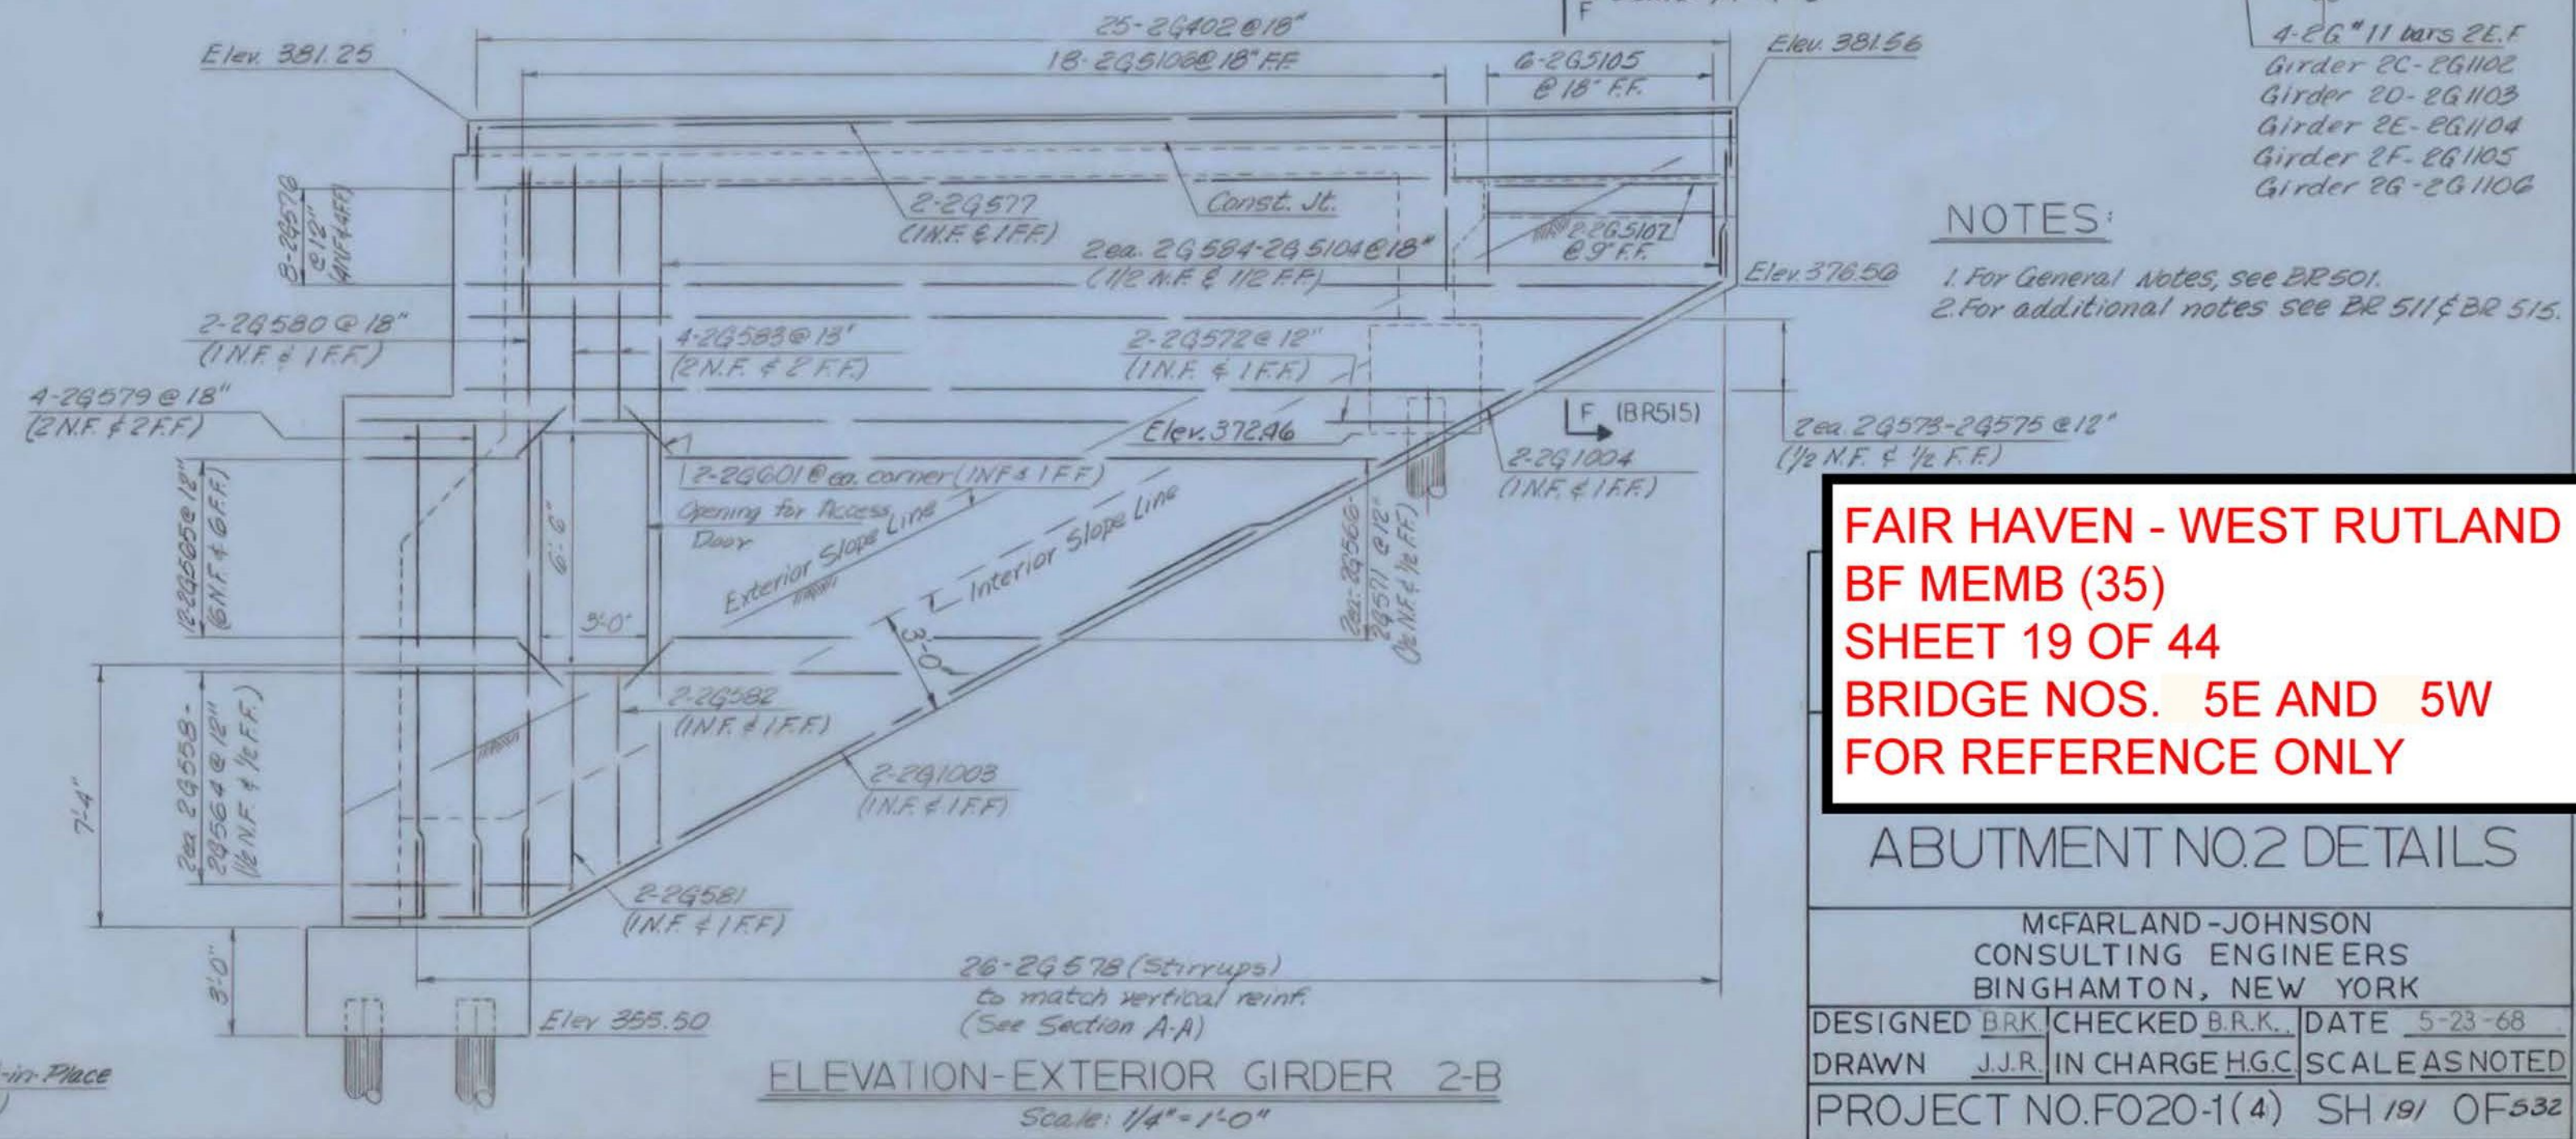

ELEVATION-EXTERIOR GIRDER 2-B  
Scale: 1/4" = 1'-0"

NOTES:  
1. For General Notes, see DE 501.  
2. For additional notes see DE 511 & DE 515.

**FAIR HAVEN - WEST RUTLAND  
BF MEMB (35)  
SHEET 19 OF 44  
BRIDGE NOS. 5E AND 5W  
FOR REFERENCE ONLY**

ABUTMENT NO.2 DETAILS

McFARLAND-JOHNSON  
CONSULTING ENGINEERS  
BINGHAMTON, NEW YORK

DESIGNED BRK CHECKED BRK DATE 5-23-68  
DRAWN J.J.R. IN CHARGE H.G.C. SCALE AS NOTED  
PROJECT NO. F020-1(4) SH 191 OF 332

CONTRACT NO. BR 512