



GENERAL NOTES
 1. ALL WORK AND MATERIALS SHALL CONFORM TO THE STATE OF VERMONT, DEPARTMENT OF HIGHWAYS, STANDARD SPECIFICATIONS FOR HIGHWAY AND BRIDGE CONSTRUCTION DATED APRIL 1964, AND THE A.A.S.H.O. SPECIFICATIONS DATED 1961. DESIGNED FOR HS 20-44 LOADING.
 2. ALL REINFORCING STEEL SHALL BE DETAILED ON THE REINFORCING STEEL SCHEDULE. ALL SPLICES SHALL BE A MINIMUM OF 40 BAR DIAMETERS.
 3. BITUMINOUS CONCRETE PAVEMENT VARIES FROM 2" AT BRIDGE END TO 3" AT ROADWAY END.

**FAIR HAVEN - WEST RUTLAND
 BF MEMB (35)
 SHEET 24 OF 44
 BRIDGE NOS. 5E AND 5W
 FOR REFERENCE ONLY**

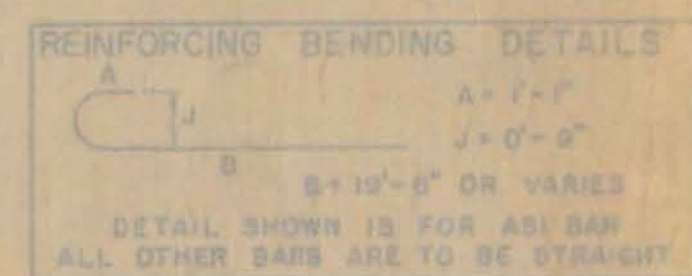

LIST OF QUANTITIES

ITEM NO.	ITEM	UNIT
318	TAR EMULSION FOR BRIDGE FLOORS	GAL.
361	BITUMINOUS CONCRETE PAVEMENT MOD. TYPE IV	TONS
372-A	JOINT SEALER - HOT Poured	L.F.
372-C	JOINT SEALER - PREFORMED, TYPE A	L.F.
401-B	CONCRETE GLASS B	CY.
402	REINFORCING STEEL	LB.

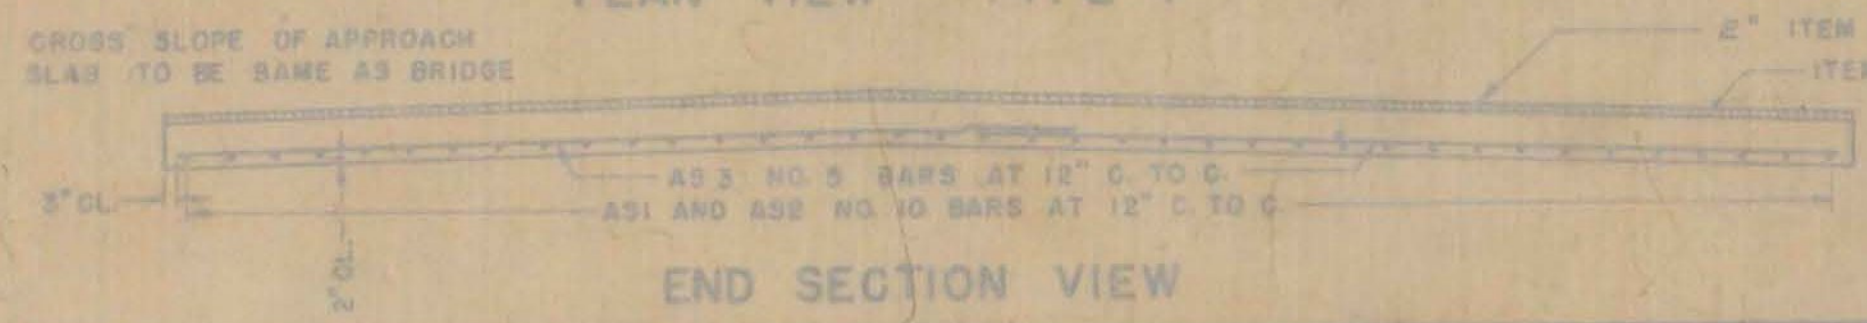

REVISIONS AND CORRECTIONS
 1. DIMENSIONS OF JOINT FOR SEALER TYPE A REVISED. 4/13/65 W.B.T.
 2. DIMENSIONS OF JOINT SEALER TYPE B REVISED. 6/23/65 W.B.T.
 3. JOINT BETWEEN CURB AND SLAB REVISED, BITUMINOUS CONCRETE REVISED TO 2". QUANTITY TOTALS REMOVED. 12/7/65. W.B.T.

DRAWN BY: *W.B.T. Jan 1964*
 TRACED BY: *W.B.T. Jan 1964*
 CHECKED BY: *W.B.T. Feb 1965*

RECOMMENDED FOR APPROVAL: *[Signature]* DATE *2/16/65*
 RECOMMENDED FOR APPROVAL: *[Signature]* DATE *2/16/65*
 APPROVED BY: *[Signature]* DATE *2/16/65*

DETAILS OF APPROACH SLAB FOR 3'6"-8" FOOT BRIDGE TO BE USED FOR BRIDGE AT STATION 1077+50 W.B. LOCATION U.S. RTE. 4 RELOCATION OVER VT. 22A RELOC. (APPROACH SLAB NO.1)

STATE OF VERMONT DEPARTMENT OF HIGHWAYS STANDARD STRUCTURE SB-AS-65

PROJECT FAIR HAVEN
 TOWN OF FAIR HAVEN
 ROUTE NO. U.S.4 STA. WB 1077+50 EB 1076+77
 U.S. RTE. 4 RELOCATION OVER VT. 22A RELOC.
 APPROACH SLAB NO.1
 NOT TO SCALE
 IN CHARGE H.G.C.
 DESIGNED BY A.M.D. CHECKED BY R.E.C.
 PROJECT NO. FO20-1 (8)
 SHEET 106 OF 255
 CONTRACT NO. BR 517