



PLAN  
Scale 1/4" = 1'

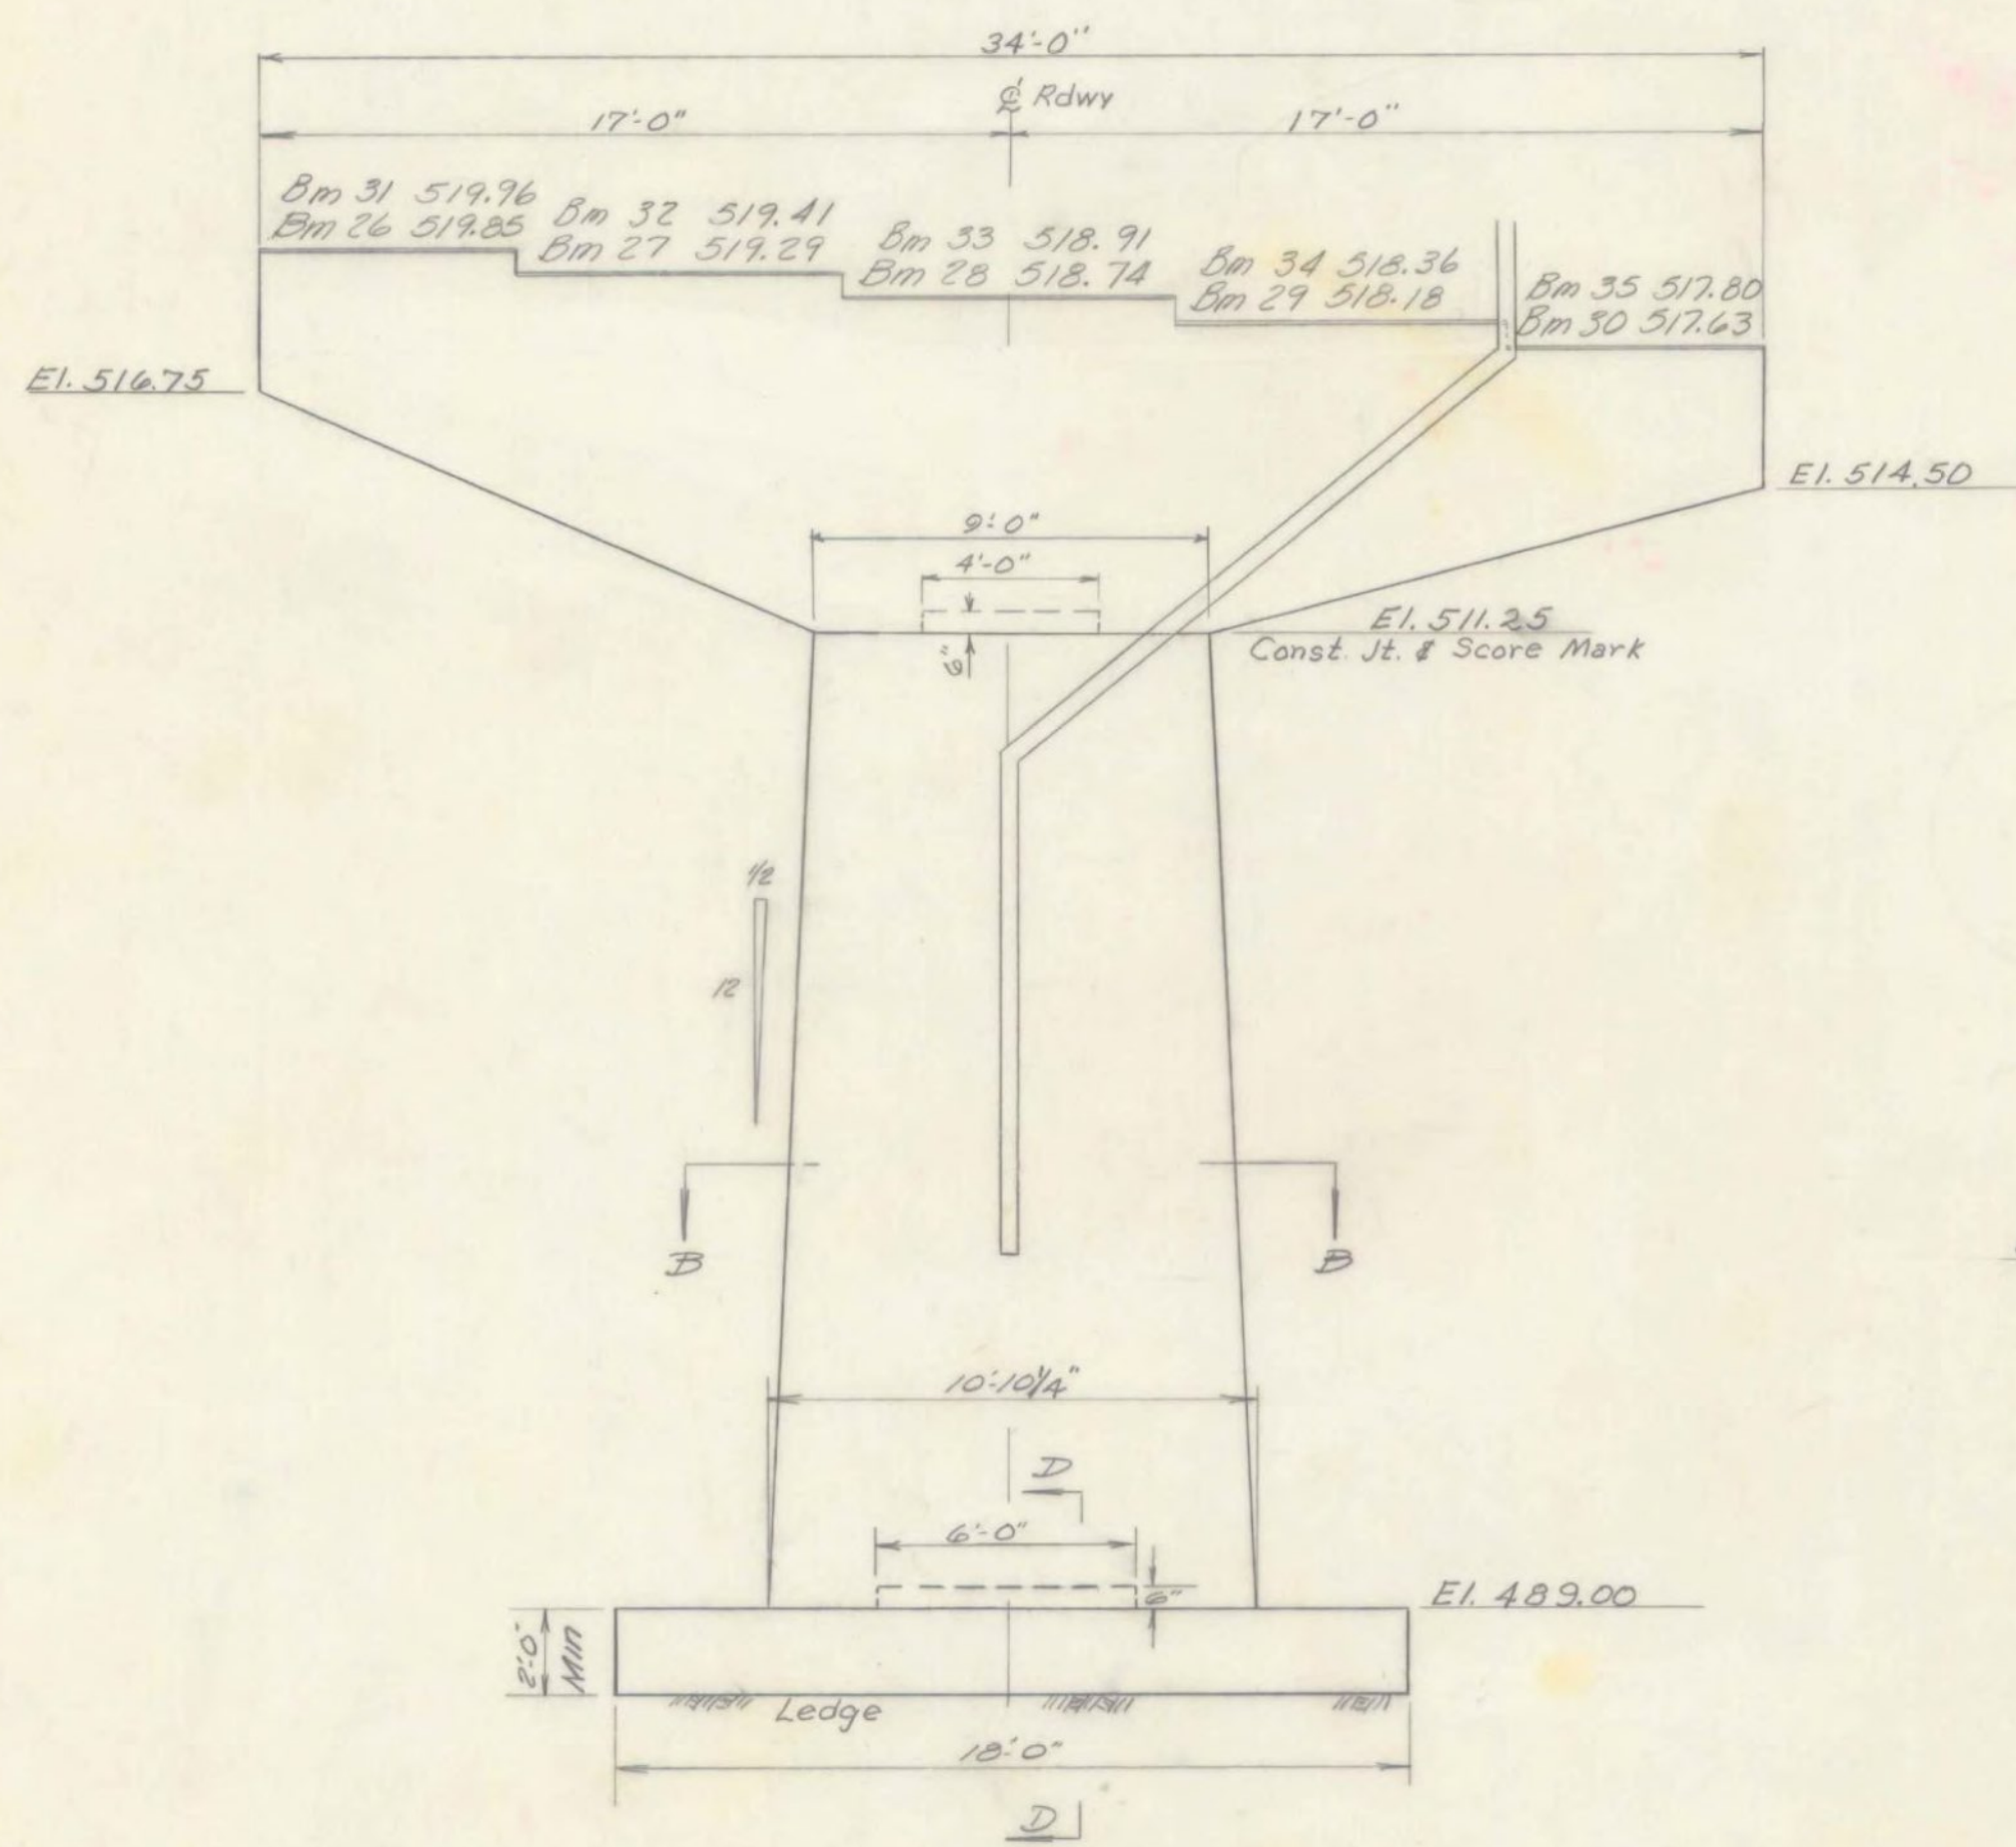


ELEVATION  
Scale 1/4" = 1'

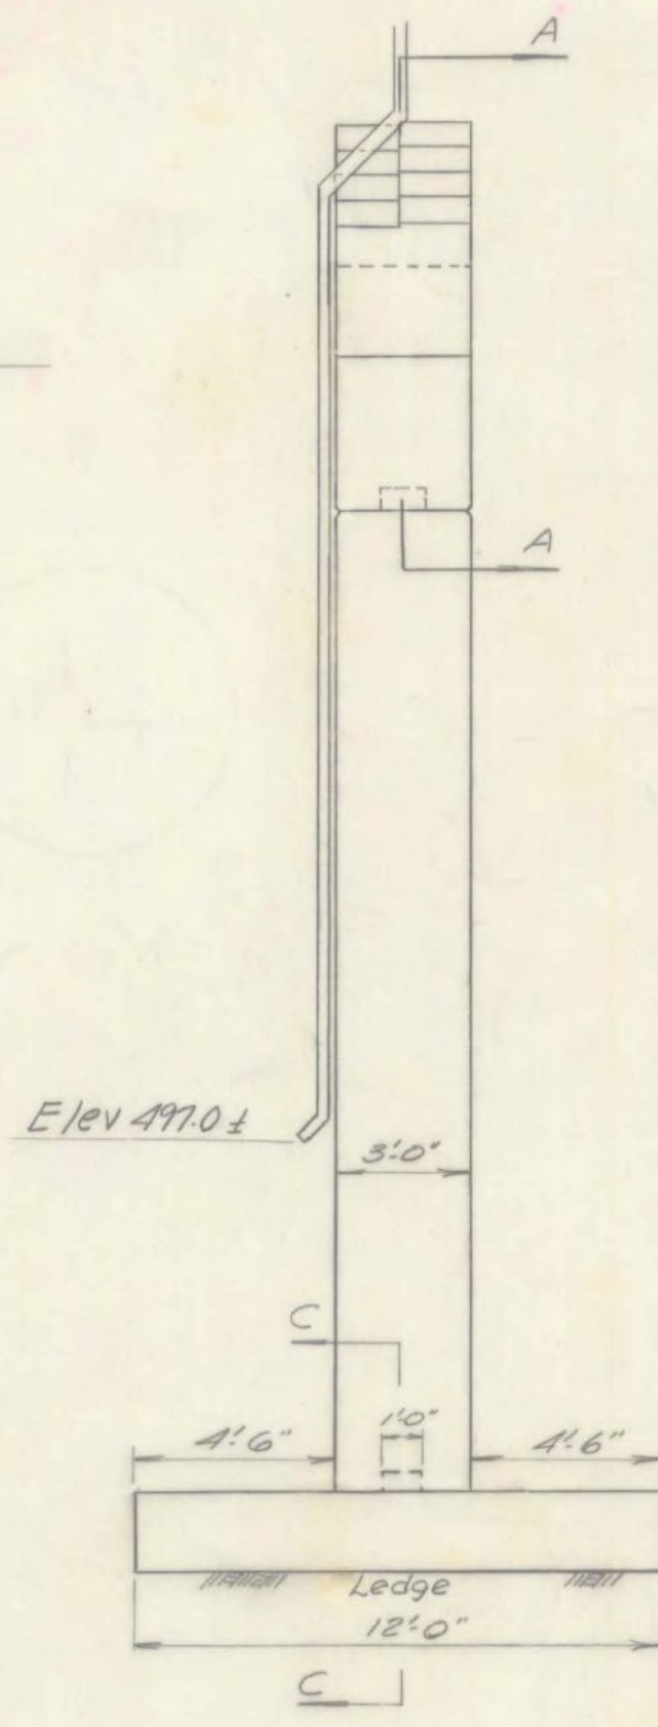


SIDE  
Scale 1/4" = 1'

PIER 5

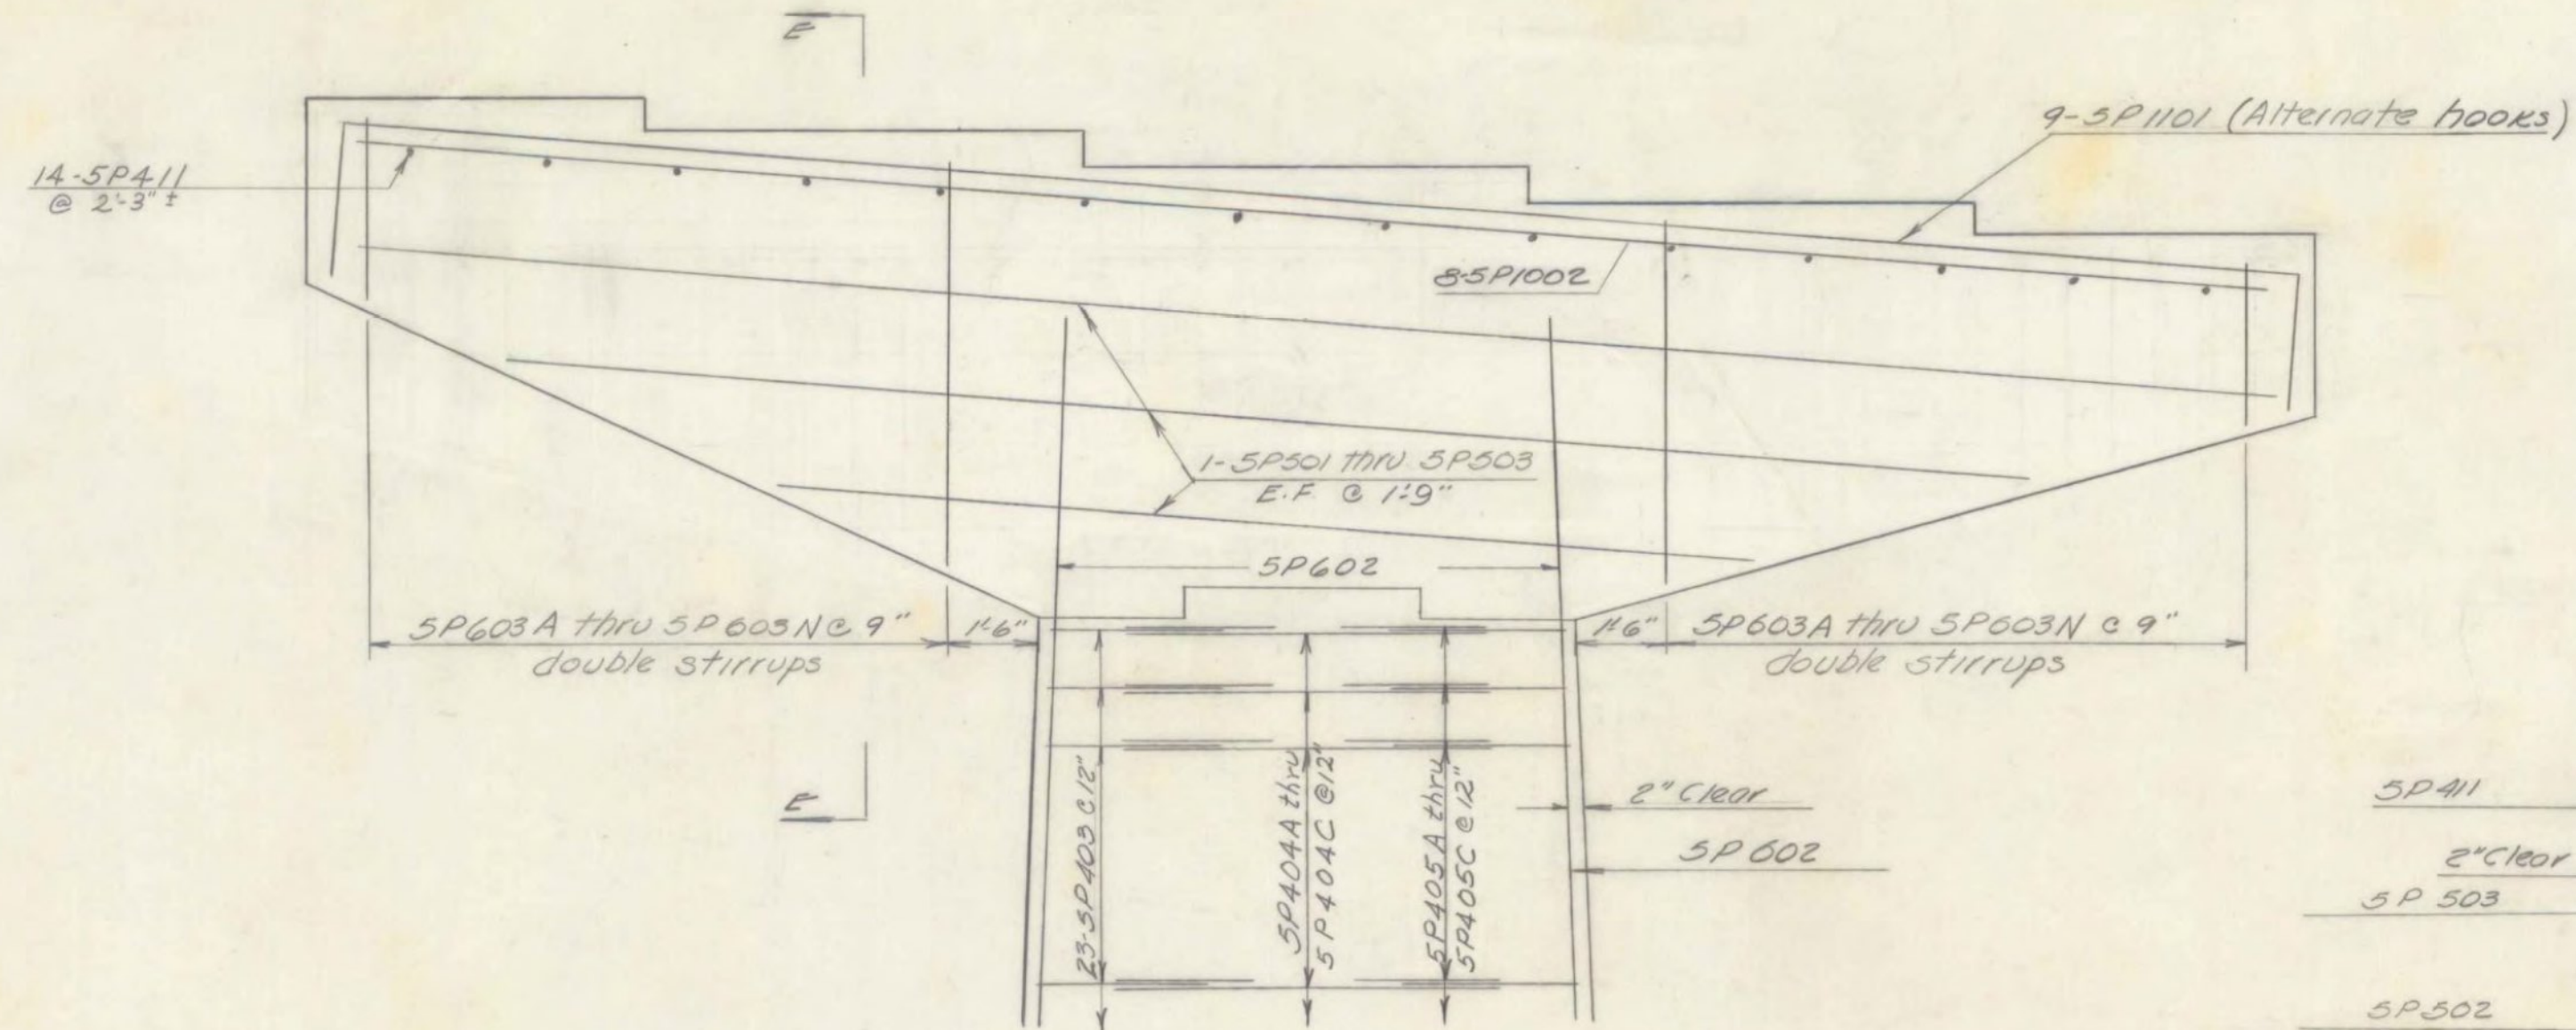


SECTION A-A  
Scale 3/8" = 1'

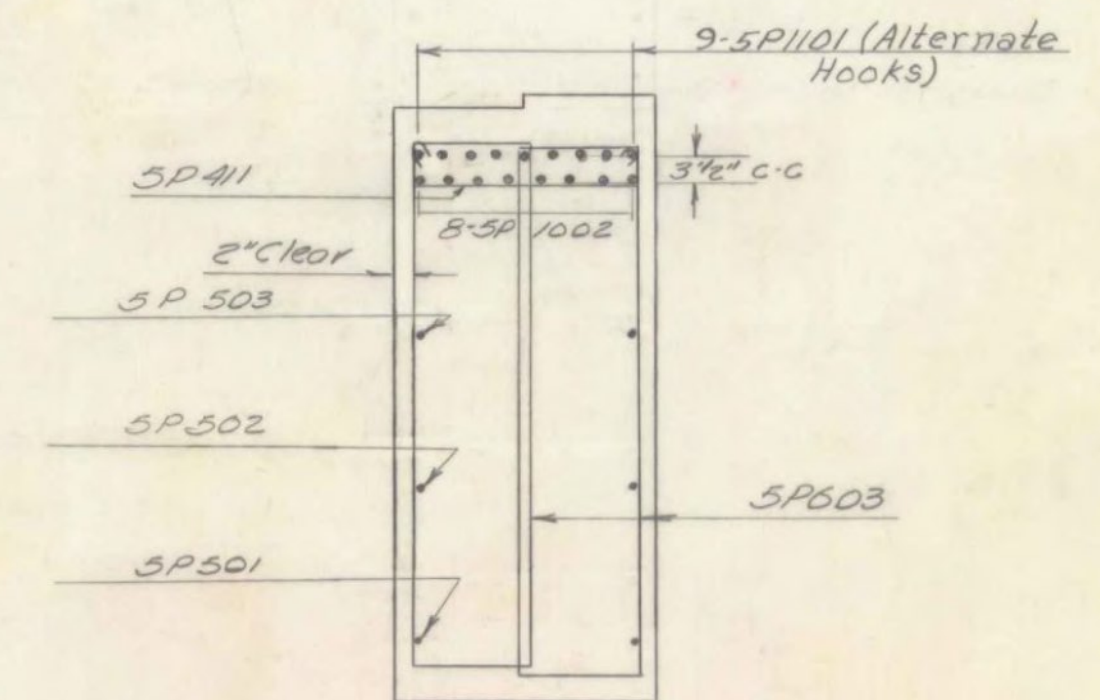

SECTION E-E  
Scale 1/2" = 1'  
SEE REVISION (BELOW)


- NOTES
1. For pier notes see Br 113
  2. Maximum footing pressure is 6.5 kips per sq. ft.

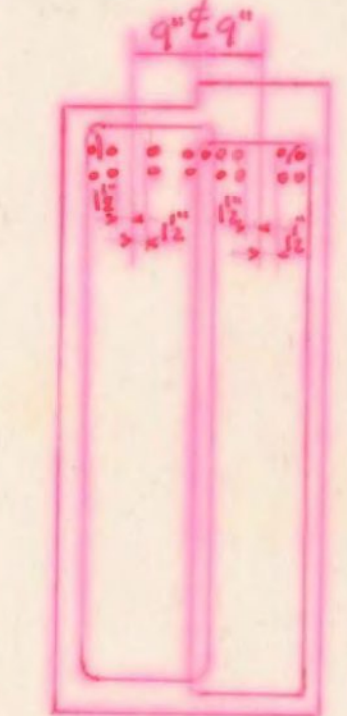


REVISED SECTION E-E  
LOCATE 5-P1101 & 5P1002 AS SHOWN  
TO PROVIDE CLEARANCE FOR SWEDGE BOLTS

FAIR HAVEN - WEST RUTLAND  
BF MEMB (35)  
SHEET 33 OF 44  
BRIDGE NO. 13E  
FOR REFERENCE ONLY


ROUTE No US 4 STA 687+50  
PIER 5 (E.B.)  
US 4 over DEHRR & CASTLETON RIVER  
SCALE As noted  
IN CHARGE WENDELL SMITH  
DRAWN By Phalsa CHECKED BY A. Couch 246  
PROJECT No R 020-1(102)  
SHEET 97 OF 359 Br 116

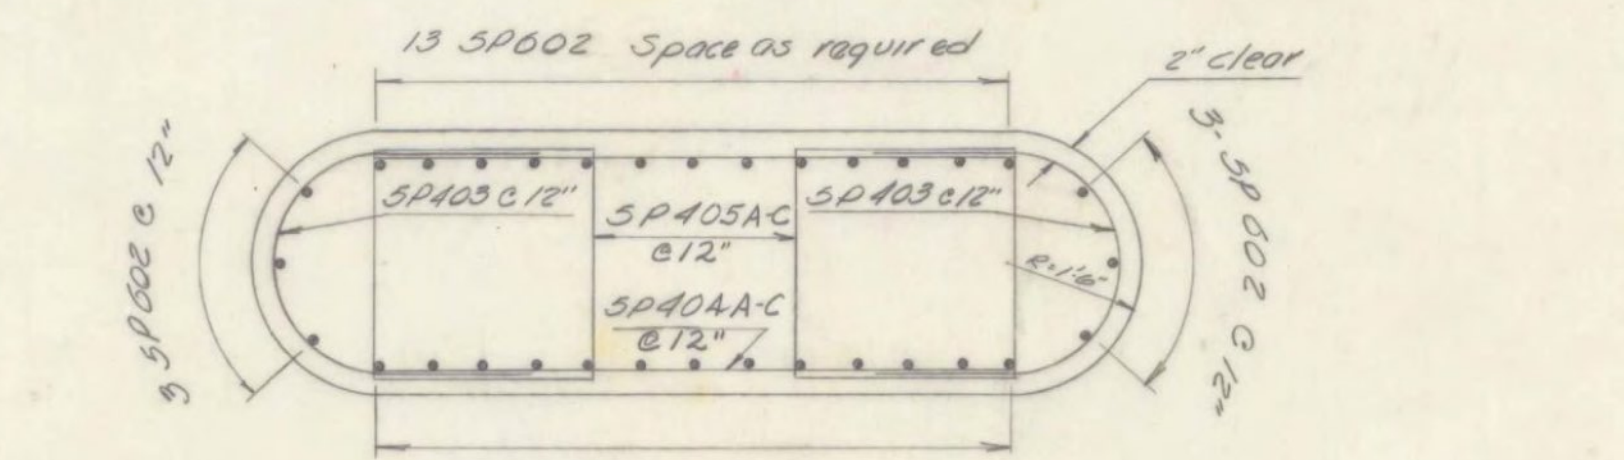

SECTION B-B  
Scale 1/2" = 1'

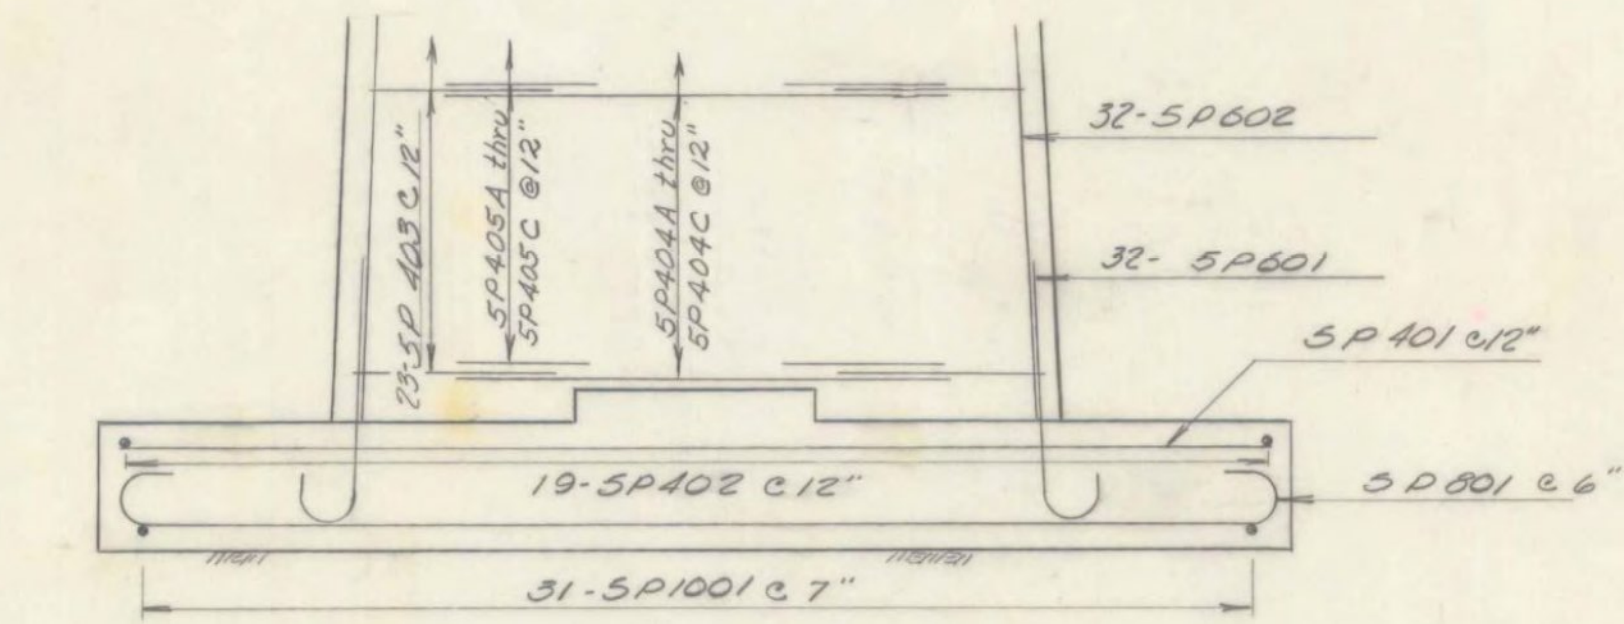

SECTION C-C  
Scale 3/8" = 1'

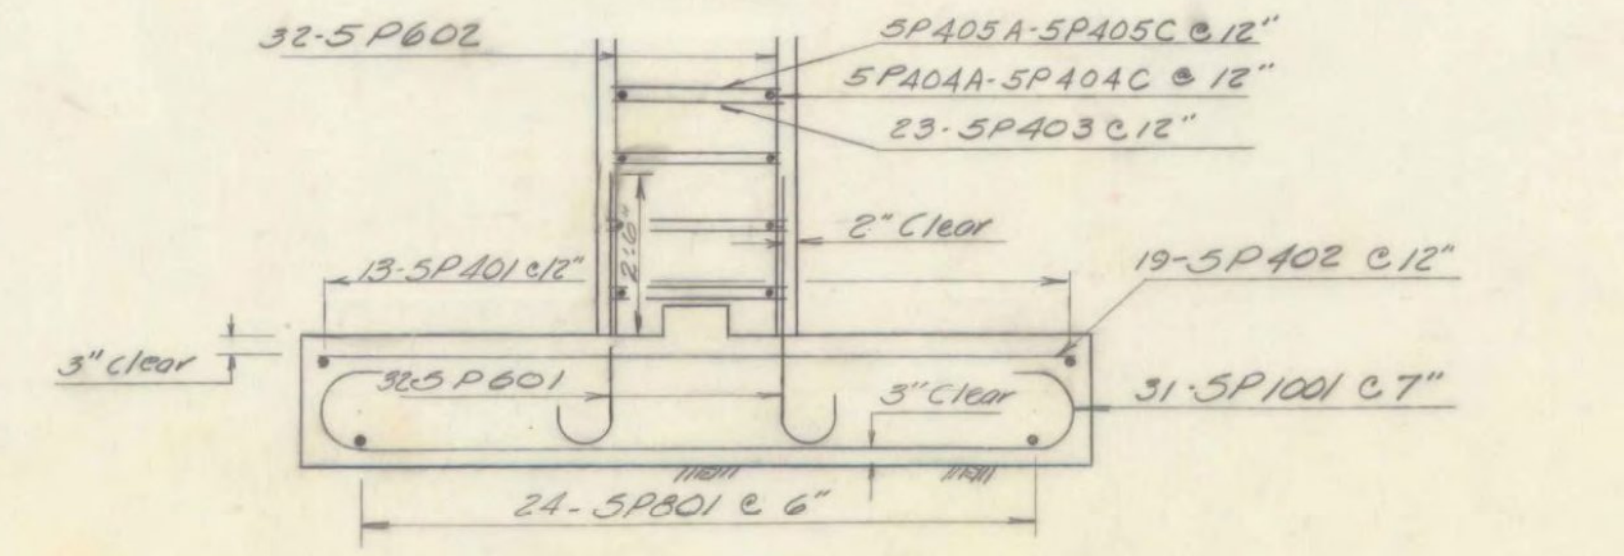

SECTION D-D  
Scale 3/8" = 1'