



STATE OF VERMONT AGENCY OF TRANSPORTATION

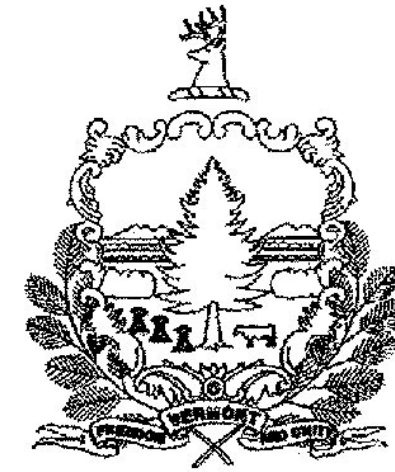

PROPOSED IMPROVEMENT BRIDGE PROJECT

TOWN OF WESTON
COUNTY OF WINDSOR

VT ROUTE 100 (RURAL MINOR ARTERIAL), BRIDGE NO 98


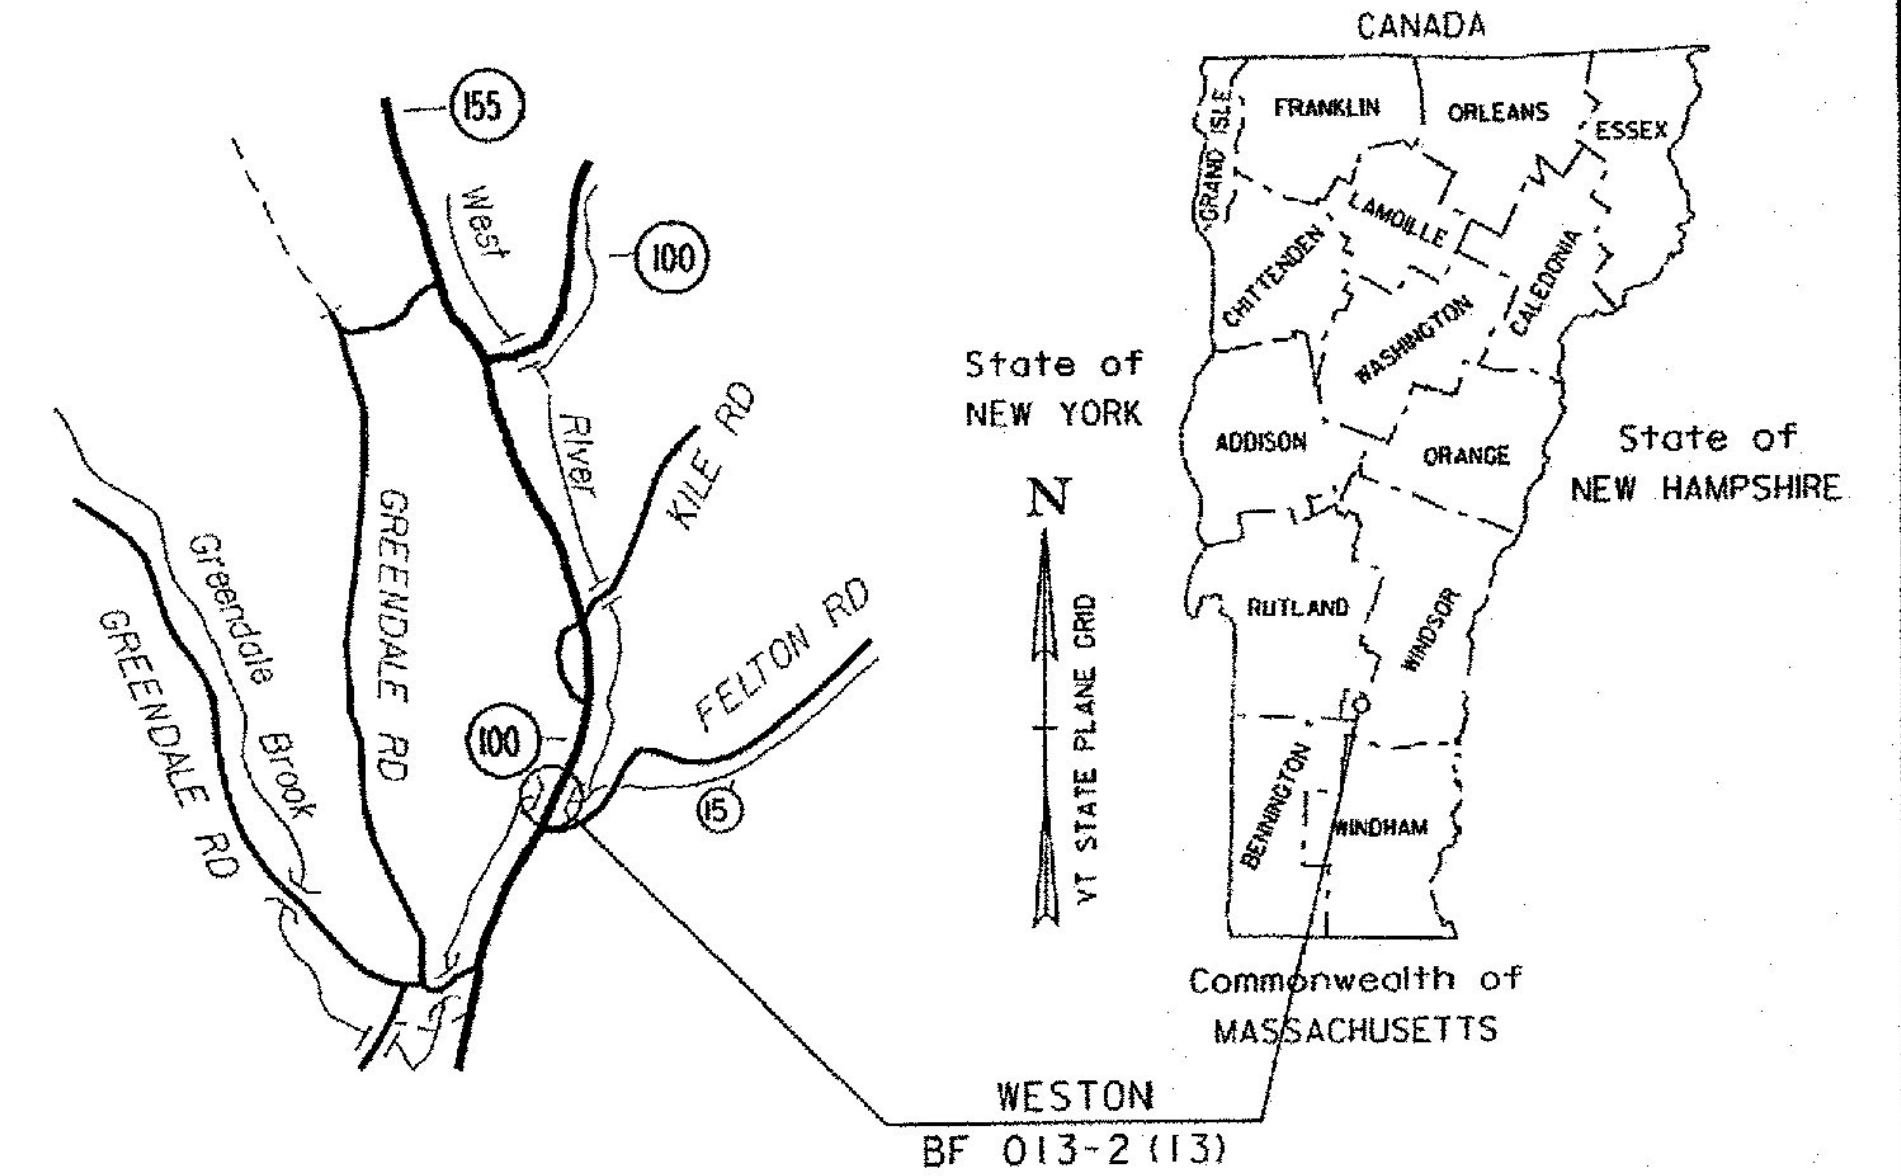


RECORD PLANS	
CONTRACTOR:	THE BELDEN CO. INC. - RUTLAND, VT
RESIDENT ENGINEER:	CHRISTOPHER D. WILLIAMS
CONSTRUCTION BEGAN:	MAY 2, 2016
CONSTRUCTION COMPLETE:	JULY 8, 2016
RECORD PLANS BY:	CHRISTOPHER D. WILLIAMS & JESSE IVES
I HEREBY CERTIFY THAT ALL THE CONSTRUCTION REQUIRED BY THIS SET OF DRAWINGS HAS BEEN ACCOMPLISHED AS INDICATED HEREIN.	
BY: <i>Chris Williams</i>	RESIDENT ENGINEER
DATE: 4/6/2017	
NOTE: Any further information concerning final quantities, amounts or other details relative to this project may be found at Central Files in the electronic archives.	

PROJECT LOCATION: LOCATED IN THE COUNTY OF WINDSOR, IN THE TOWN OF WESTON, ON VT ROUTE 100; BRIDGE NO. 98 OVER THE WEST RIVER; APPROXIMATELY 1.1 MILES SOUTH OF THE INTERSECTION OF VT ROUTE 100 AND VT ROUTE 155.

PROJECT DESCRIPTION: WORK TO BE PERFORMED UNDER THIS PROJECT INCLUDES THE REMOVAL AND REPLACEMENT OF BRIDGE NO. 98 ON THE EXISTING ALIGNMENT, WITH ASSOCIATED ROADWAY AND CHANNEL WORK.


LENGTH OF STRUCTURE: 63.34 FEET
LENGTH OF ROADWAY: 241.66 FEET
LENGTH OF PROJECT: 305.00 FEET

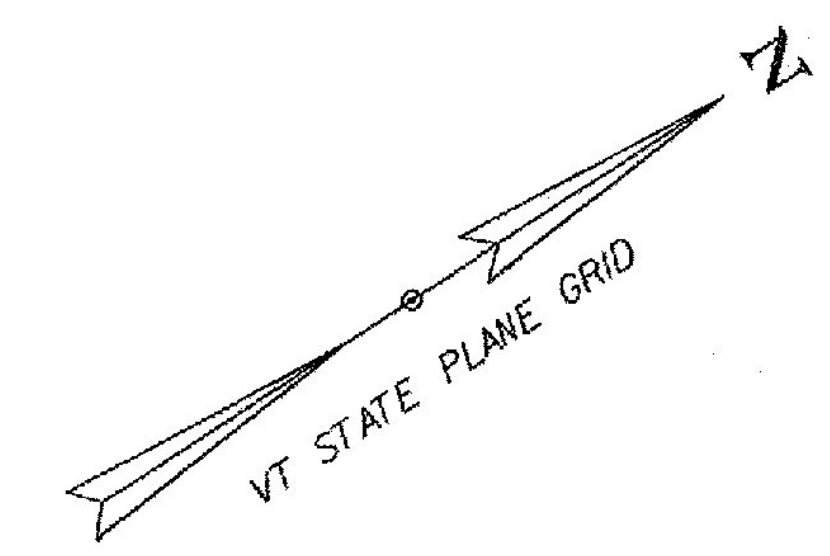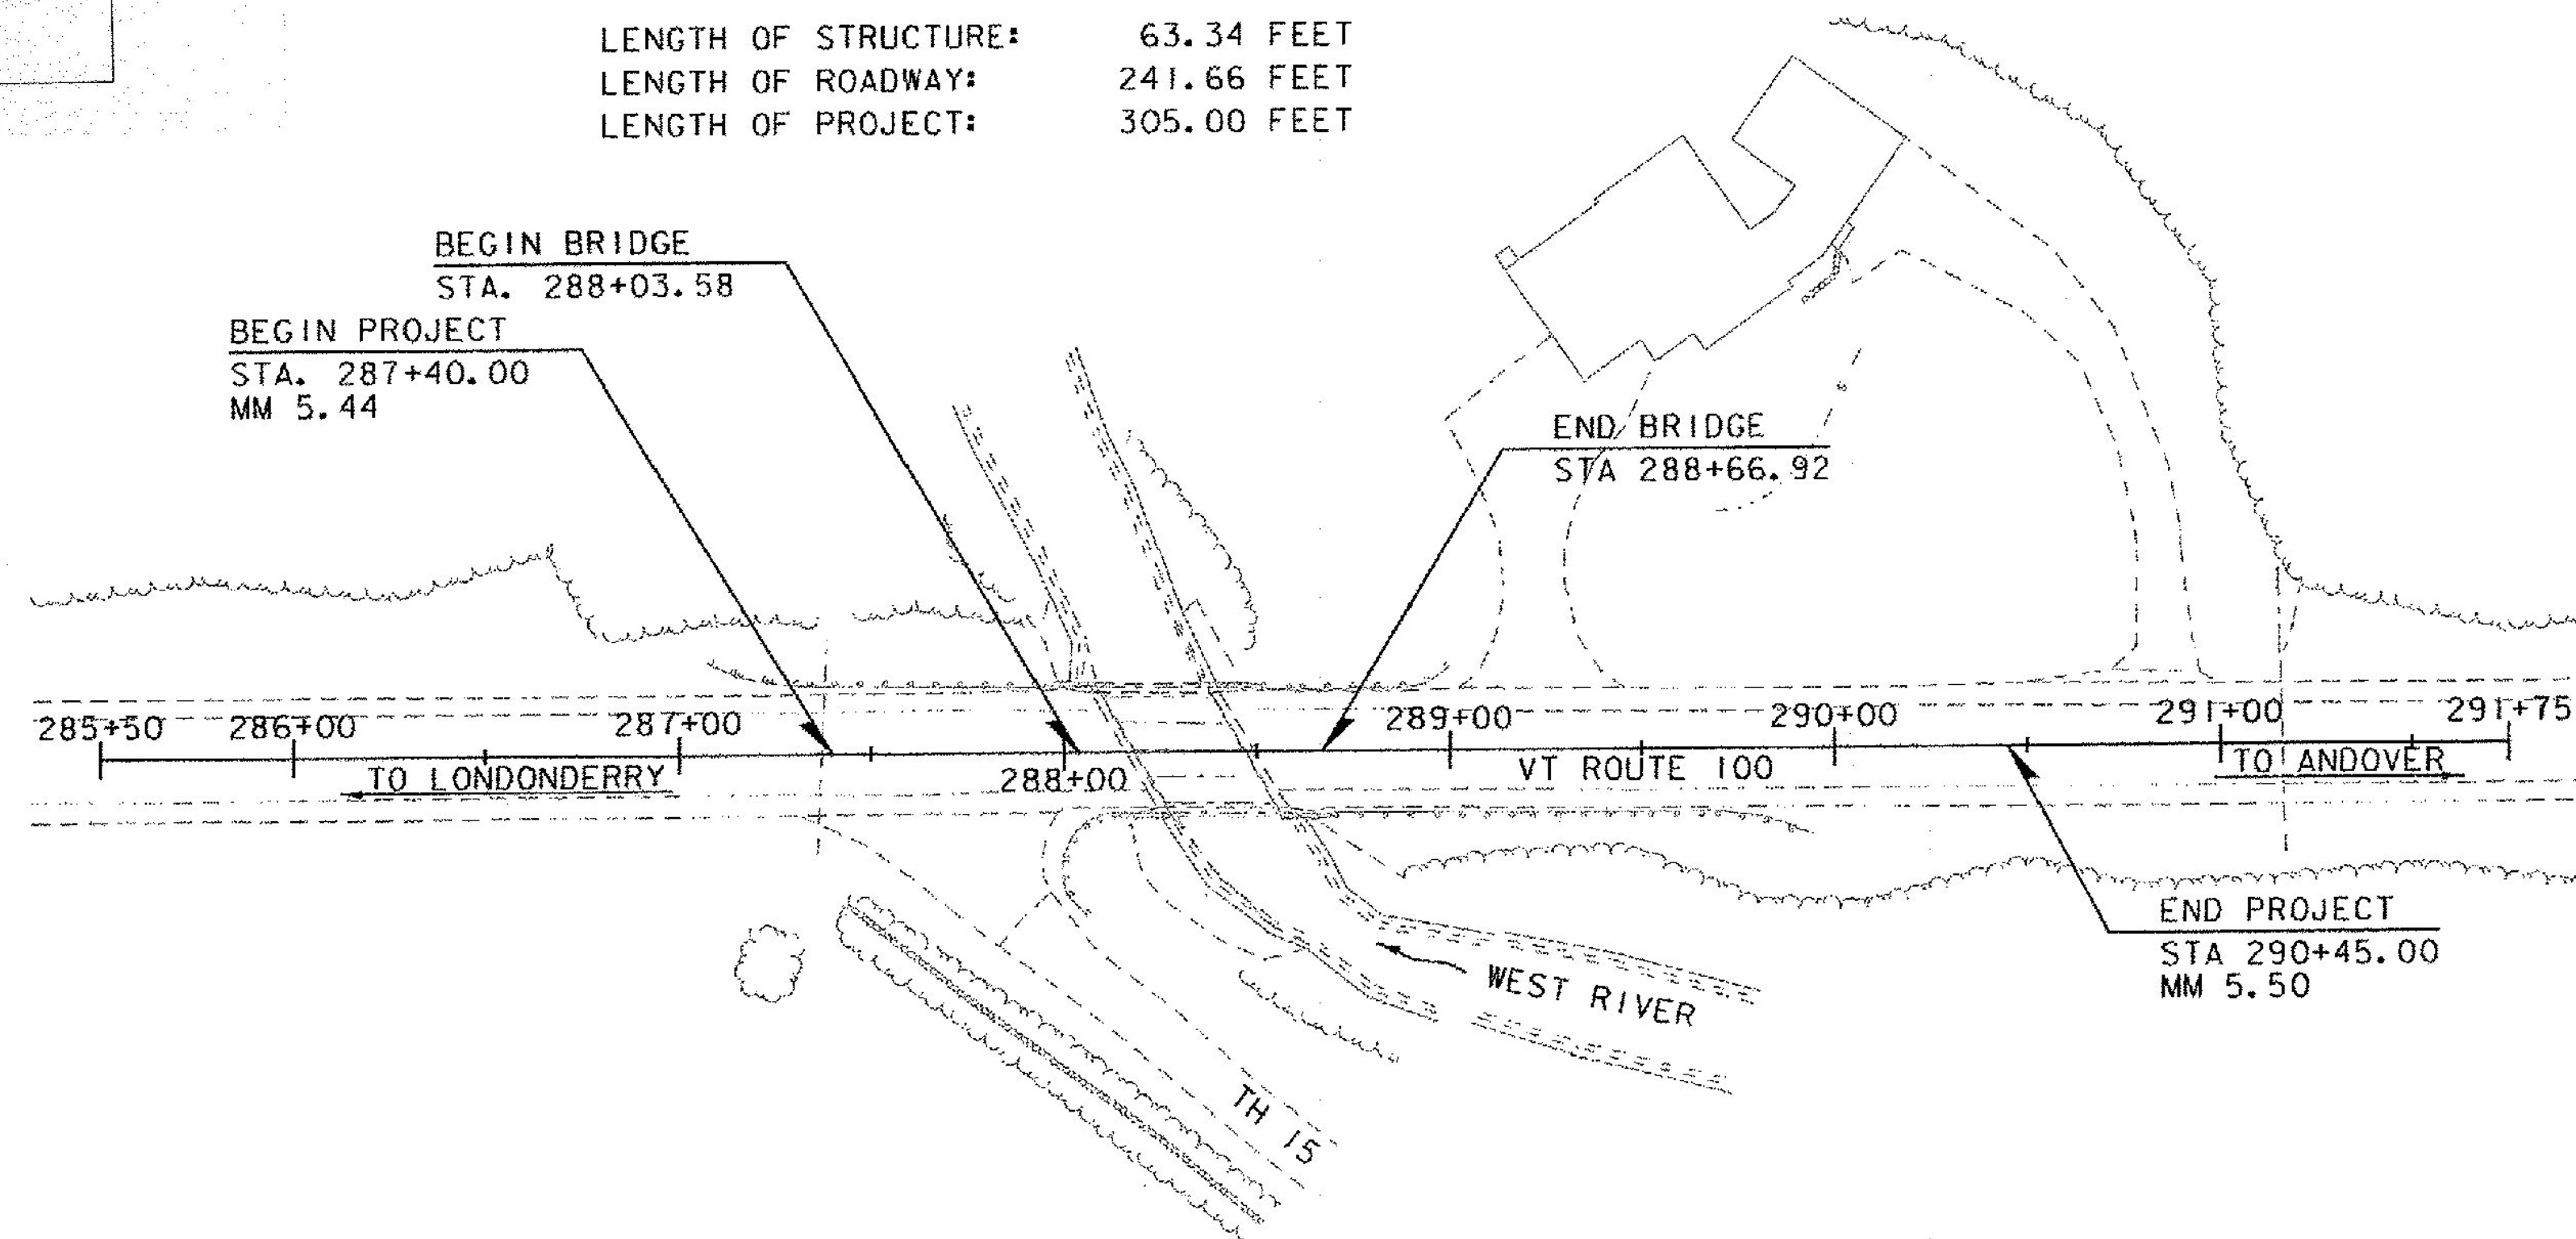

CONSTRUCTION IS TO BE CARRIED ON IN ACCORDANCE WITH THESE PLANS AND THE STANDARD SPECIFICATIONS FOR CONSTRUCTION DATED 2011, AS APPROVED BY THE FEDERAL HIGHWAY ADMINISTRATION ON JULY 20, 2011 FOR USE ON THIS PROJECT, INCLUDING ALL SUBSEQUENT REVISIONS AND SUCH REVISED SPECIFICATIONS AND SPECIAL PROVISIONS AS ARE INCORPORATED IN THESE PLANS.

QUALITY ASSURANCE PROGRAM : LEVEL 2	
SURVEYED BY :	R. GILMAN
SURVEYED DATE :	05/15/2013
DATUM	
VERTICAL	NAVD88
HORIZONTAL	NAD 83 (2011)

SCALE 1" = 40'-0"
 40 0 40

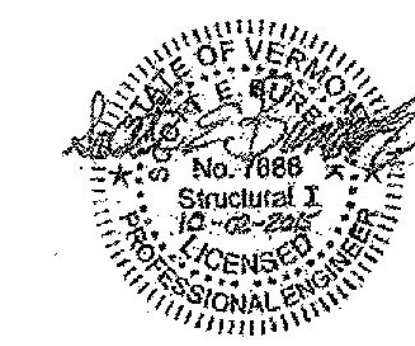

DIRECTOR OF PROJECT DELIVERY	
APPROVED: <i>J.M.V. Fitch</i>	DATE: 10/2/2015
PROJECT MANAGER : JENNIFER M.V. FITCH, PE	
PROJECT NAME :	WESTON
PROJECT NUMBER :	BF 013-2 (13)
SHEET 1 OF 68 SHEETS	

