



TH 15 (FELTON ROAD) STA. 50+00 TO 51+45  
 SCALE 1" = 20' HORIZONTAL  
 1" = 10' VERTICAL

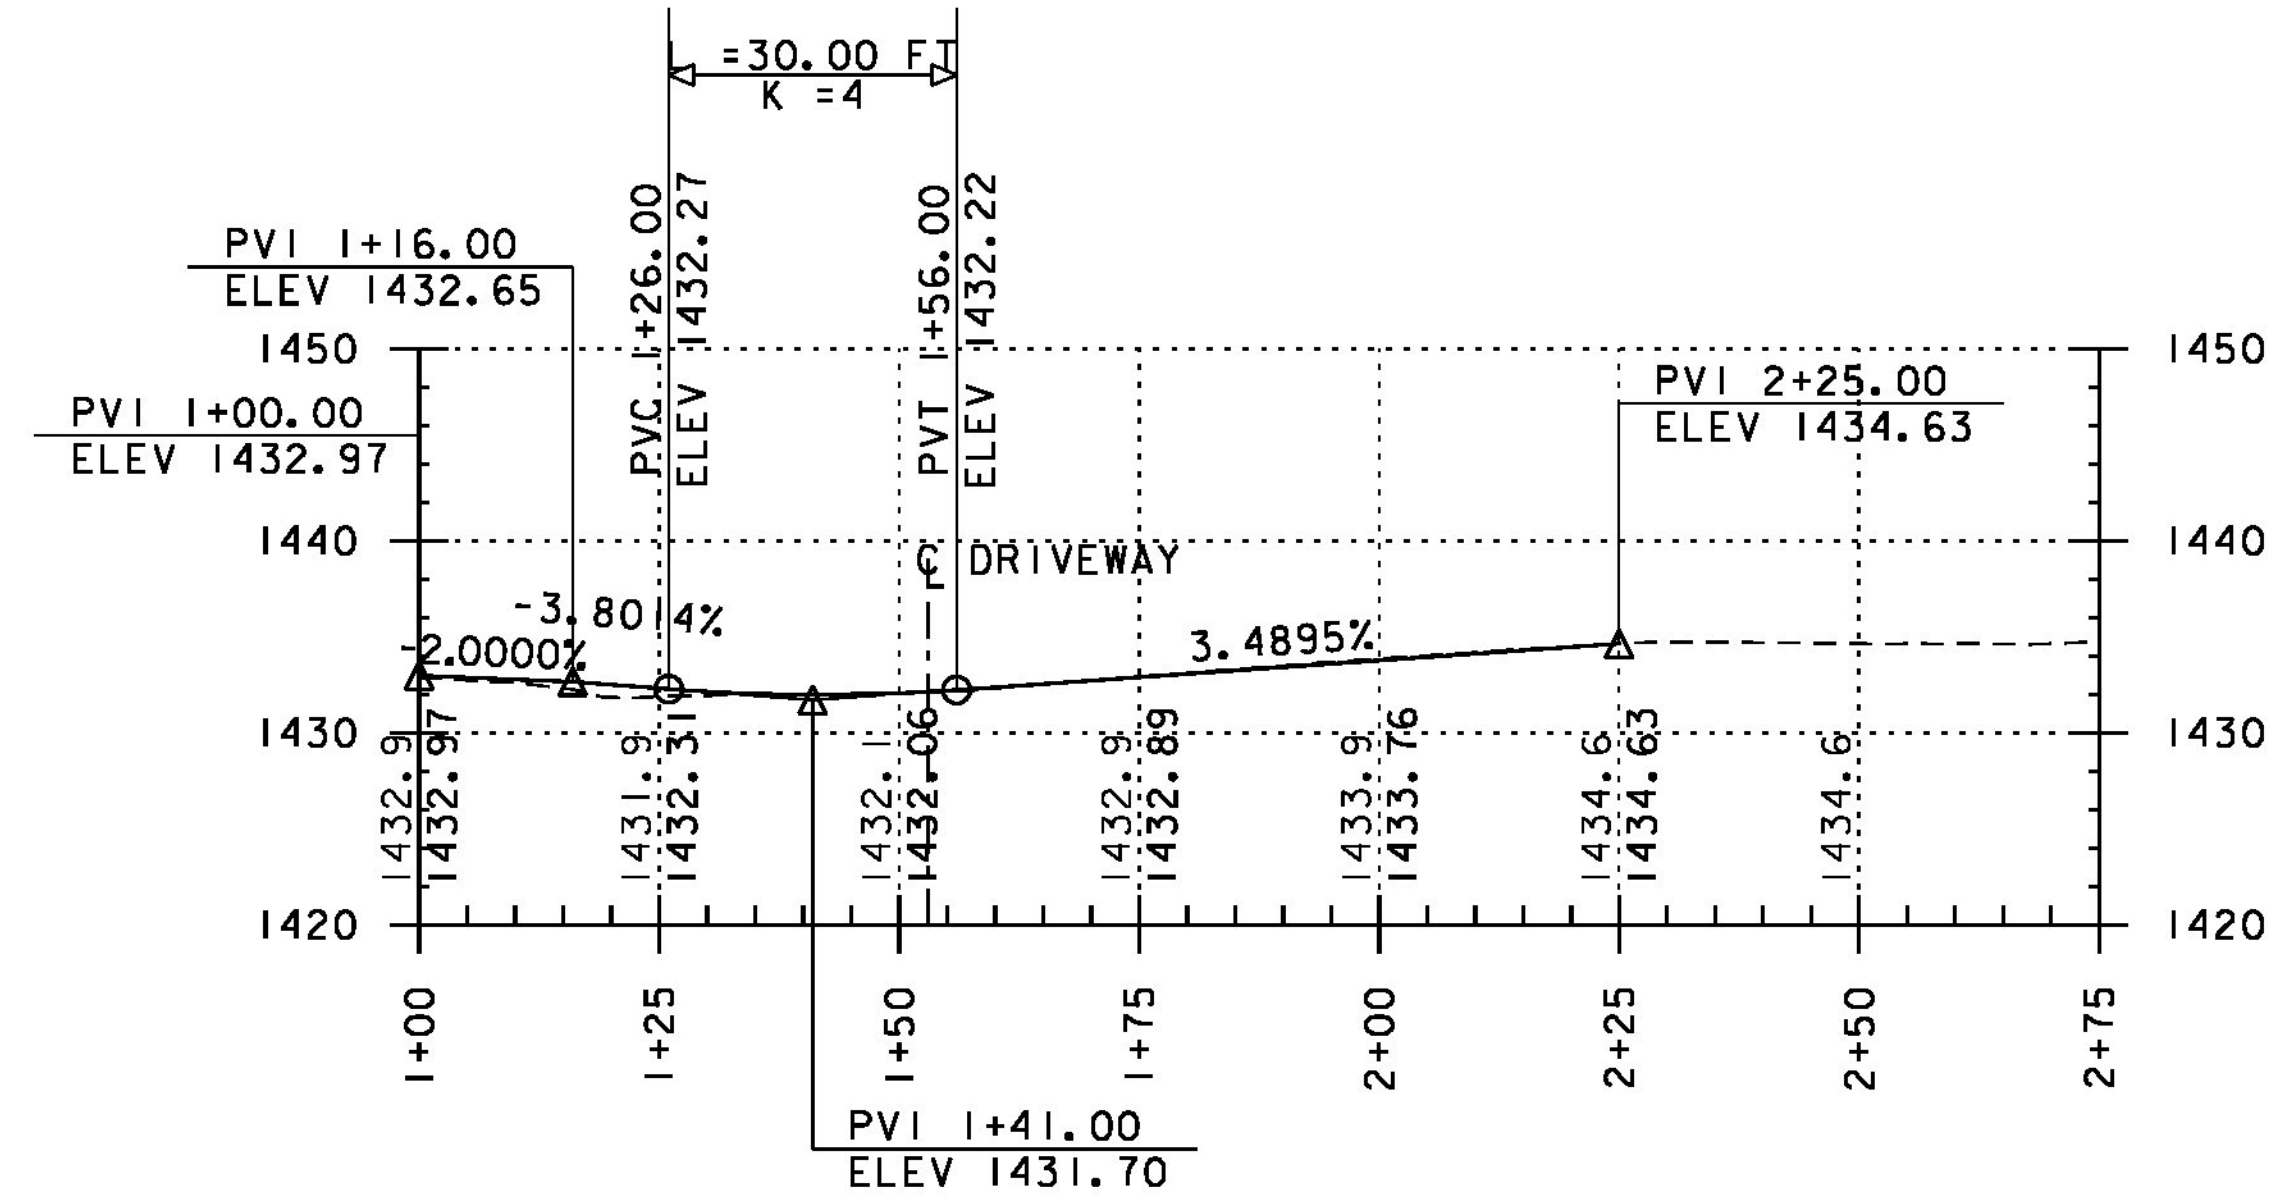

DRIVEWAY STA. 1+00 TO 2+75  
 SCALE 1" = 20' HORIZONTAL  
 1" = 10' VERTICAL

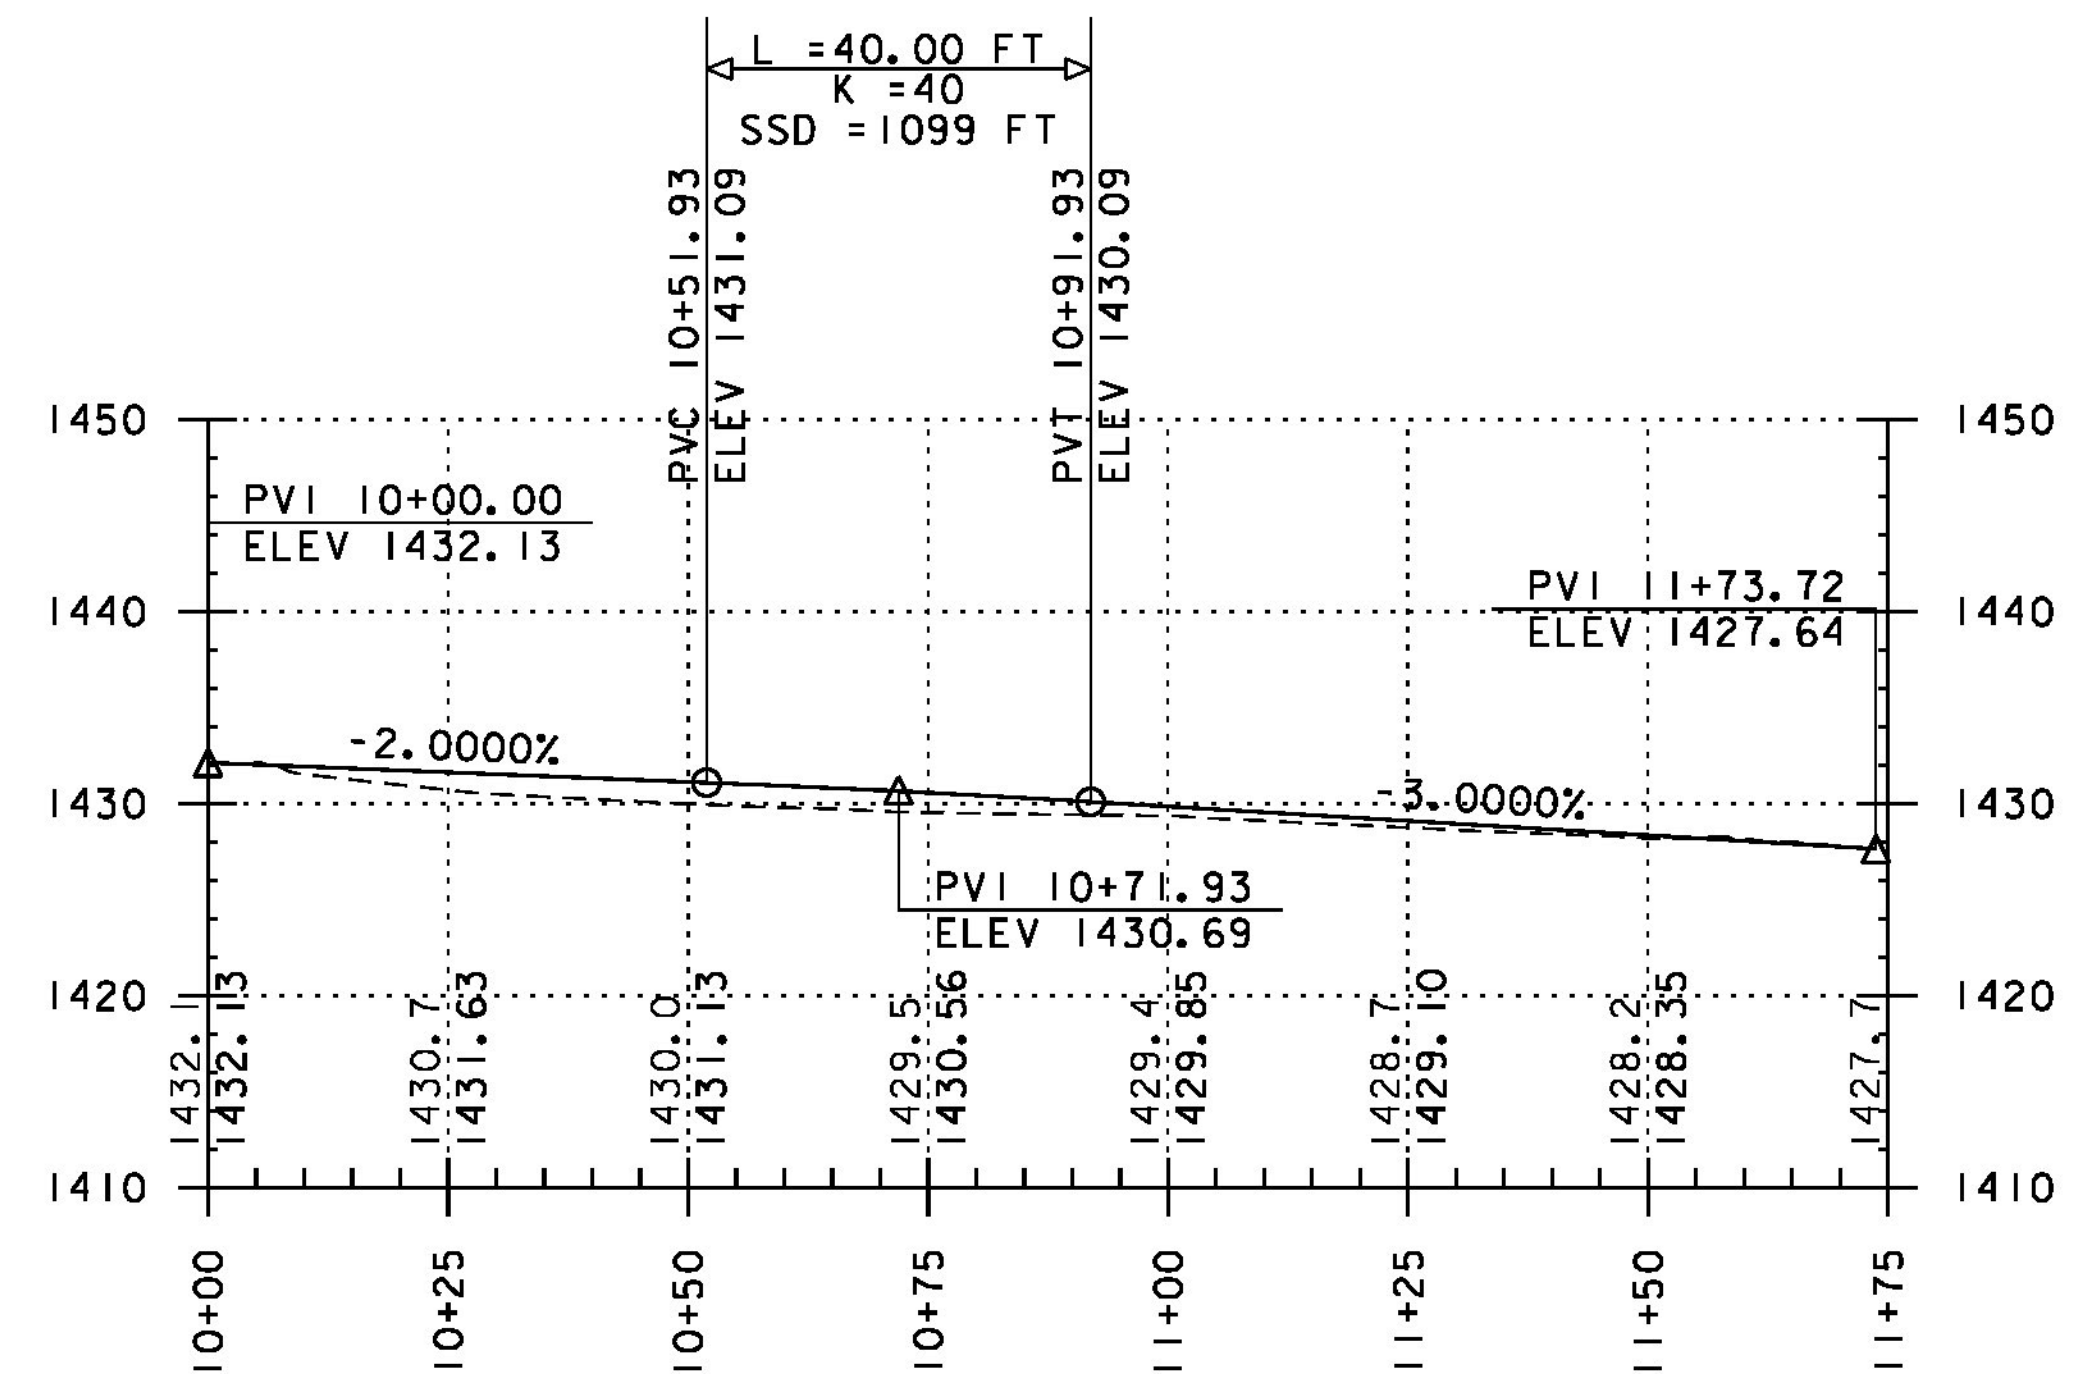

DRIVEWAY STA. 10+00 TO 11+75  
 SCALE 1" = 20' HORIZONTAL  
 1" = 10' VERTICAL

THE GRADES SHOWN TO THE NEAREST TENTH ARE THE ORIGINAL GROUND ELEVATIONS ALONG THE PROPOSED ALIGNMENT.

THE GRADES SHOWN TO THE NEAREST HUNDREDTH ARE THE FINISH GRADES ALONG THE PROPOSED ALIGNMENT.



PROJECT NAME: WESTON  
 PROJECT NUMBER: BF 013-2(13)

FILE NAME: z13b076pro.dgn  
 PROJECT LEADER: S.E. BURBANK  
 DESIGNED BY: J.J. WESTCOTT  
 DRIVEWAY PROFILES

PLOT DATE: 10/2/2015  
 DRAWN BY: J.J. WESTCOTT  
 CHECKED BY: S.E. BURBANK  
 SHEET 18 OF 68