


CAMBER DIAGRAM
NOT TO SCALE

CAMBER TABLE - GIRDERS 1 - 8 (INCHES)											
	0.00	0.1L	0.2L	0.3L	0.4L	0.5L	0.6L	0.7L	0.8L	0.9L	1.0L
STEEL DEFLECTION	0.00	0.20	0.37	0.51	0.59	0.62	0.59	0.51	0.37	0.20	0.00
SLAB AND SUPER DEFLECTION	0.00	0.76	1.44	1.98	2.31	2.43	2.31	1.98	1.44	0.76	0.00
TOTAL DEFLECTION	0.00	1.09	2.07	2.83	3.31	3.48	3.31	2.83	2.07	1.09	0.00
RESIDUAL CAMBER	0.00	0.44	0.82	1.11	1.29	1.35	1.29	1.11	0.82	0.44	0.00
TOTAL CAMBER	0.00	1.53	2.88	3.93	4.60	4.83	4.60	3.93	2.88	1.53	0.00

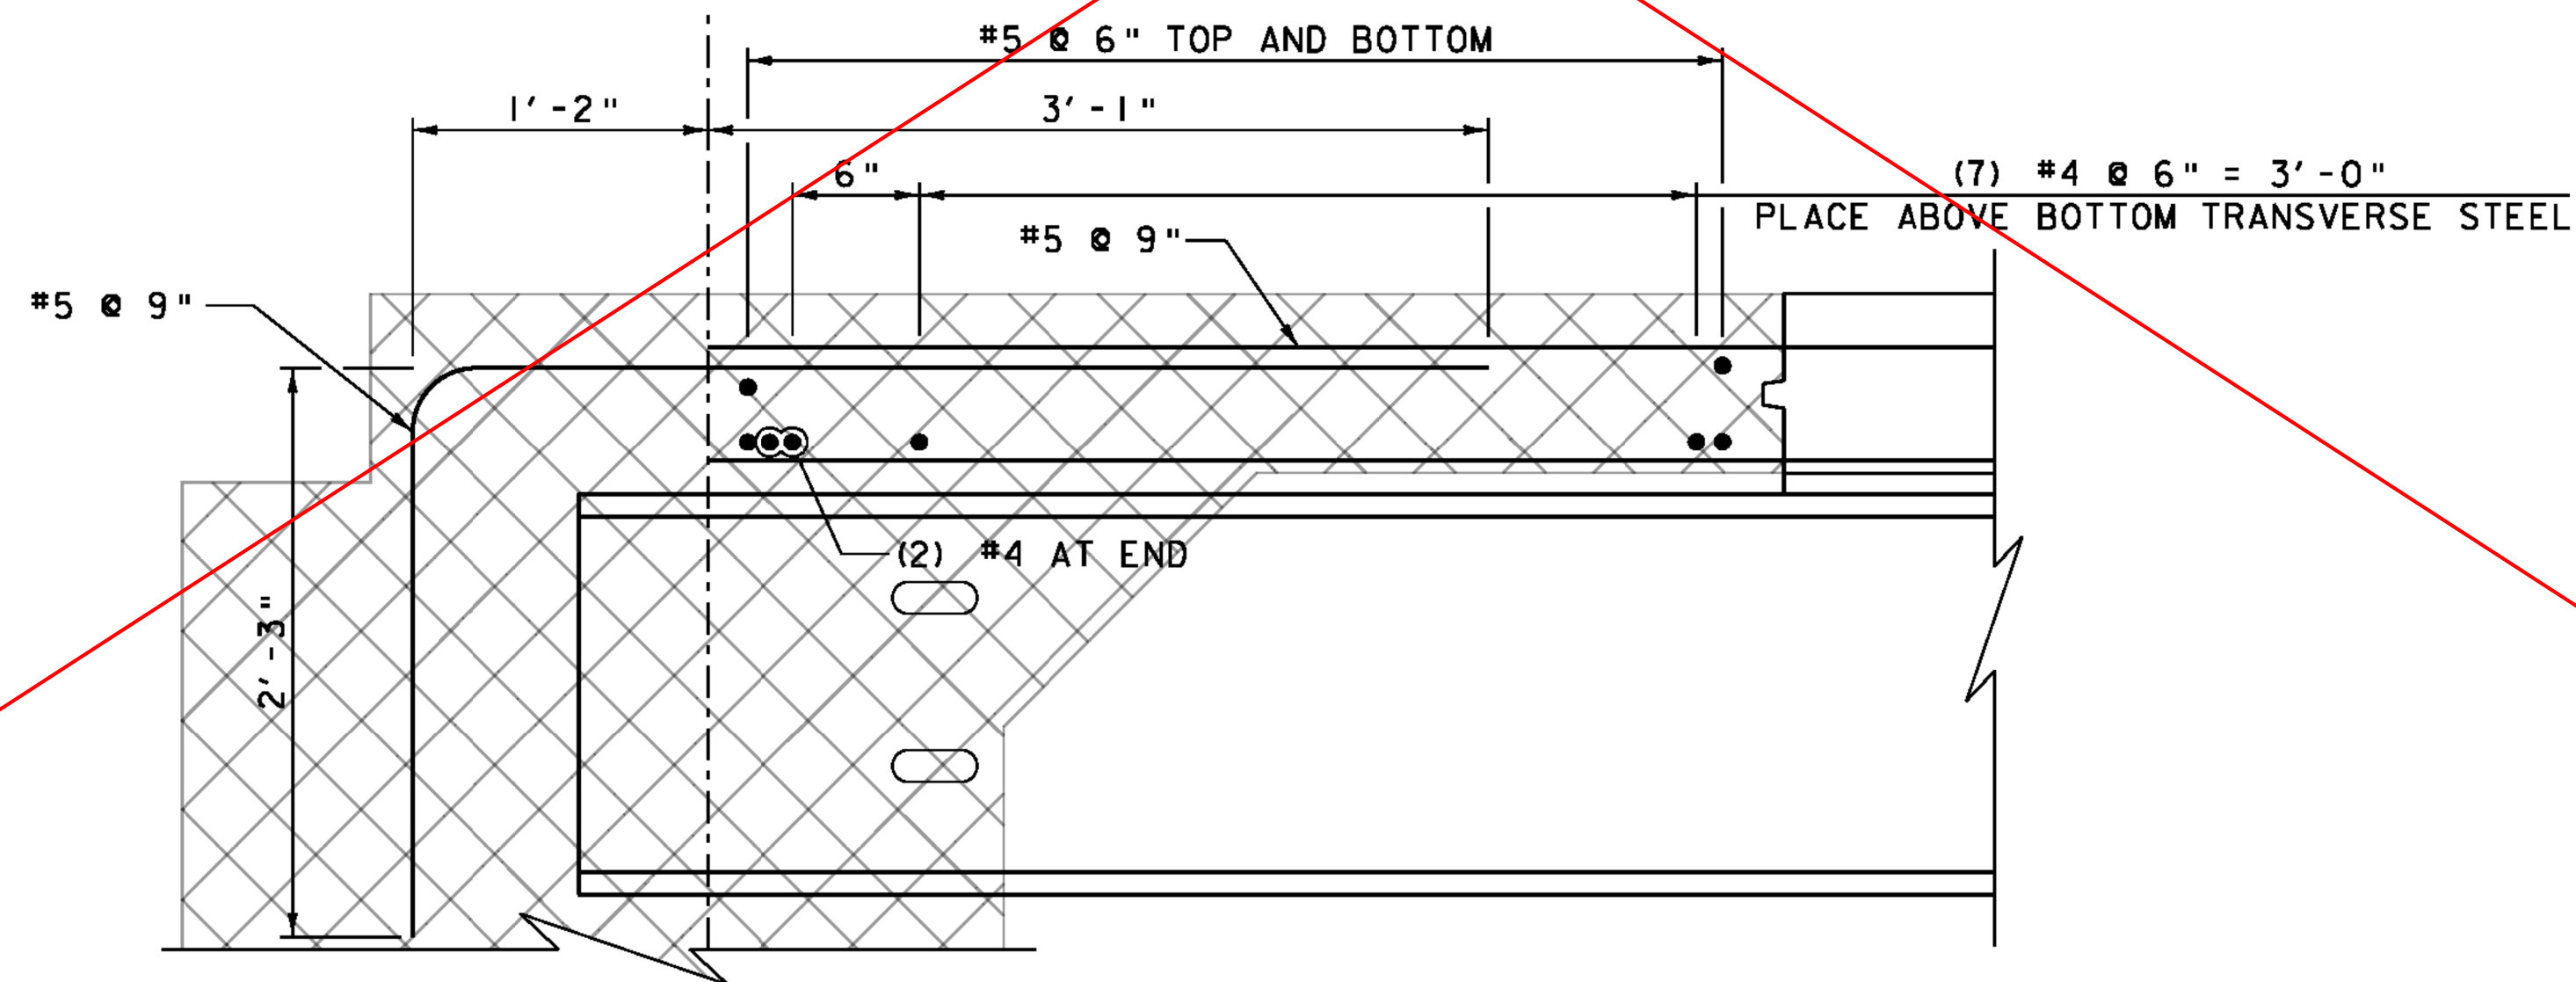

ADDITIONAL END REINFORCING
ELEVATION VIEW
SCALE 1/2" = 1'-0"



PROJECT NAME: WESTON	PLOT DATE: 10/2/2015
PROJECT NUMBER: BF 013-2(13)	DRAWN BY: K.G. BARRY
FILE NAME: z13b076sup2.dgn	CHECKED BY: M.J. MOZIER
PROJECT LEADER: S.E. BURBANK	SHEET 43 OF 68
DESIGNED BY: J.D. KEENER	
PBU CAMBER AND DEFLECTION	