


ABUTMENT NO 1 REINFORCING PLAN
 (TRANSVERSE POST-TENSIONING DUCTS & GROUT DUCTS NOT SHOWN FOR CLARITY)
 (ABUTMENT NO 2 SIMILAR)
 SCALE 1/2" = 1'-0"

NOTE:

NF = NEAR FACE
 FF = FAR FACE
 EF = EACH FACE
 ▲ = CUT TO FIT IN FIELD
 3" CLEAR, UNLESS OTHERWISE SPECIFIED ON THE PLANS.
 2'-2" BAR LAP UNLESS OTHERWISE SPECIFIED ON THE PLANS.

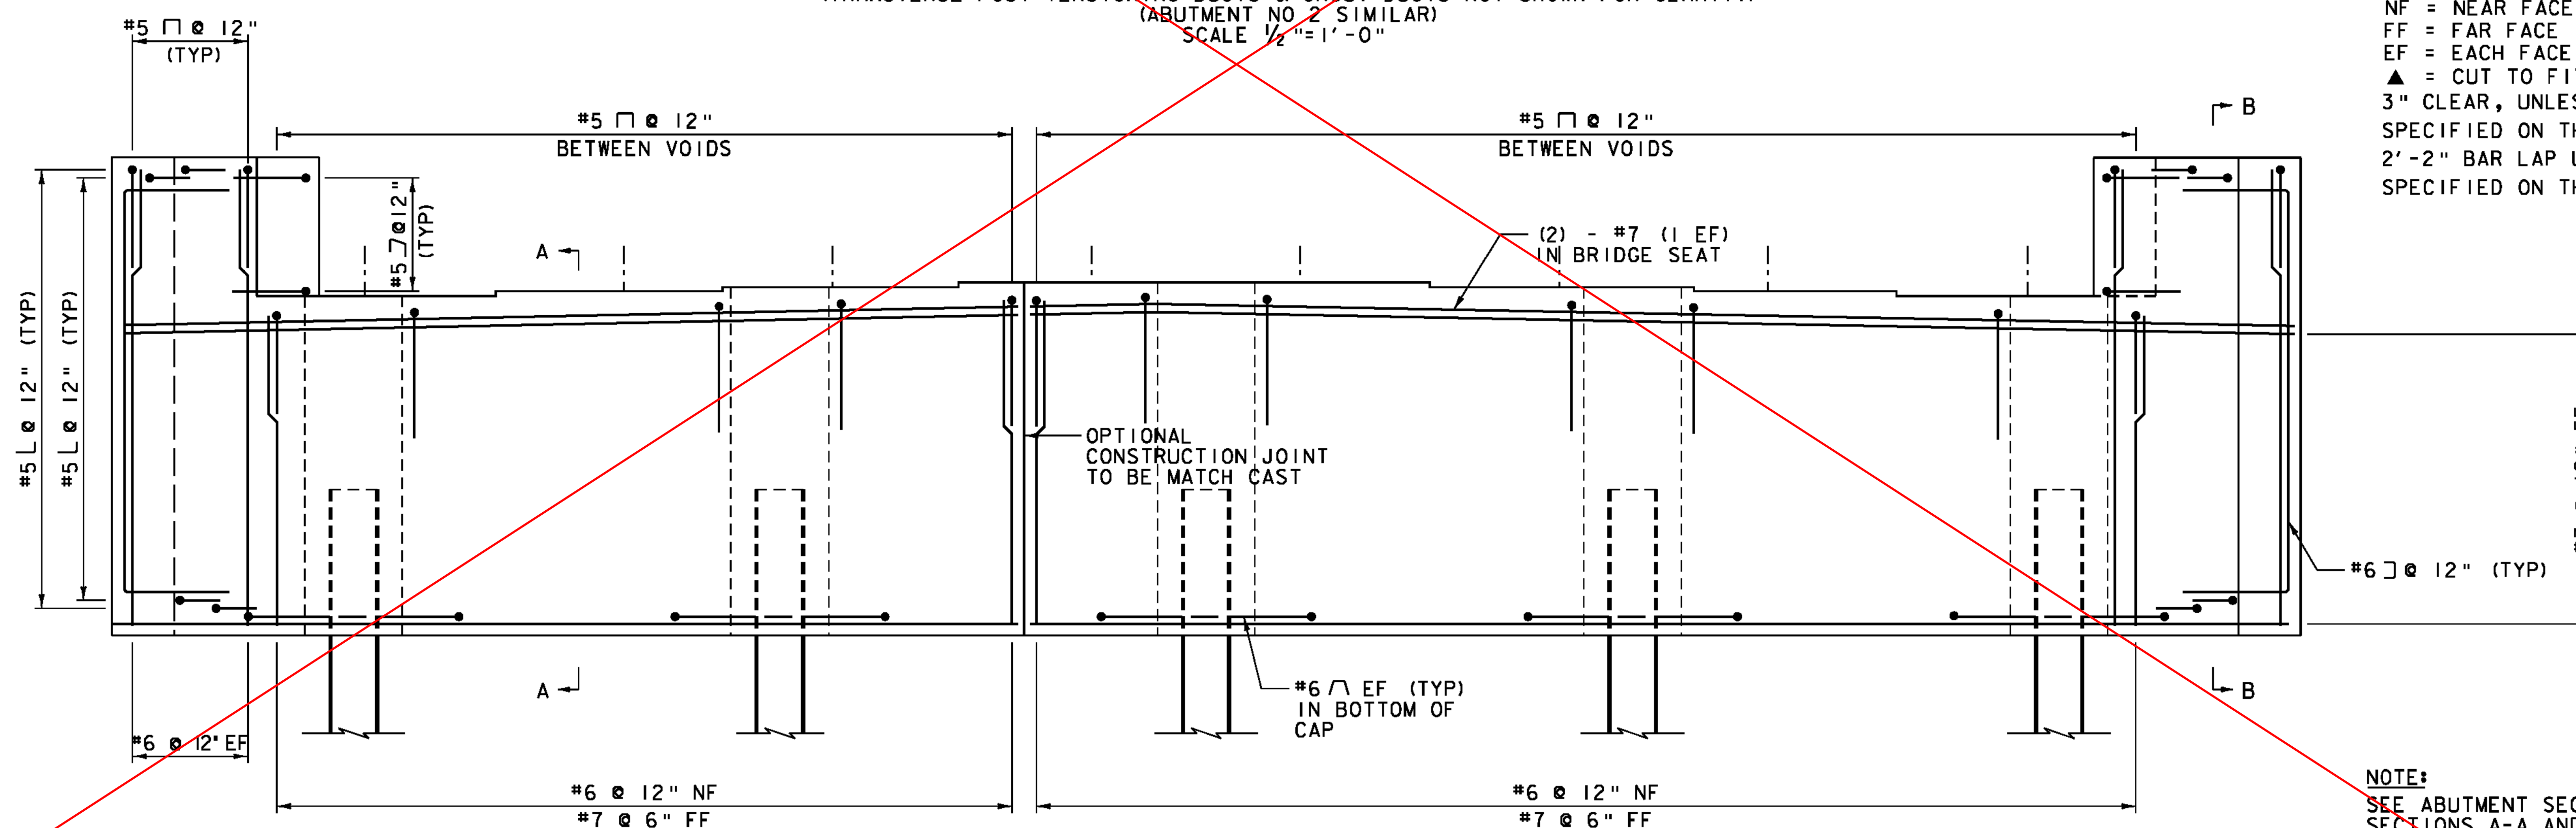

ABUTMENT NO 1 REINFORCING ELEVATION
 (TRANSVERSE POST-TENSIONING DUCTS & GROUT DUCTS NOT SHOWN FOR CLARITY)
 (ABUTMENT NO 2 SIMILAR)
 SCALE 1/2" = 1'-0"

NOTE:

SEE ABUTMENT SECTIONS SHEET FOR SECTIONS A-A AND B-B.

PROJECT NAME: WESTON
 PROJECT NUMBER: BF 013-2(13)

FILE NAME: z13b076sub2.dgn
 PROJECT LEADER: S.E. BURBANK
 DESIGNED BY: J.J. WESTCOTT
 PBU ABUTMENT REINFORCEMENT

PLOT DATE: 10/2/2015
 DRAWN BY: J.J. WESTCOTT
 CHECKED BY: L.S. CHERVINCKY
 SHEET 47 OF 68

