




1+50

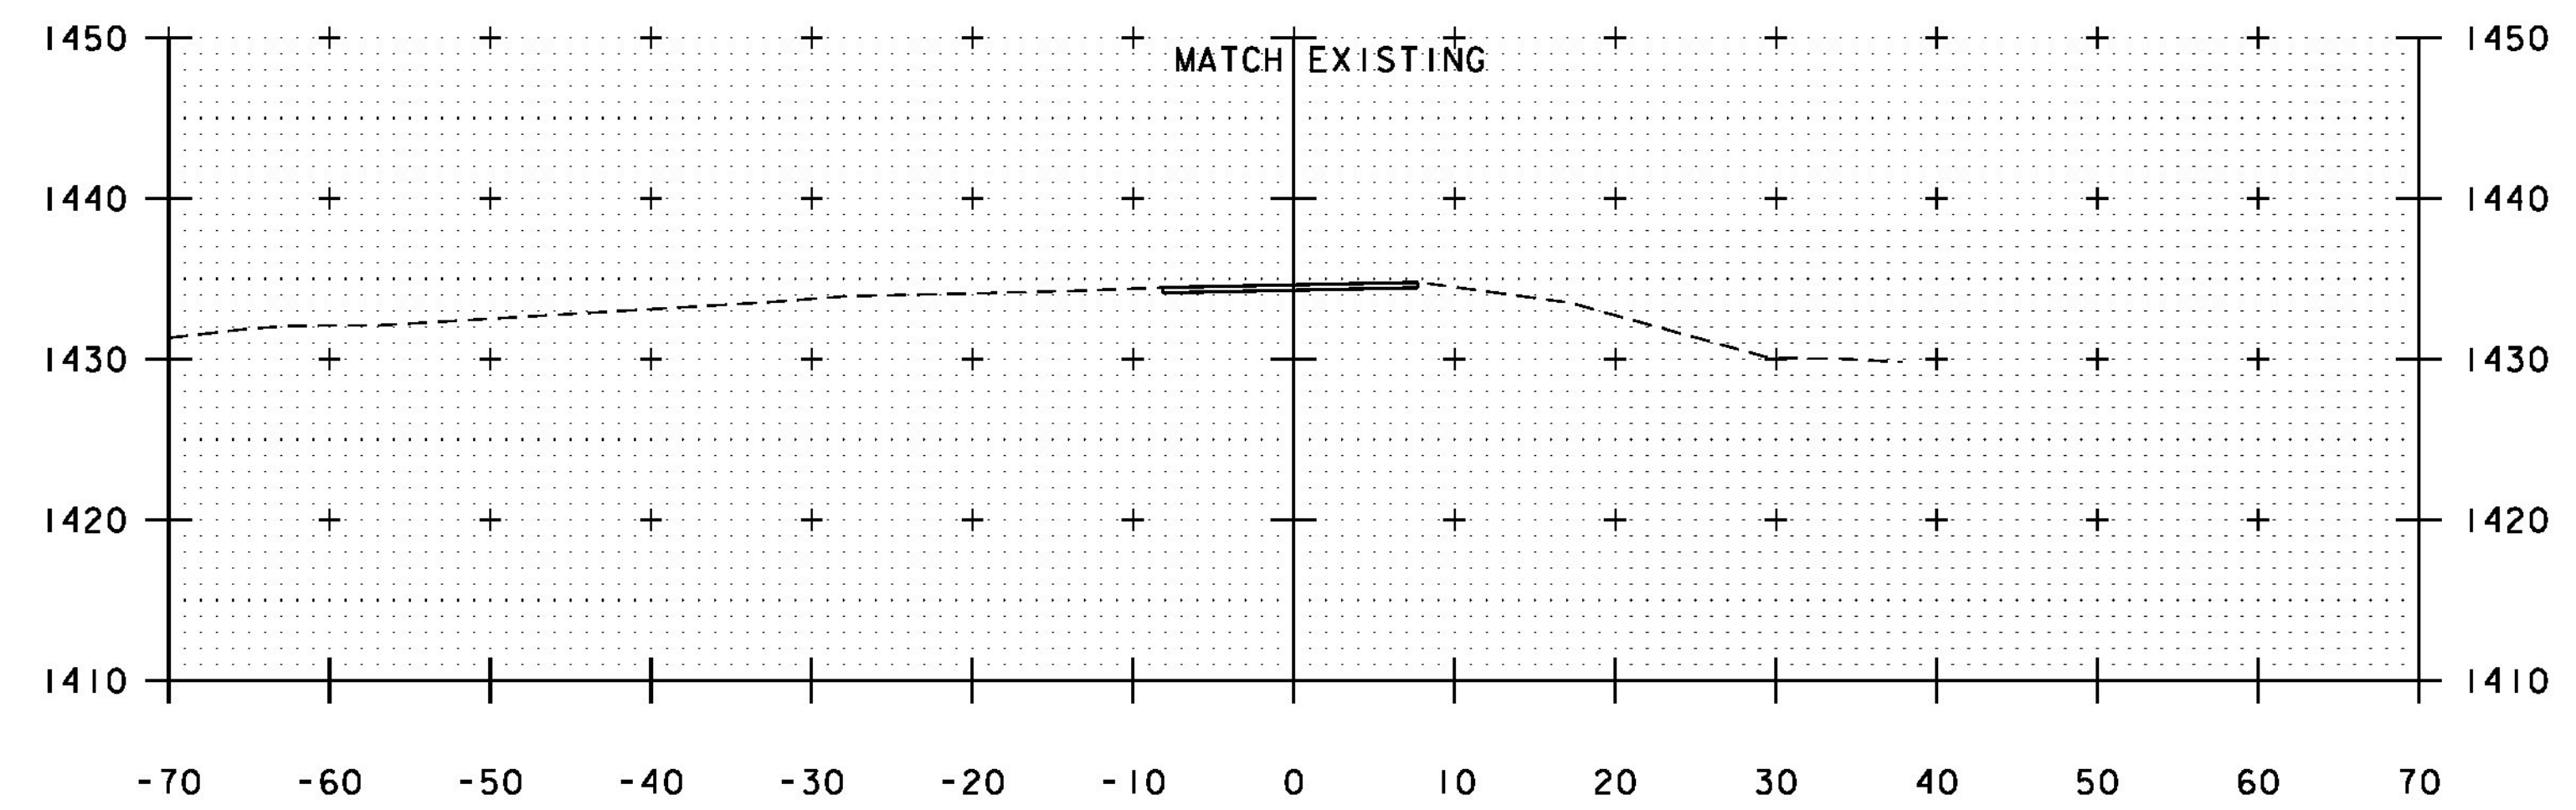


2+25

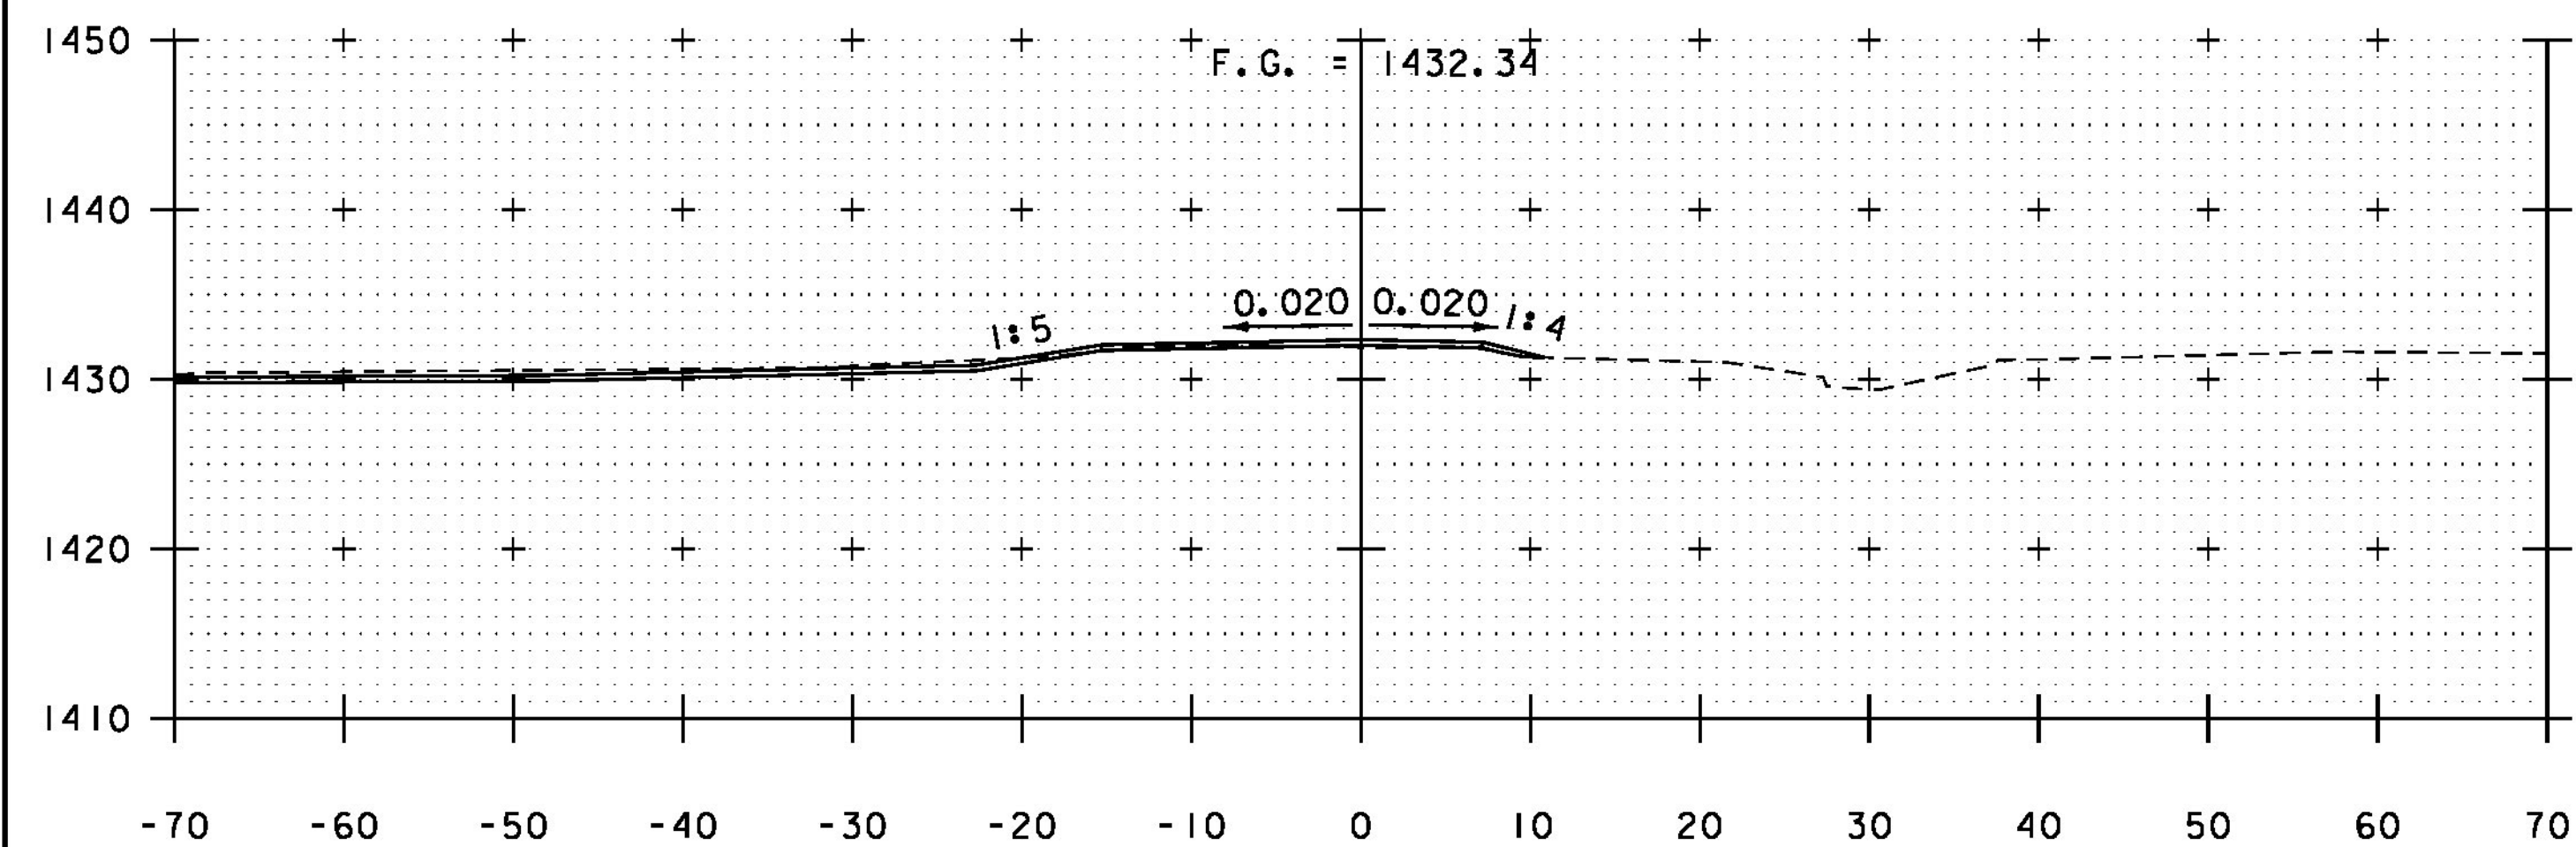


1+25

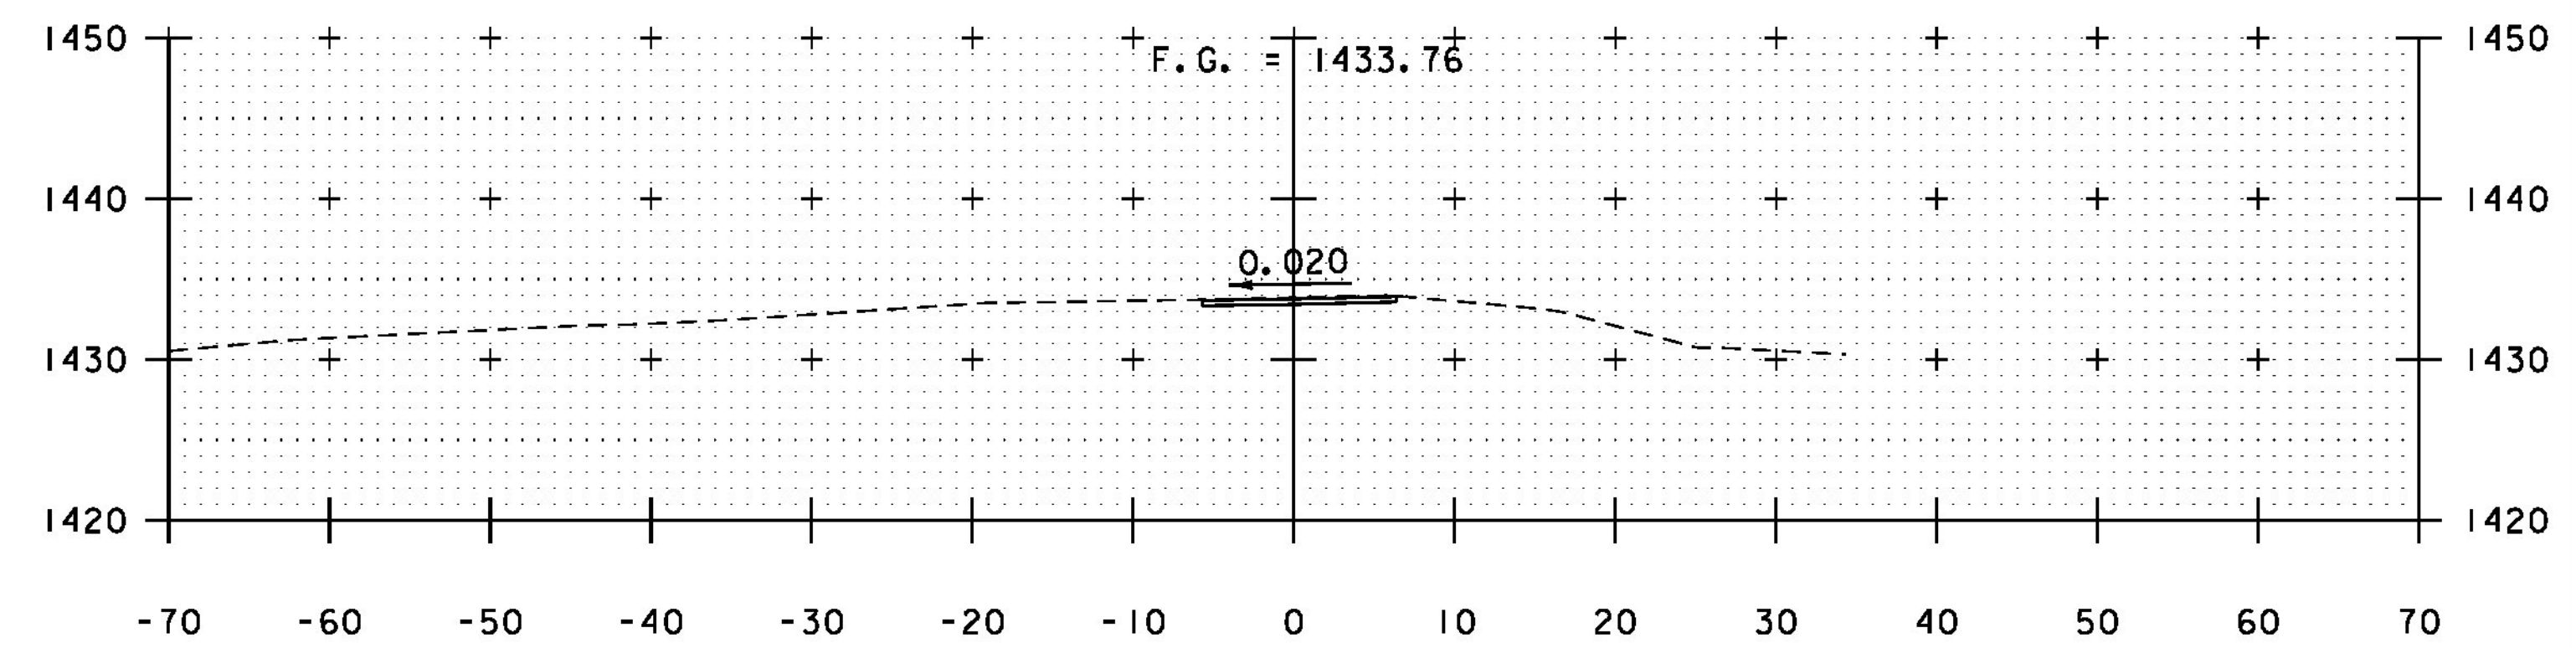

2+00

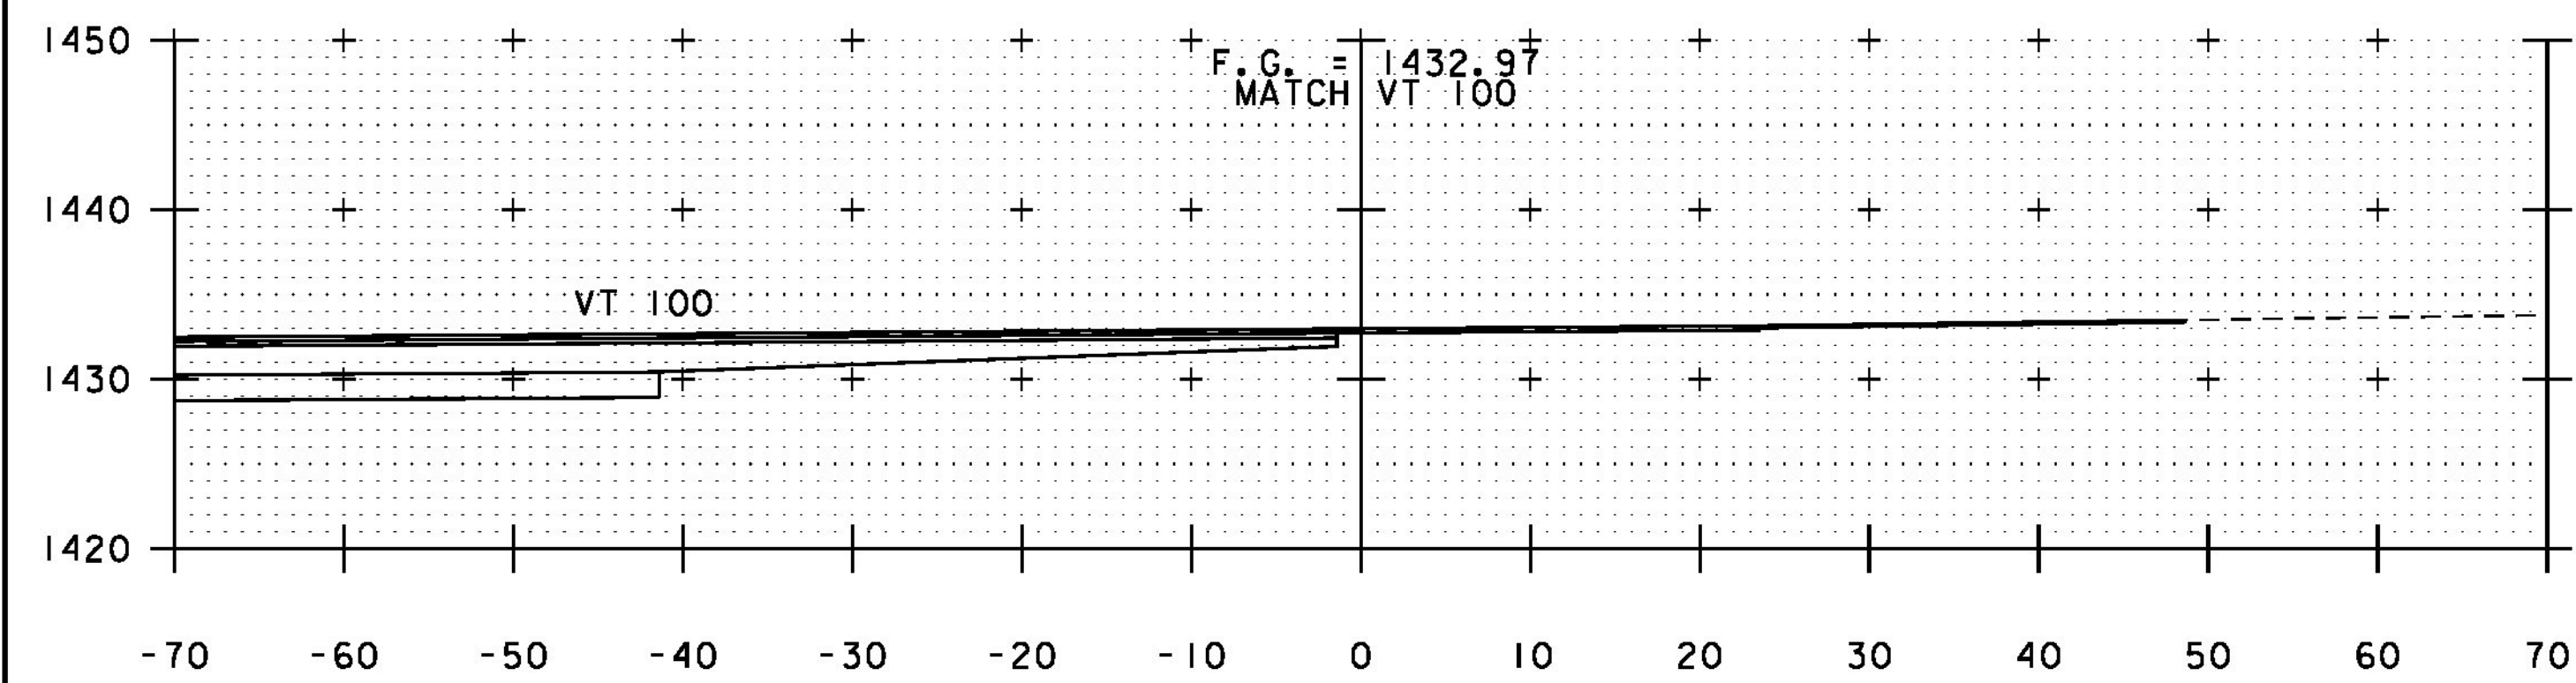

1+00

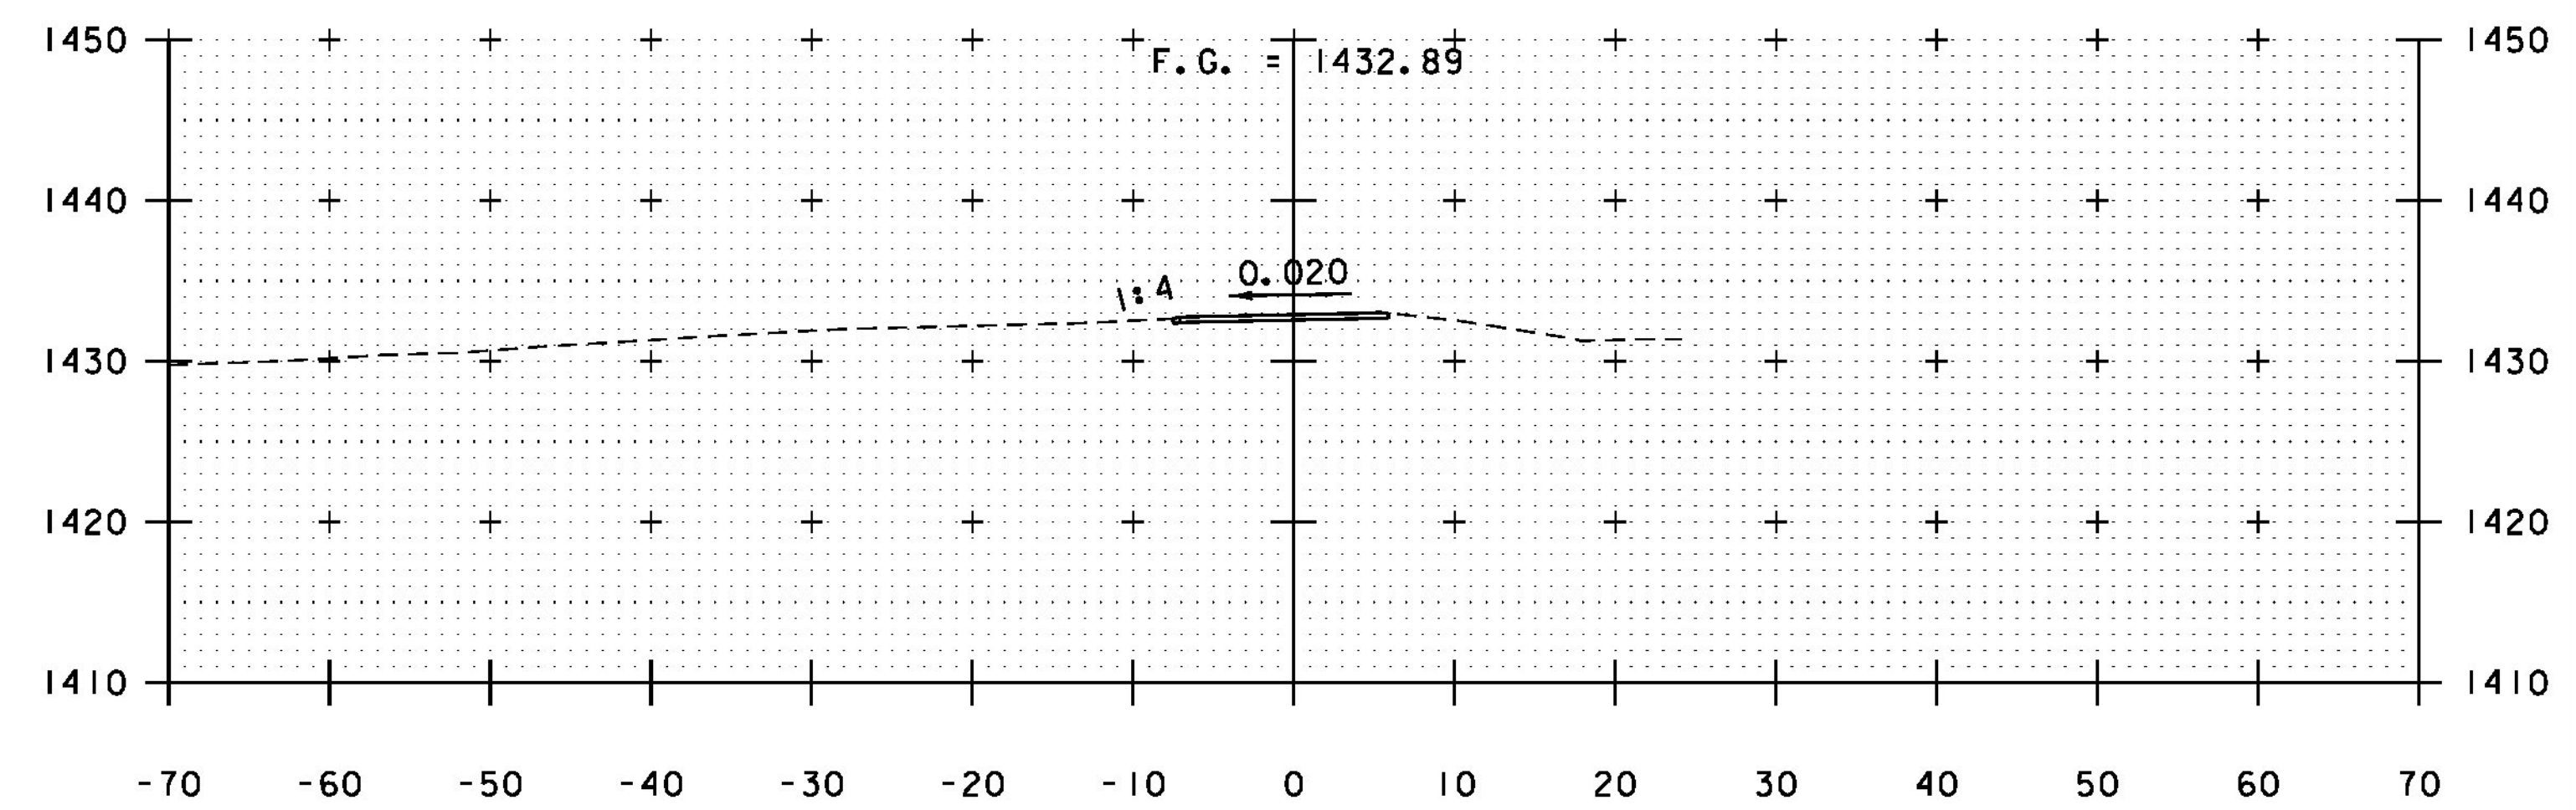

1+75

DRIVEWAY CROSS SECTIONS
STA. 1+00 TO 2+25



PROJECT NAME: WESTON	PLOT DATE: 10/2/2015
PROJECT NUMBER: BF 013-2(13)	DRAWN BY: E.F. LAWES
FILE NAME: z13b076xsl.dgn	CHECKED BY: S.E. BURBANK
PROJECT LEADER: S.E. BURBANK	SHEET 57 OF 68
DESIGNED BY: E.F. LAWES	
DRIVEWAY CROSS SECTIONS (1 OF 4)	