




10+50

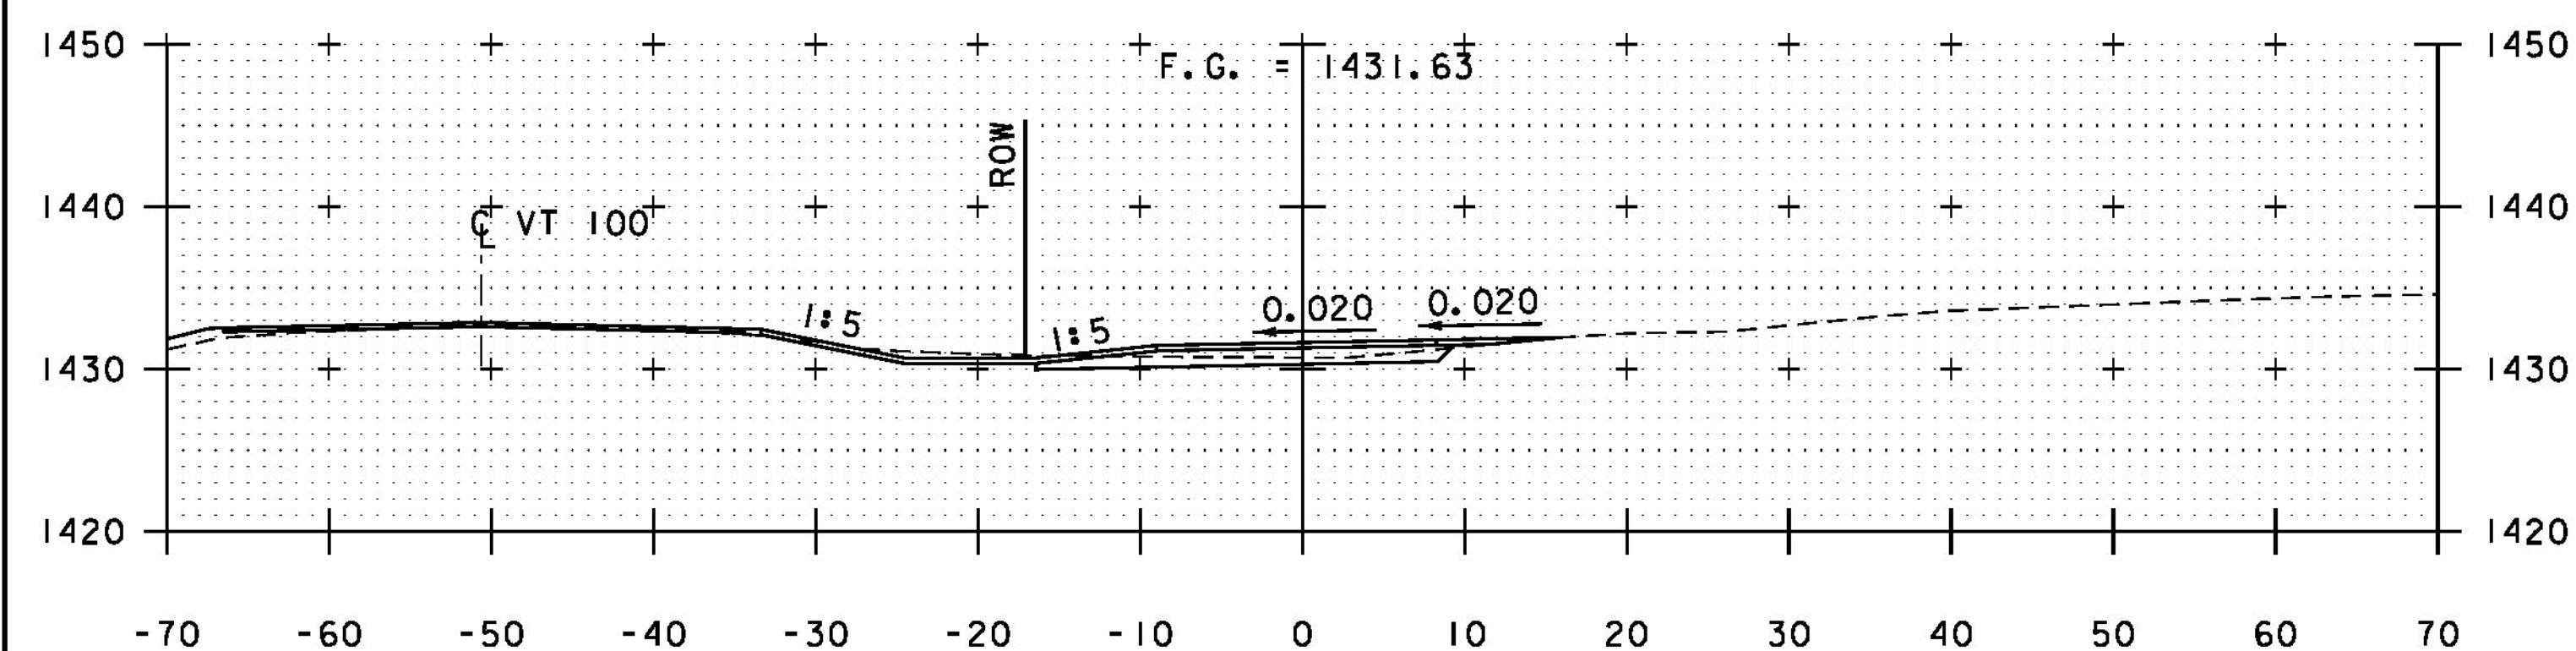


10+25

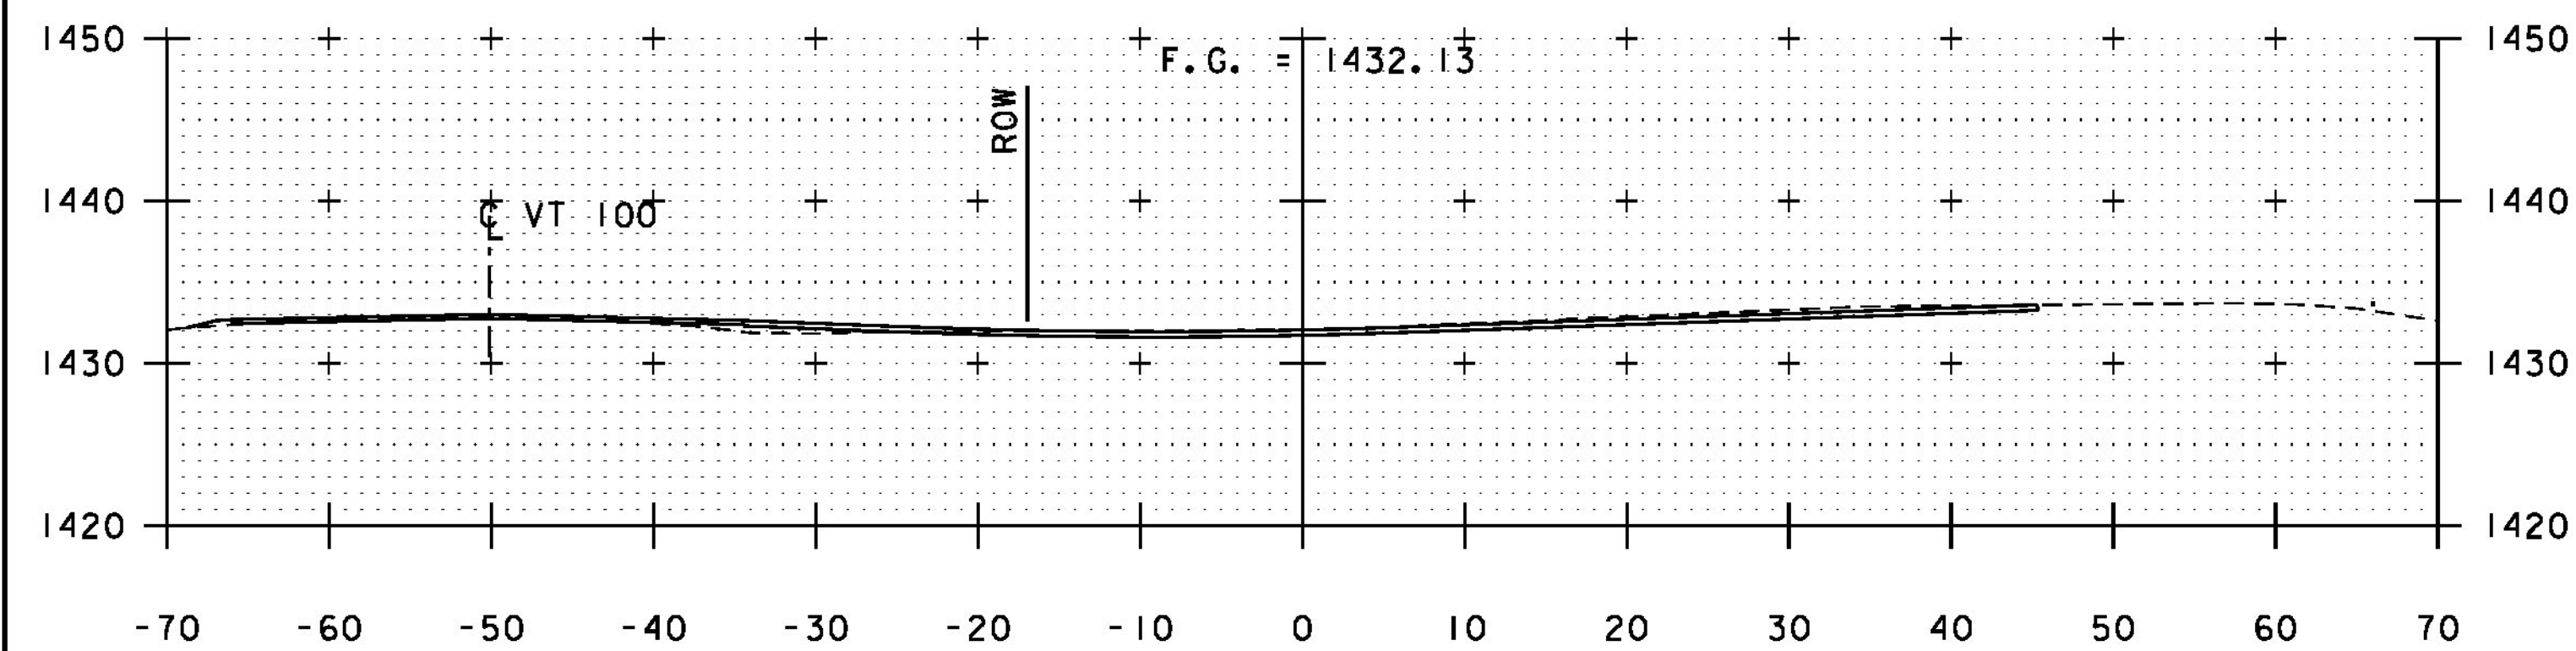


10+00

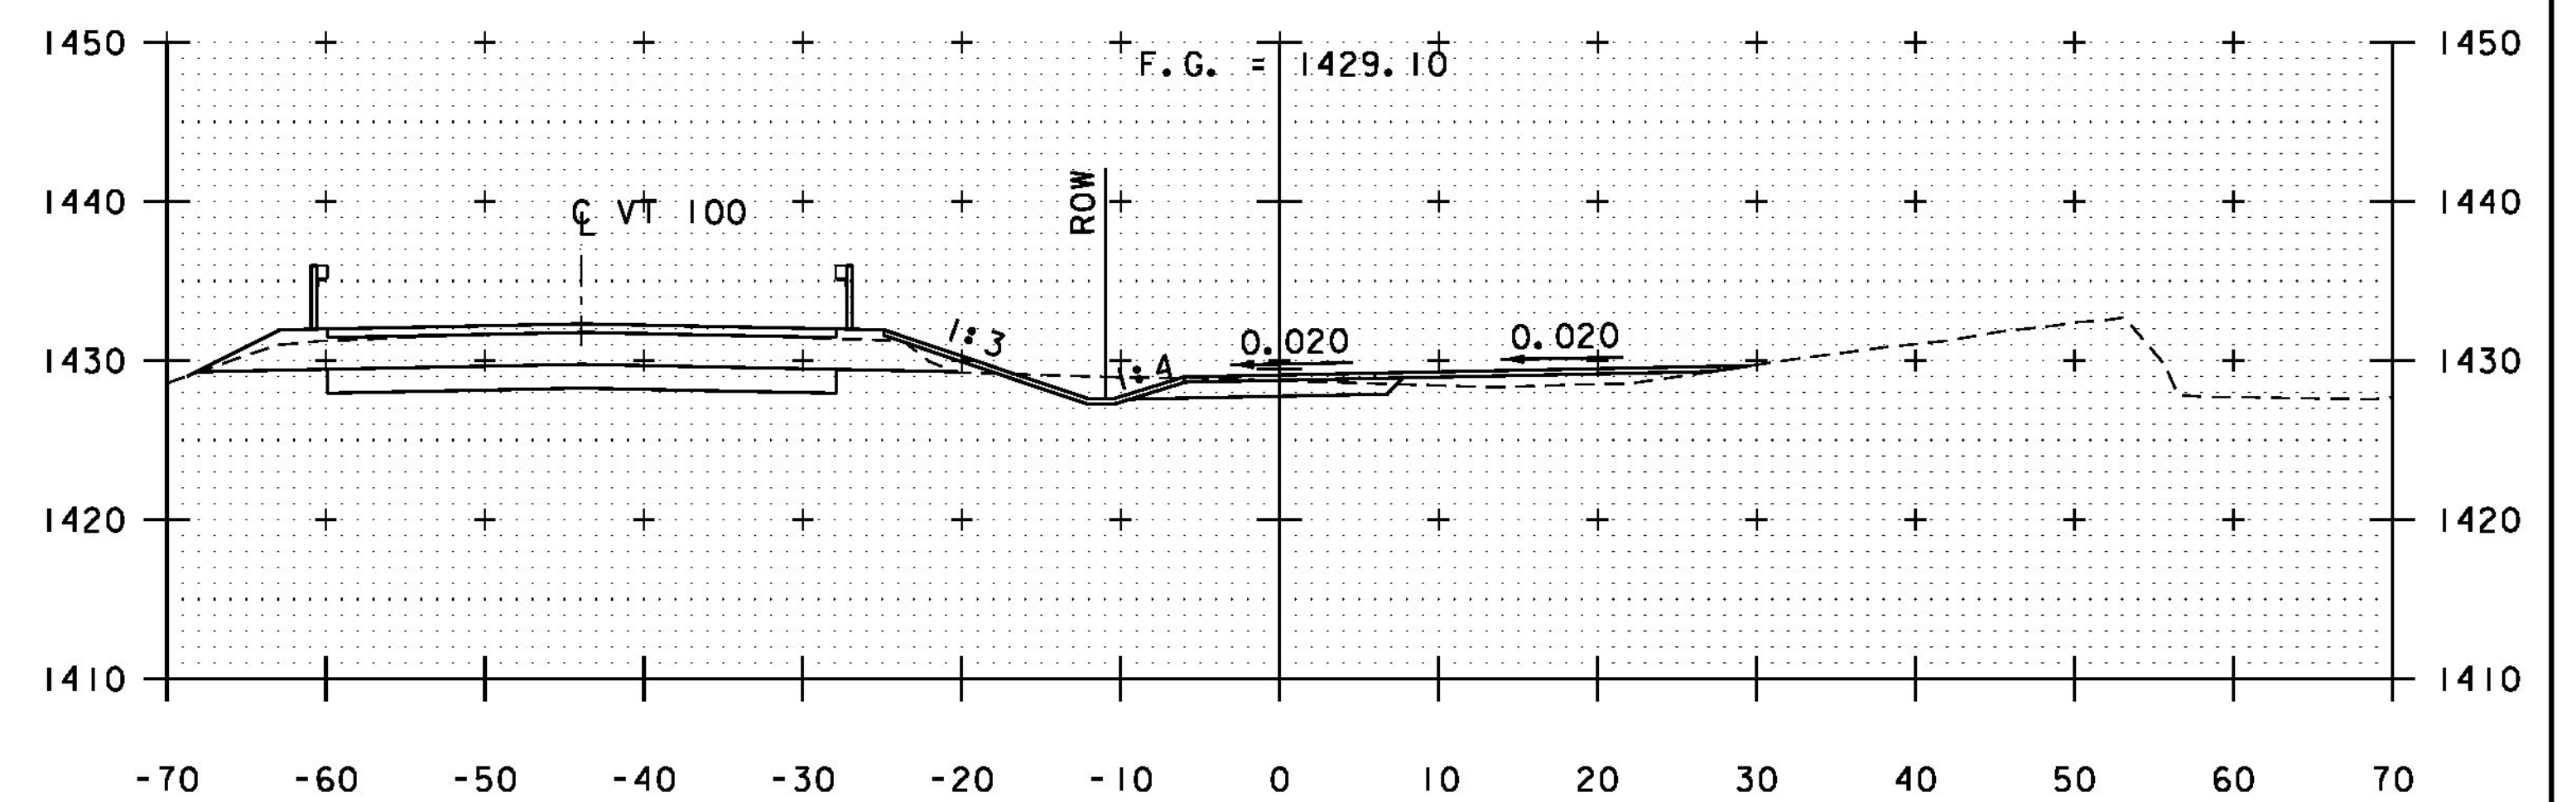

11+25

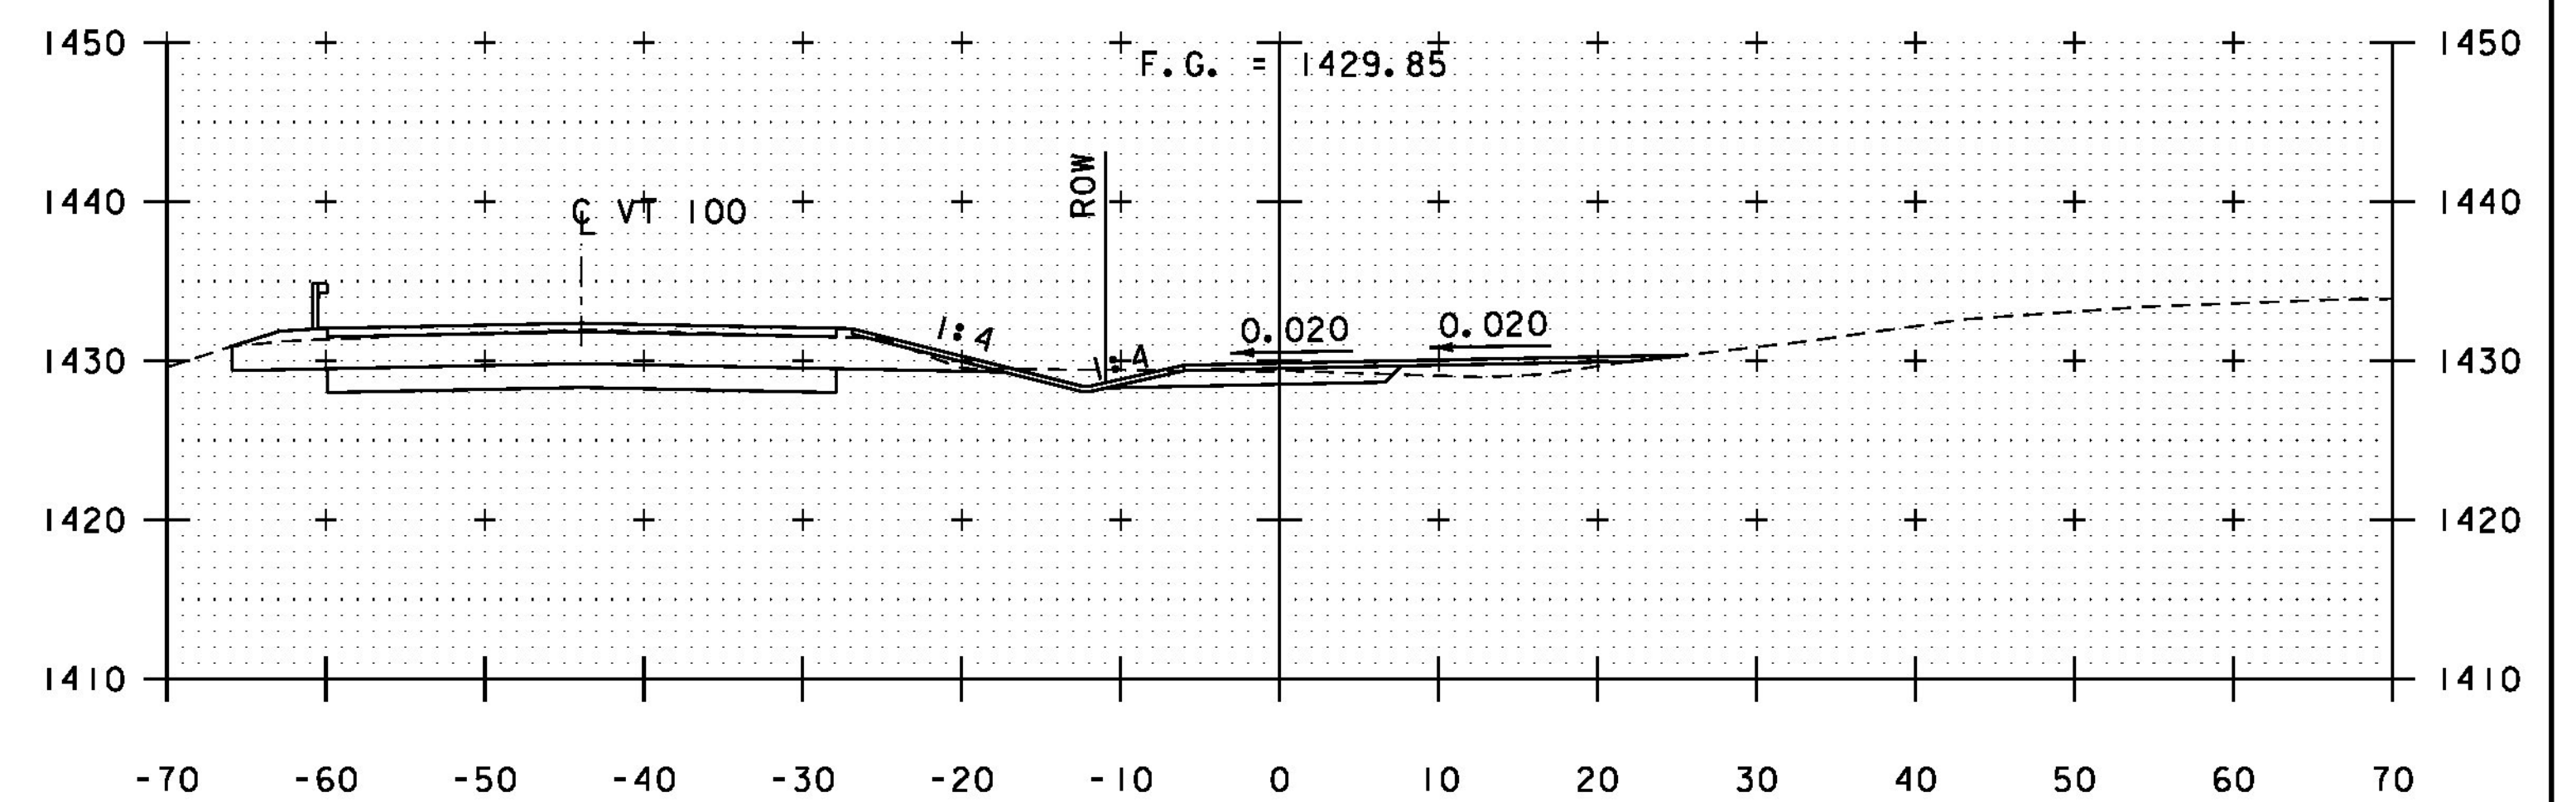

11+00

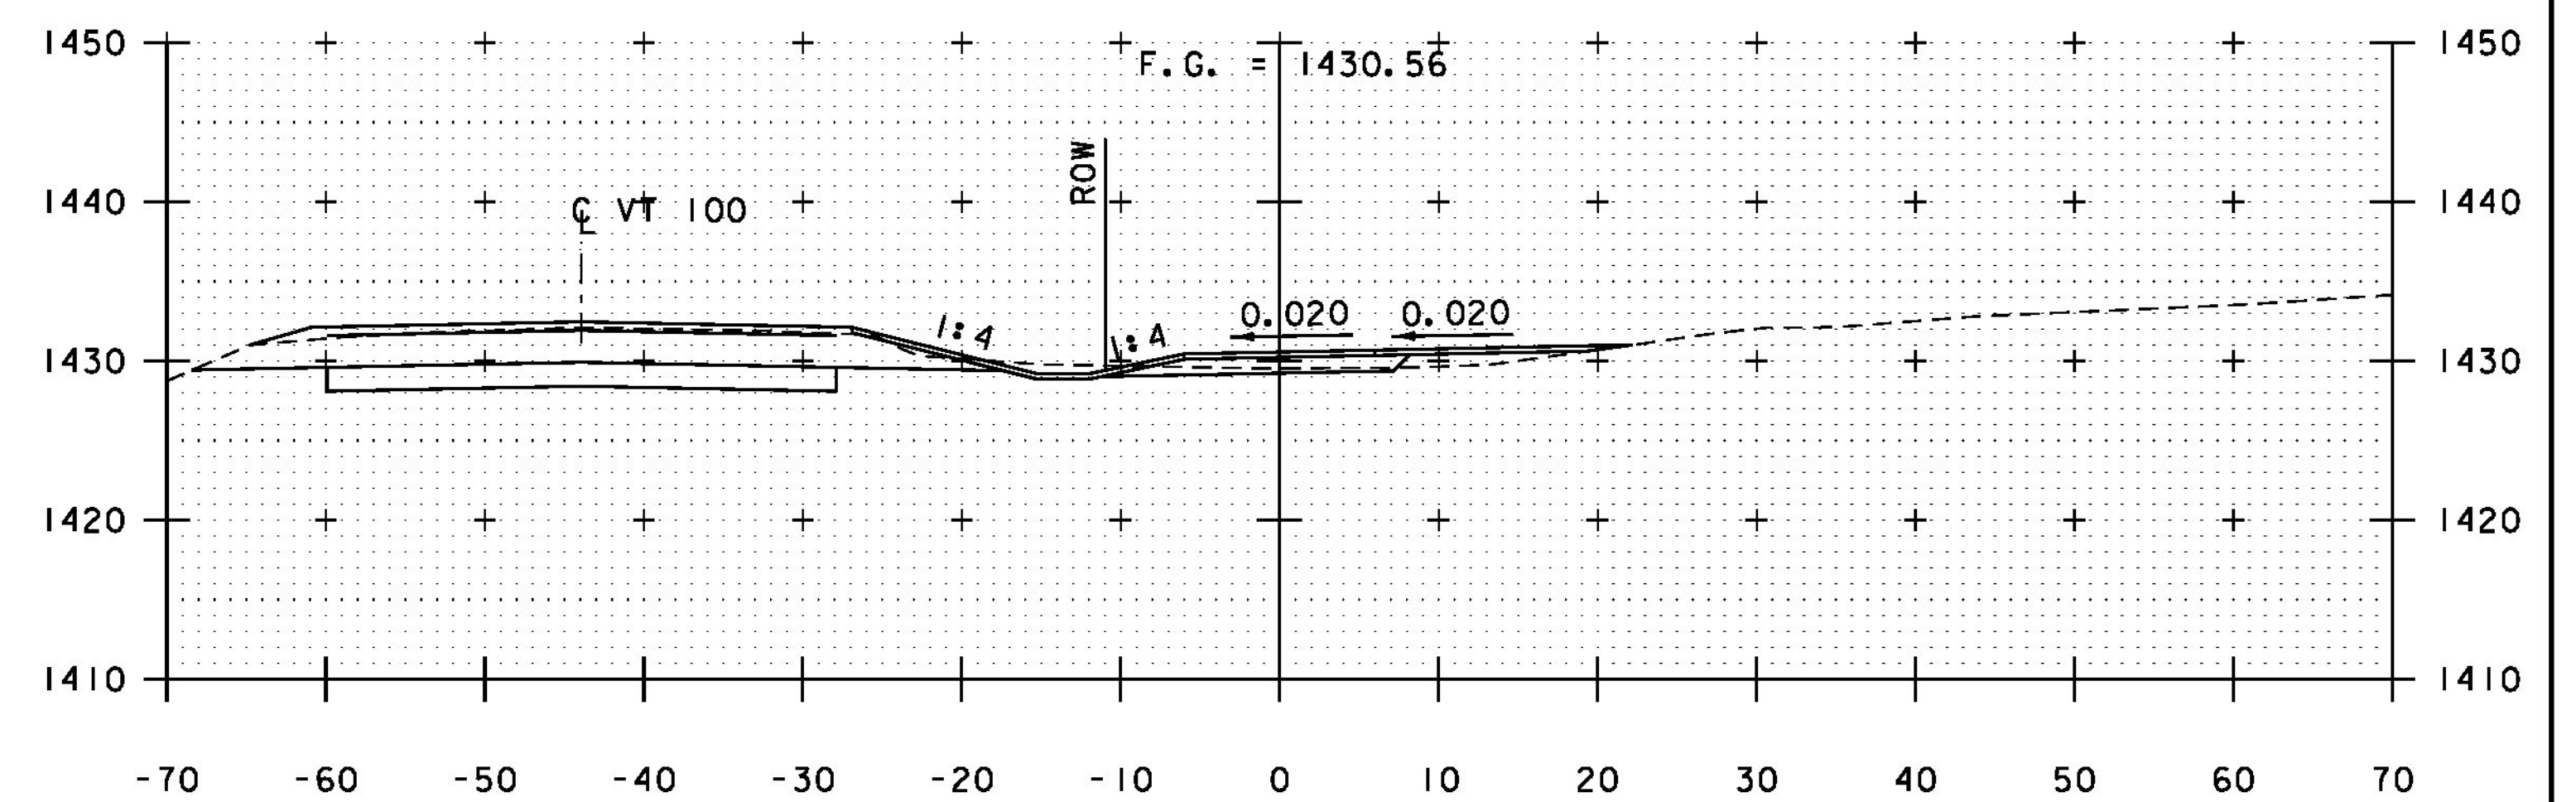

10+75

DRIVEWAY CROSS SECTIONS
STA. 10+00 TO 11+25



PROJECT NAME: WESTON	PLOT DATE: 10/2/2015
PROJECT NUMBER: BF 013-2(13)	DRAWN BY: E.F. LAWES
FILE NAME: z13b076xsl.dgn	CHECKED BY: S.E. BURBANK
PROJECT LEADER: S.E. BURBANK	SHEET 59 OF 68
DESIGNED BY: E.F. LAWES	DRIVEWAY CROSS SECTIONS (3 OF 4)