


11+75



11+50

DRIVEWAY CROSS SECTIONS
STA. 11+50 TO 11+75

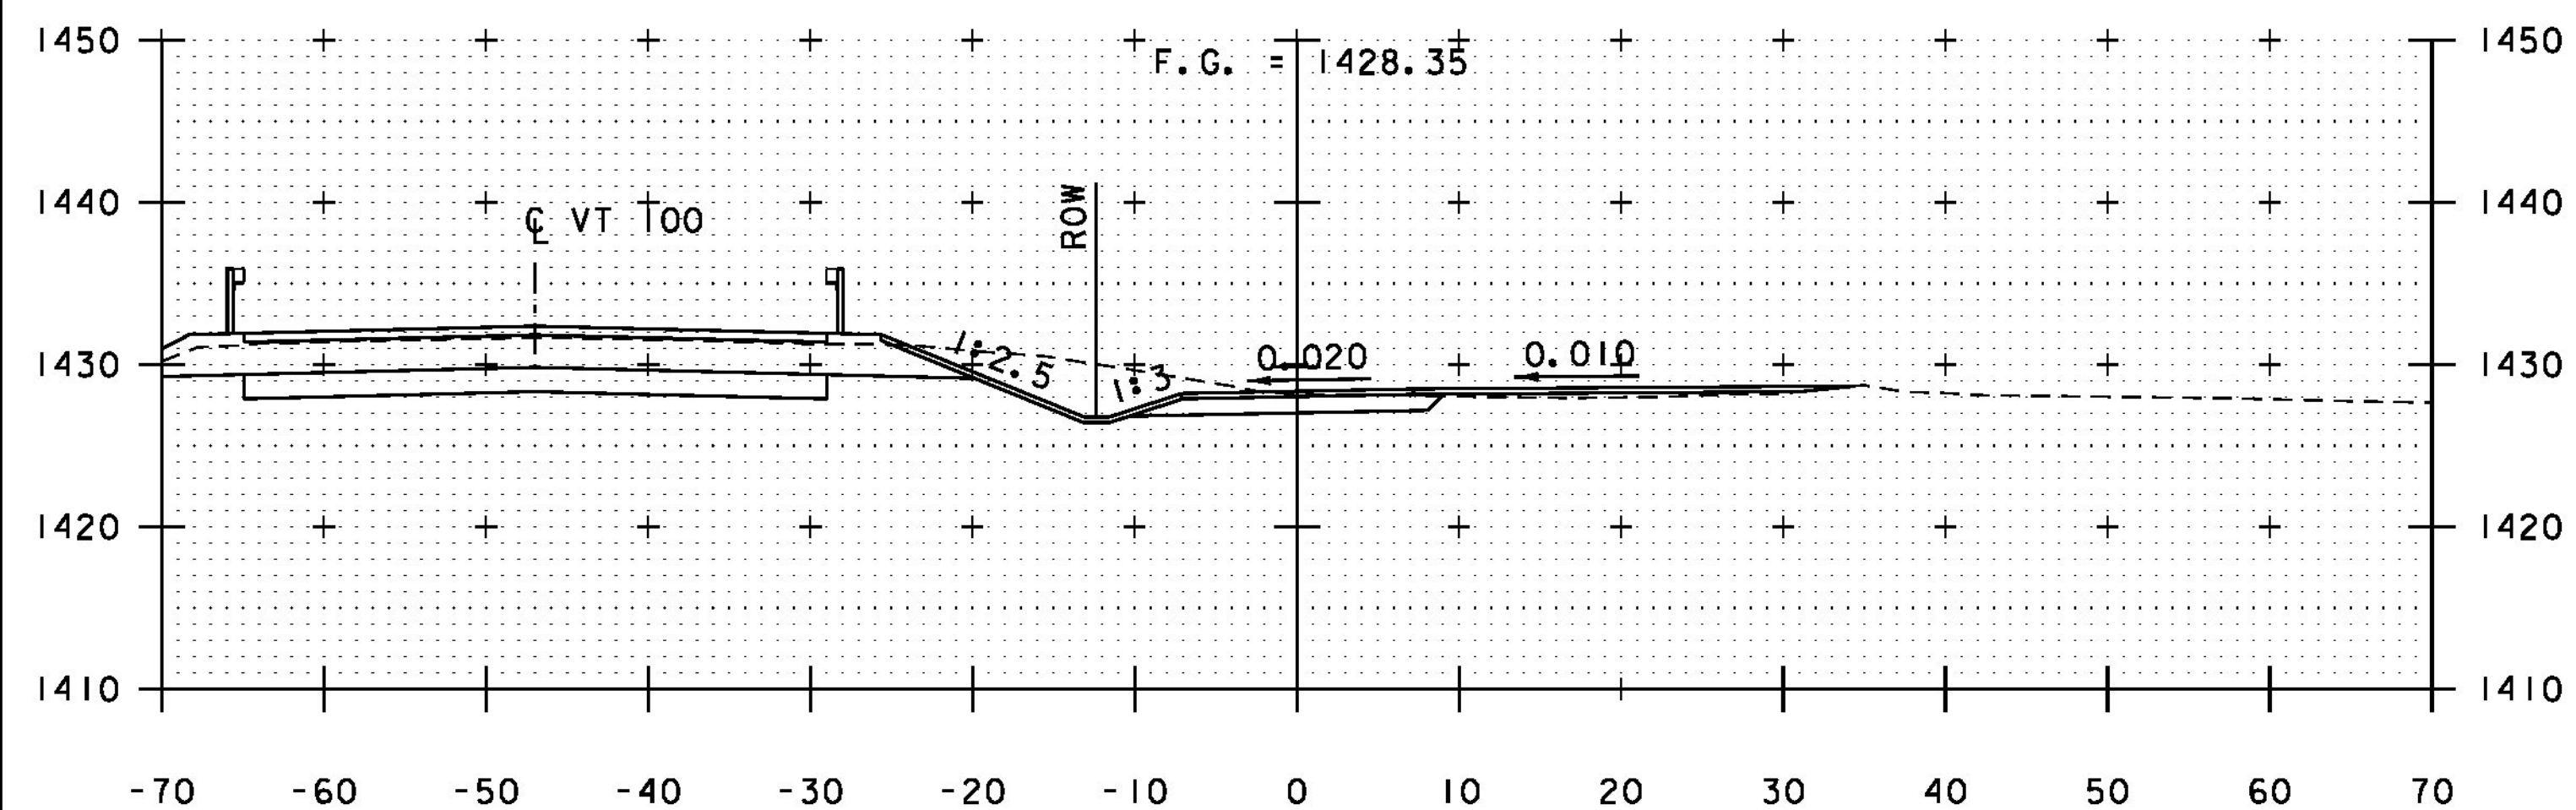

PROJECT NAME: WESTON	PLOT DATE: 10/2/2015
PROJECT NUMBER: BF 013-2(13)	DRAWN BY: E.F. LAWES
FILE NAME: z13b076xsl.dgn	CHECKED BY: S.E. BURBANK
PROJECT LEADER: S.E. BURBANK	SHEET 60 OF 68
DESIGNED BY: E.F. LAWES	DRIVEWAY CROSS SECTIONS (4 OF 4)