

YUENGLING, ROBERT F. & CHRISTINE M.

BENCHMARK
RAILROAD SPIKE IN POLE
ELEV = 1431.77


SOIL CLASSIFICATION
PODUNK FINE SANDY LOAM,
OCCASIONALLY FLOODED
0%-3% SLOPES
MODERATE EROSION POTENTIAL
K = 0.32

PROCTOR, BEVERLEY J.

BEGIN APPROACH
STA. 286+50.00

BEGIN BRIDGE
STA. 288+03.58
FG EL 1432.64

END APPROACH
STA. 291+35.00

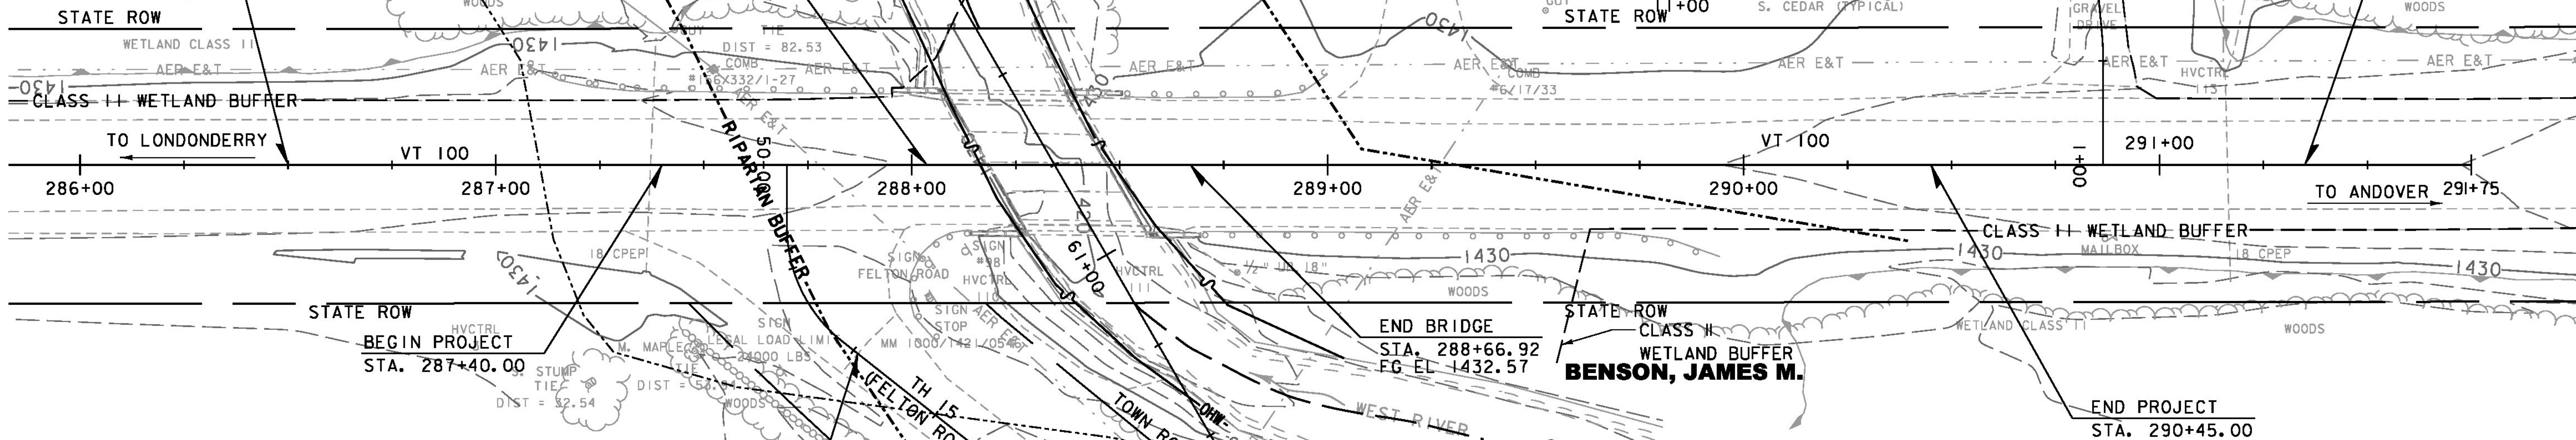


HART, DONALD W. & MARIE W.

SOIL CLASSIFICATION
COLTON FINE SANDY LOAM
3%-8% SLOPES
LOW EROSION POTENTIAL
K = 0.17

PROBST JR., FREDERICK J. & PROBST, JENNIFER L.

LIMIT OF PAVEMENT
STA. 50+51.31

LIMITS OF WORK
STA. 51+41.51

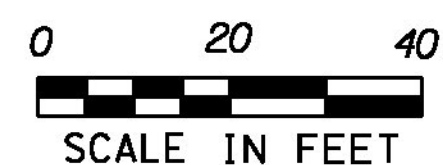

SEE SHEET 12 FOR CONVENTIONAL SYMBOLGY LEGEND.

PROJECT NAME:	WESTON
PROJECT NUMBER:	BF 013-2(13)
FILE NAME:	z13b076bdr_ero.dgn
PROJECT LEADER:	S.E. BURBANK
DESIGNED BY:	J.J. WESTCOTT
EPSC EXISTING CONDITIONS SHEET	
PLOT DATE:	10/2/2015
DRAWN BY:	J.J. WESTCOTT
CHECKED BY:	S.E. BURBANK
SHEET	64 OF 68

