


# 23477  
 DATE: 5/9/16  
 12CH. SWR

WESTON  
 APPROACH SLAB W-AS4 (1) -  
 "AS-BUILT" DIMENSIONS

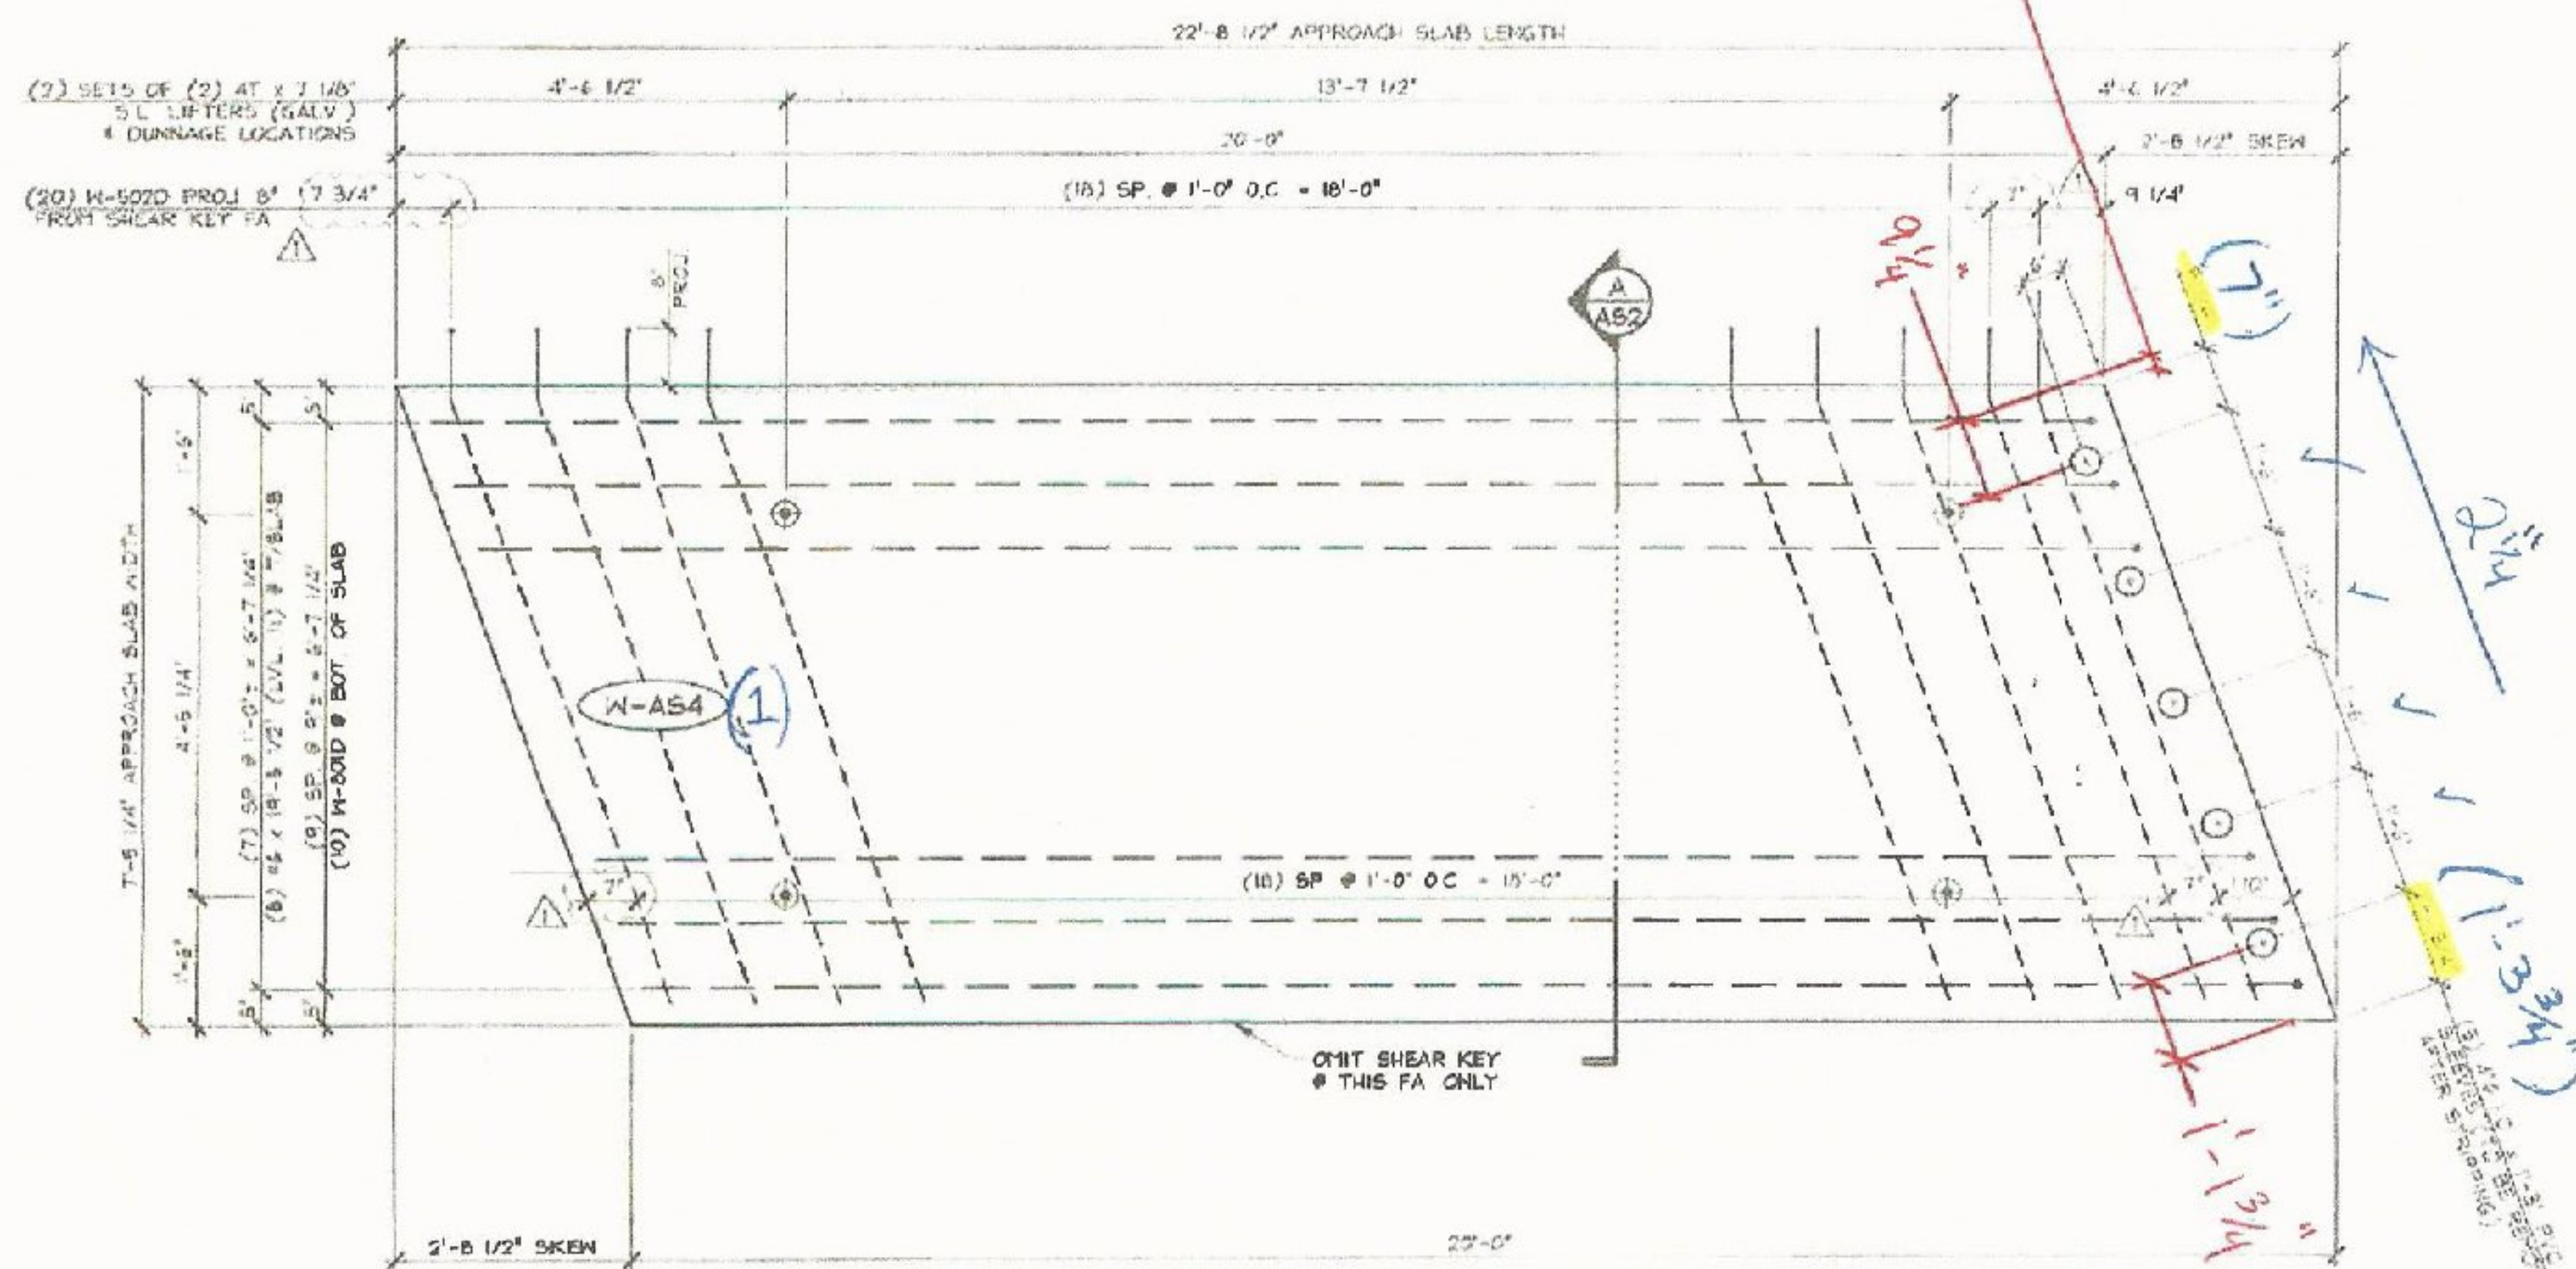

3 DIMENSIONAL PLAN VIEW IN FORM - "W-AS4"  
 AS2 1/2" = 1'-0"