


RECEIVED
 ON: March 30, 2016
 and Checked for
CONFORMAN
 BY: Jennifer Fitch DATE: 04/

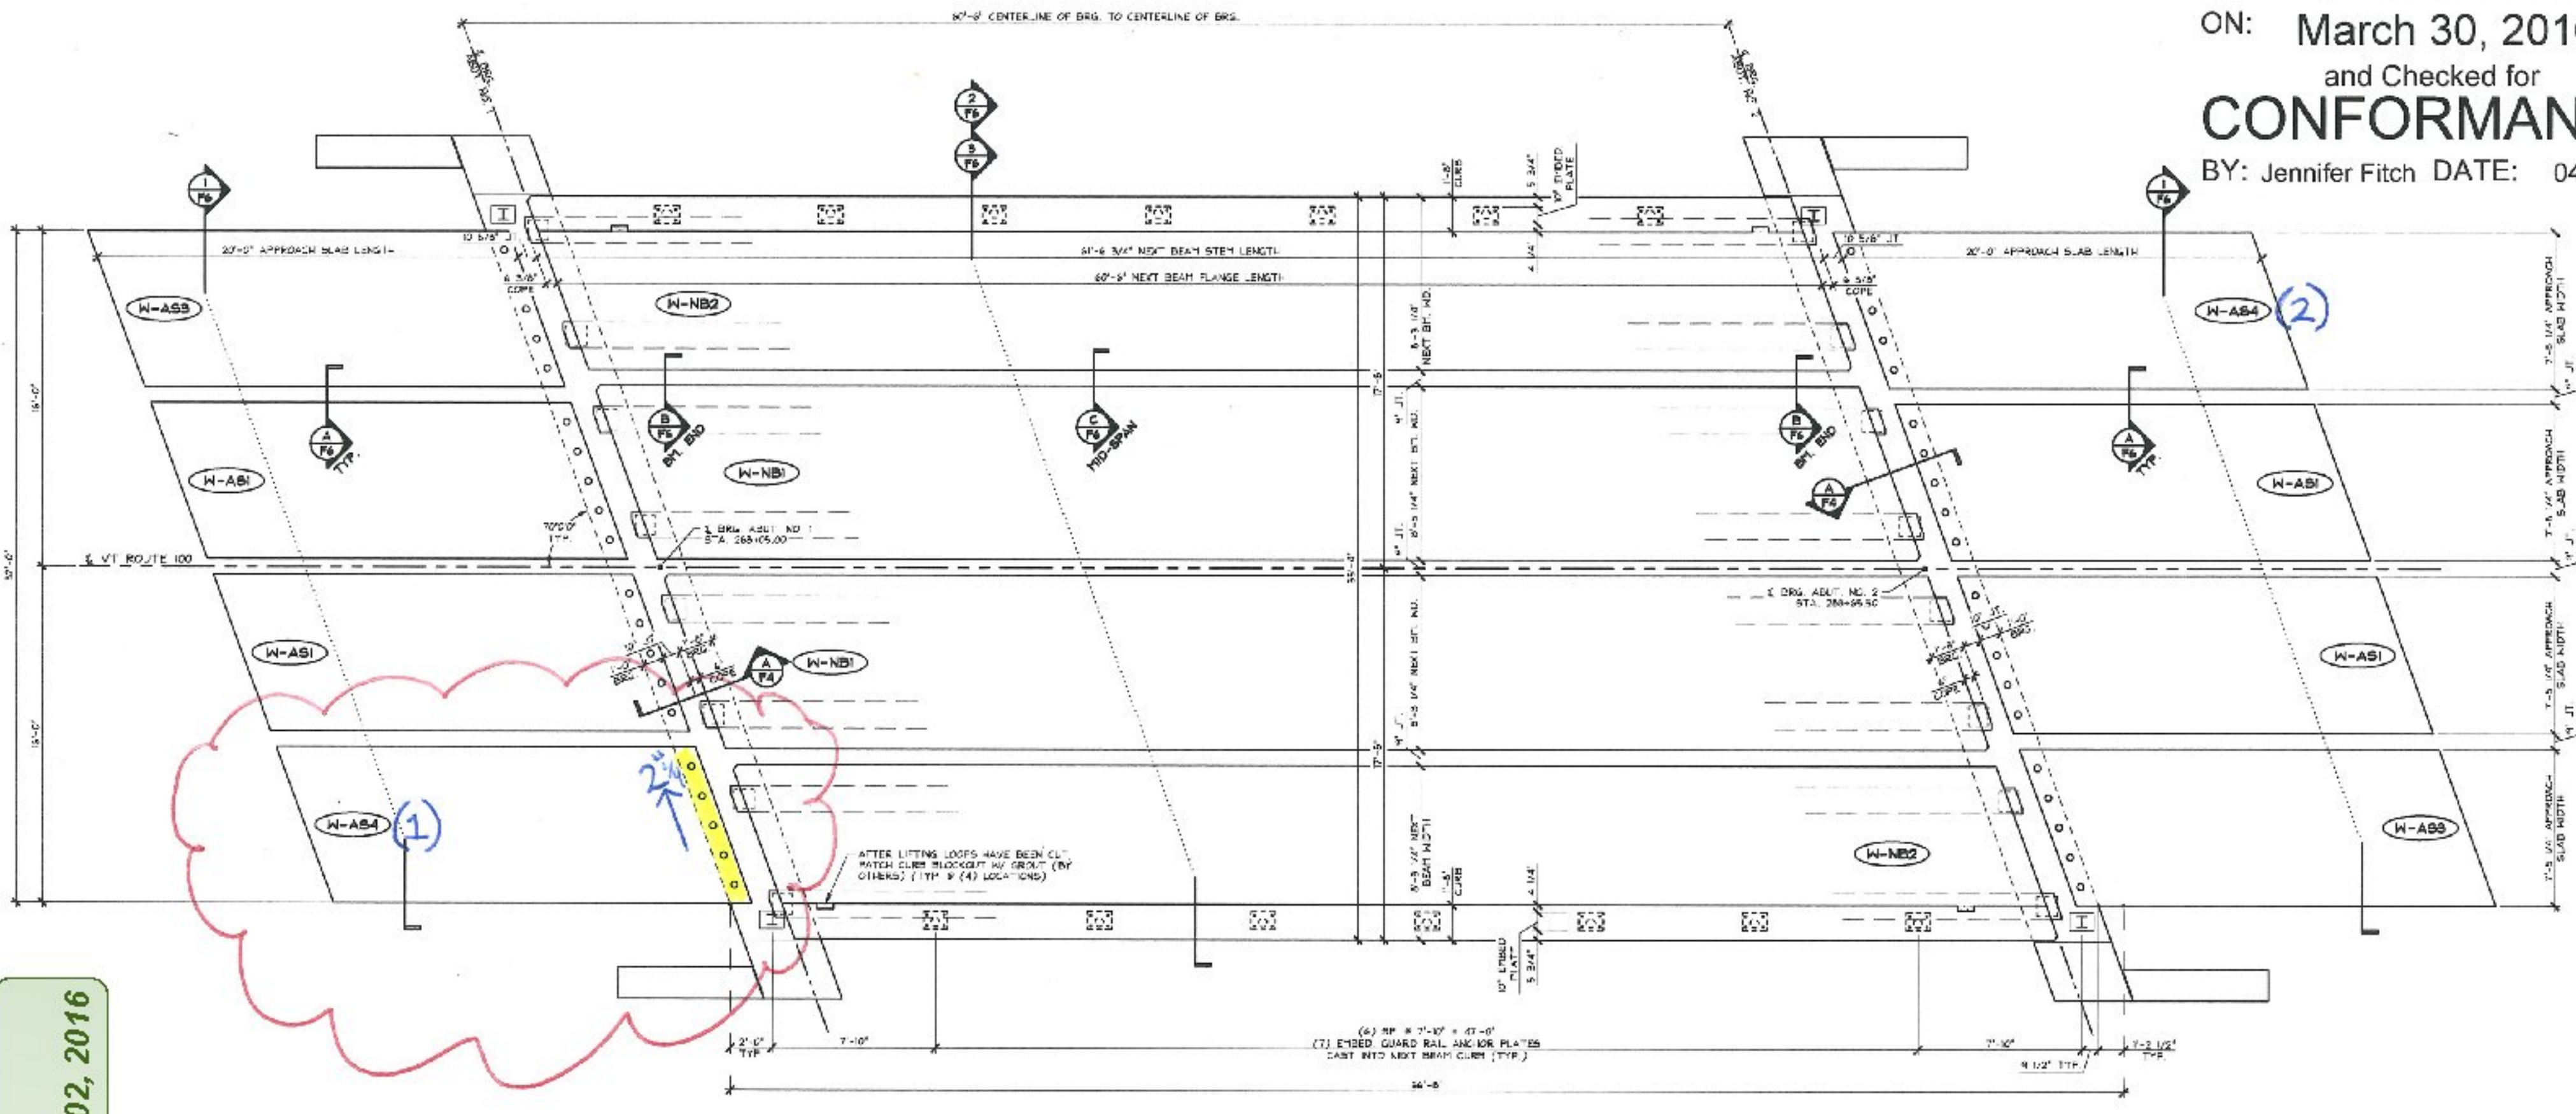

1 PRESTRESSED NEXT BEAM LAYOUT & PRECAST APPROACH SLAB LAYOUT
 F5 1/4\"/>

APPROVED
 By Jim Wild at 8:42 am, Jun 02, 2016