


**INDEX OF SHEETS**

- 1 TITLE SHEET
- 2 PROJECT NOTES
- 3-4 PROJECT STANDARD DETAILS
- 5-6 QUANTITY SHEETS
- 7-9 TRAFFIC CONTROL SHEETS
- 10-11 REFERENCE SHEETS BRIDGE 2
- 12-14 REFERENCE SHEETS BRIDGE 13E&W

**STANDARD SHEETS**


- T-1 08-06-2012
- T-10 08-06-2012
- T-11 08-06-2012
- T-12 08-06-2012
- T-13 08-06-2012

# STATE OF VERMONT AGENCY OF TRANSPORTATION

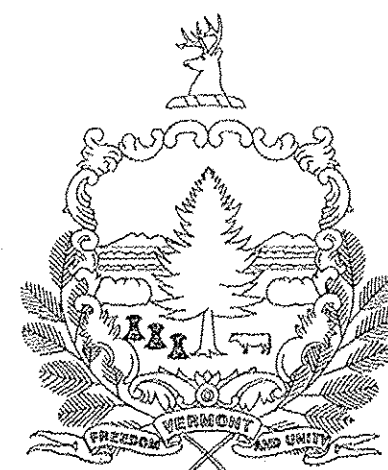

## PROPOSED IMPROVEMENT BRIDGE PROJECT

CASTLETON-WEST RUTLAND  
COUNTY OF RUTLAND  
THREE BRIDGES ON OR OVER US ROUTE 4

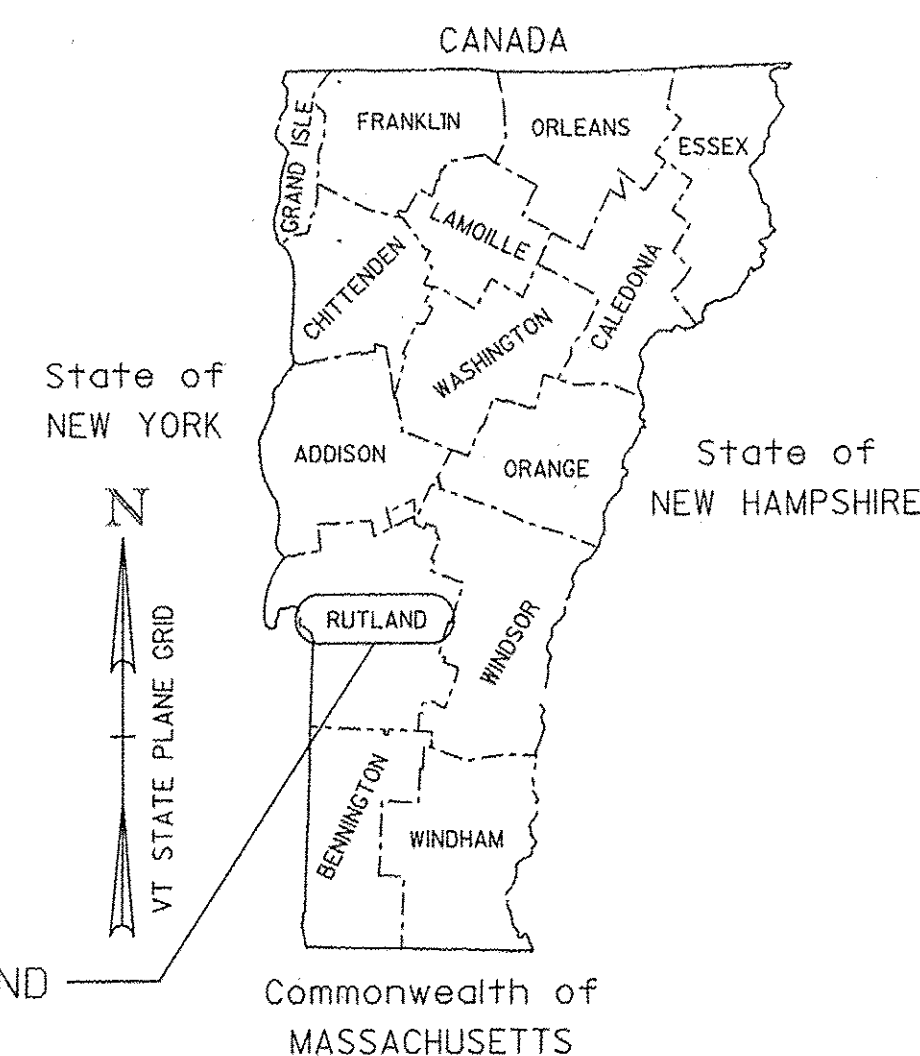


CASTLETON-WEST RUTLAND  
BF BPNT (15)

**LOCATION MAP**  
NOT TO SCALE

RECORD PLANS	
CONTRACTOR:	MODERN PROTECTIVE COATINGS - HUDSON, NH
RESIDENT ENGINEER:	TIM POCKETTE
CONSTRUCTION BEGAN:	MAY 18, 2015
CONSTRUCTION COMPLETE:	SEPTEMBER 28, 2015
RECORD PLANS BY:	TIM POCKETTE & AARON JAMES
I HEREBY CERTIFY THAT ALL THE CONSTRUCTION REQUIRED BY THIS SET OF DRAWINGS HAS BEEN ACCOMPLISHED AS INDICATED HEREIN.	
BY:	RESIDENT ENGINEER
DATE:	09-12-2016
NOTE: Any further information concerning final quantities, amounts or other details relative to this project may be found at Central Files in the electronic archives.	

**PROJECT LOCATION:** CASTLETON BR 2 (NSH 9150 [CASTLETON STATE HIGHWAY] OVER US ROUTE 4) (US ROUTE 4 MM 0.76)  
WEST RUTLAND BR 13E (US ROUTE 4 OVER CLARENDON PITTSFORD RAILROAD) (MM 12.95)  
WEST RUTLAND BR 13W (US ROUTE 4 OVER CLARENDON PITTSFORD RAILROAD) (MM 12.95)

**PROJECT DESCRIPTION:** THIS PROJECT INVOLVES CLEANING, LEAD PAINT REMOVAL AND REPAINTING THE EXISTING STEEL SUPERSTRUCTURE MEMBERS AND ASSOCIATED WORK.

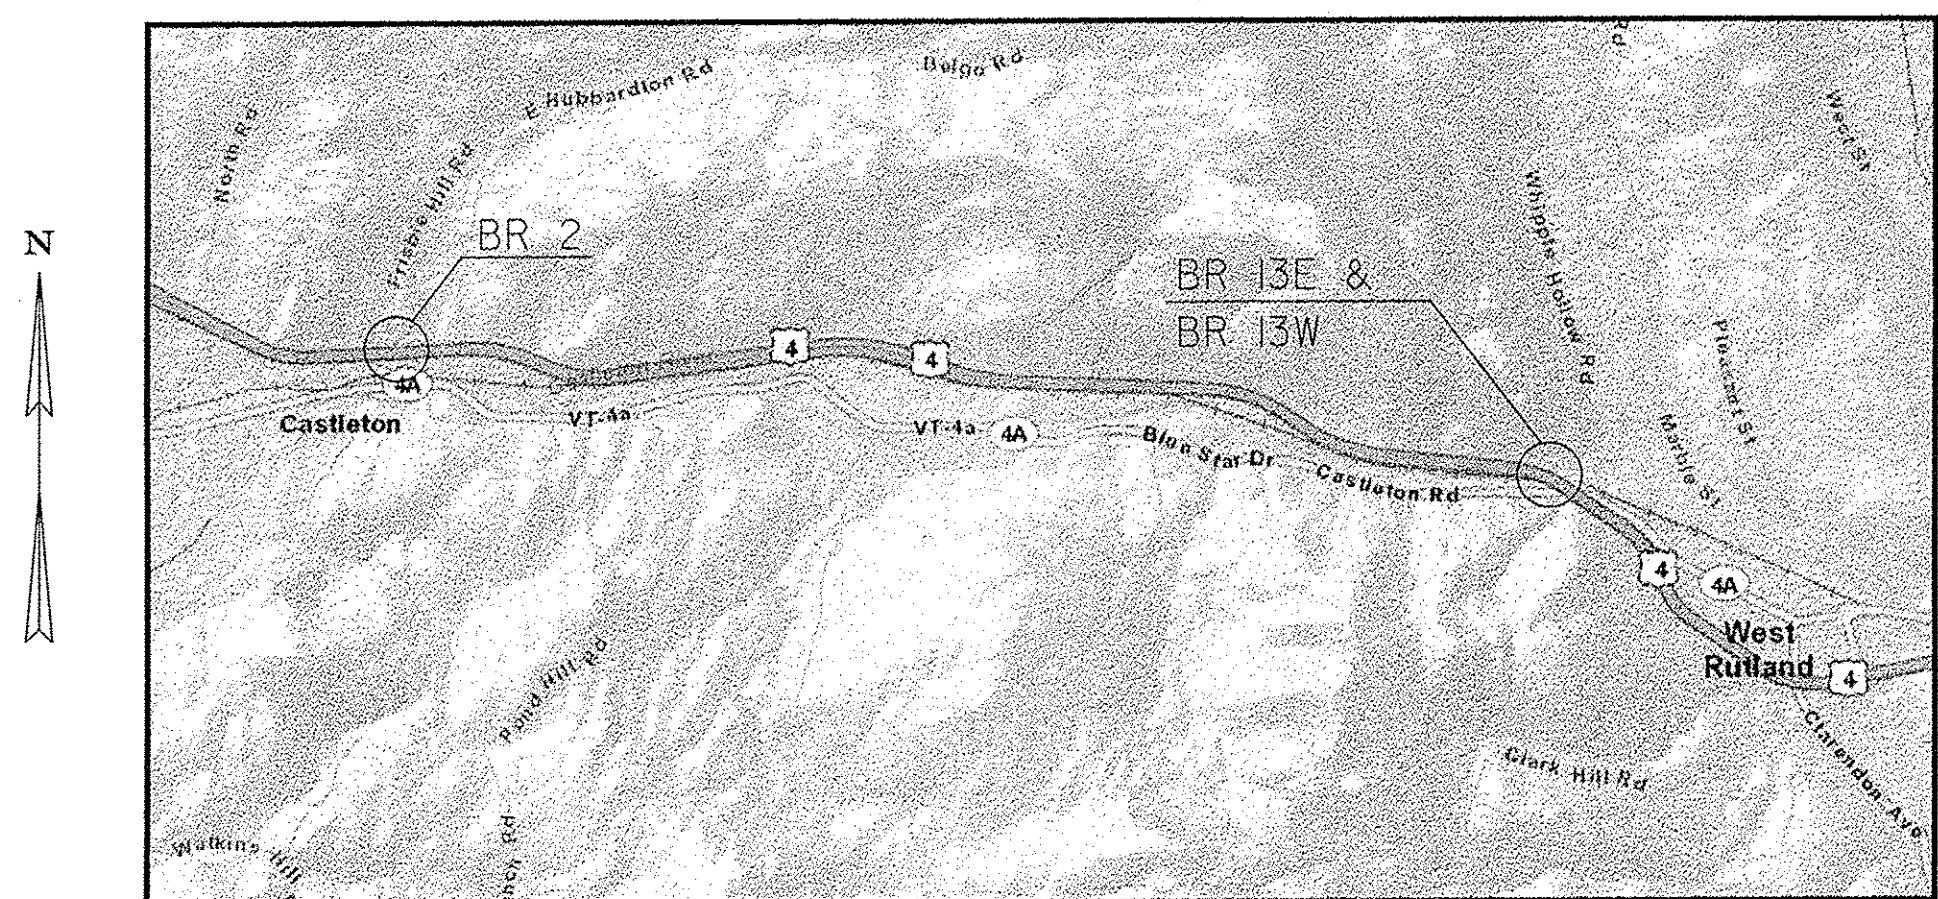


**PROJECT LIMITS PLAN**  
NOT TO SCALE

CONSTRUCTION IS TO BE CARRIED ON IN ACCORDANCE WITH THESE PLANS AND THE STANDARD SPECIFICATIONS FOR CONSTRUCTION DATED 2011, AS APPROVED BY THE FEDERAL HIGHWAY ADMINISTRATION ON JULY 20, 2011 FOR USE ON THIS PROJECT, INCLUDING ALL SUBSEQUENT REVISIONS AND SUCH REVISED SPECIFICATIONS AND SPECIAL PROVISIONS AS ARE INCORPORATED IN THESE PLANS.

QUALITY ASSURANCE PROGRAM : LEVEL 3	
SURVEYED BY :	N/A
SURVEYED DATE :	N/A
DATUM	
VERTICAL	N/A
HORIZONTAL	N/A

**BUILT AS DESIGNED**

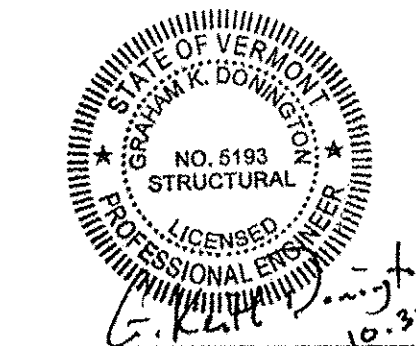

**PB** PARSONS BRINCKERHOFF  
650 ELM STREET  
MANCHESTER, NH 03101

DIRECTOR OF PROJECT DELIVERY	
APPROVED	DATE 11/16/14
PROJECT MANAGER : MARK SARGENT	
PROJECT NAME : CASTLETON-WEST RUTLAND	
PROJECT NUMBER : BF BPNT (15)	
SHEET 1 OF 14 SHEETS	