

**CURVE DATA**  
 EASTBOUND WESTBOUND  
 $\Delta 33^{\circ}17'11''$  RR  $\Delta 33^{\circ}59'06''$  RT  
 $D 3'$   $D 2^{\circ}30'$   
 BANK  $1/8''/ft$  BANK  $3/4''/ft$

**BASELINE**  
 $\Delta 33^{\circ}59' RT$   
 $D 3^{\circ}30'$

**LIST OF BRIDGE SHEETS**

BR 100	PLAN & ELEVATION
BR 101-102	BRIDGE QUANTITY SHEETS
BR 103	PRELIMINARY INFORMATION SHEET
BR 104-105	BORINGS
BR 106-107	RAILING, CURB, & FRAMING PLANS
BR 108-112	ABUTMENTS #1, #2, #3, #4
BR 113-118	PIERS #1 THRU #8
BR 119-122	APPROACH SLABS #1 THRU #4
BR 123-125	RETAINING WALLS
BR 126-131	REINFORCING STEEL SHEETS
BR 132-134	CHANNEL SECTIONS

**STANDARD SHEETS**

SCB-30-65	SB-R1-64 (3H. 142)
SB-R2-65	SCB-D1 THRU D7-65

**GENERAL NOTES**

- ALL 12BP53 STEEL PILES SHALL BE DRIVEN TO A BEARING CAPACITY OF 45 TONS PER PILE.
- ELEVATION DATUM IS SEA LEVEL BASED ON NEAREST U.S. GOVERNMENT VERTICAL CONTROL.
- FOR ADDITIONAL GENERAL NOTES SEE SCB-D1-65.
- APPROACH SLABS SHALL BE CONSTRUCTED AS PART OF STAGE 3 CONSTRUCTION.
- IF ROCK FILL IS NOT AVAILABLE, USE ITEM 204 (1" THICK) FOR SLOPE PROTECTION UNDER BRIDGES AT ABUT. #1 & #3.
- EASTBOUND BRIDGE SHALL BE POSITIONED FROM PIER 6. THE E OF PIER 6 SHALL BE AT THE INTERSECTION OF E.B. LANE AND D.H. RR. A PRELIMINARY FIELD CHECK WAS MADE PRIOR TO DESIGN. A FINAL FIELD CHECK SHOULD BE MADE OF THIS INTERSECTION, AND PIER LOCATION REVISED IF NECESSARY.
- ITEM 505, PILE LOADING TESTS, ARE TO BE USED WHEN IN THE OPINION OF THE ENGINEER, THE DESIGNED LOAD CARRYING CAPACITY MAY NOT BE ACHIEVED.

**Design Allowable stresses**  
 Concrete  $f_c = 3000$  P.S.I.  $f_c = 1200$  P.S.I.  
 Structural Steel  $f_s = 20,000$  P.S.I.  
 Reinforcing Steel  $f_s = 20,000$  P.S.I. Tension  
 16,000 P.S.I. Compression


**Design Notes**

- Construction clearance is to be 8'-0" horizontally from Q of R.R. track.
- Minimum horizontal clearance after construction is to be 12'-0" from Q of R.R. Track above track elevation.
- Minimum vertical clearance during construction is to be 18'-0".
- Minimum vertical clearance after construction is to be 22'-0" as per A.R.R.A. Standard clearance diagram.


**STATE OF VERMONT**  
 DEPARTMENT OF HIGHWAYS

PROJECT --- WEST RUTLAND ---  
 TOWN OF --- WEST RUTLAND ---  
 ROUTE NO. 113-E STA. 487+10  
 U.S. 4 OVER D & H RAILROAD &  
 CASTLETON RIVER  
 SCALE --- 1" = 20' ---  
 IN CHARGE --- W. SMITH ---  
 DRAWN BY --- [unclear] --- CHECKED BY --- W. SMITH ---  
 PROJECT NO. 82039-1(1) ---  
 SHEET 91 OF 357 BB-102

CASTLETON - WEST RUTLAND  
 BF BPNT (15)  
 PROJECT BRIDGE 13E&W  
 SHEET 12 OF 14  
 FOR INFORMATION ONLY

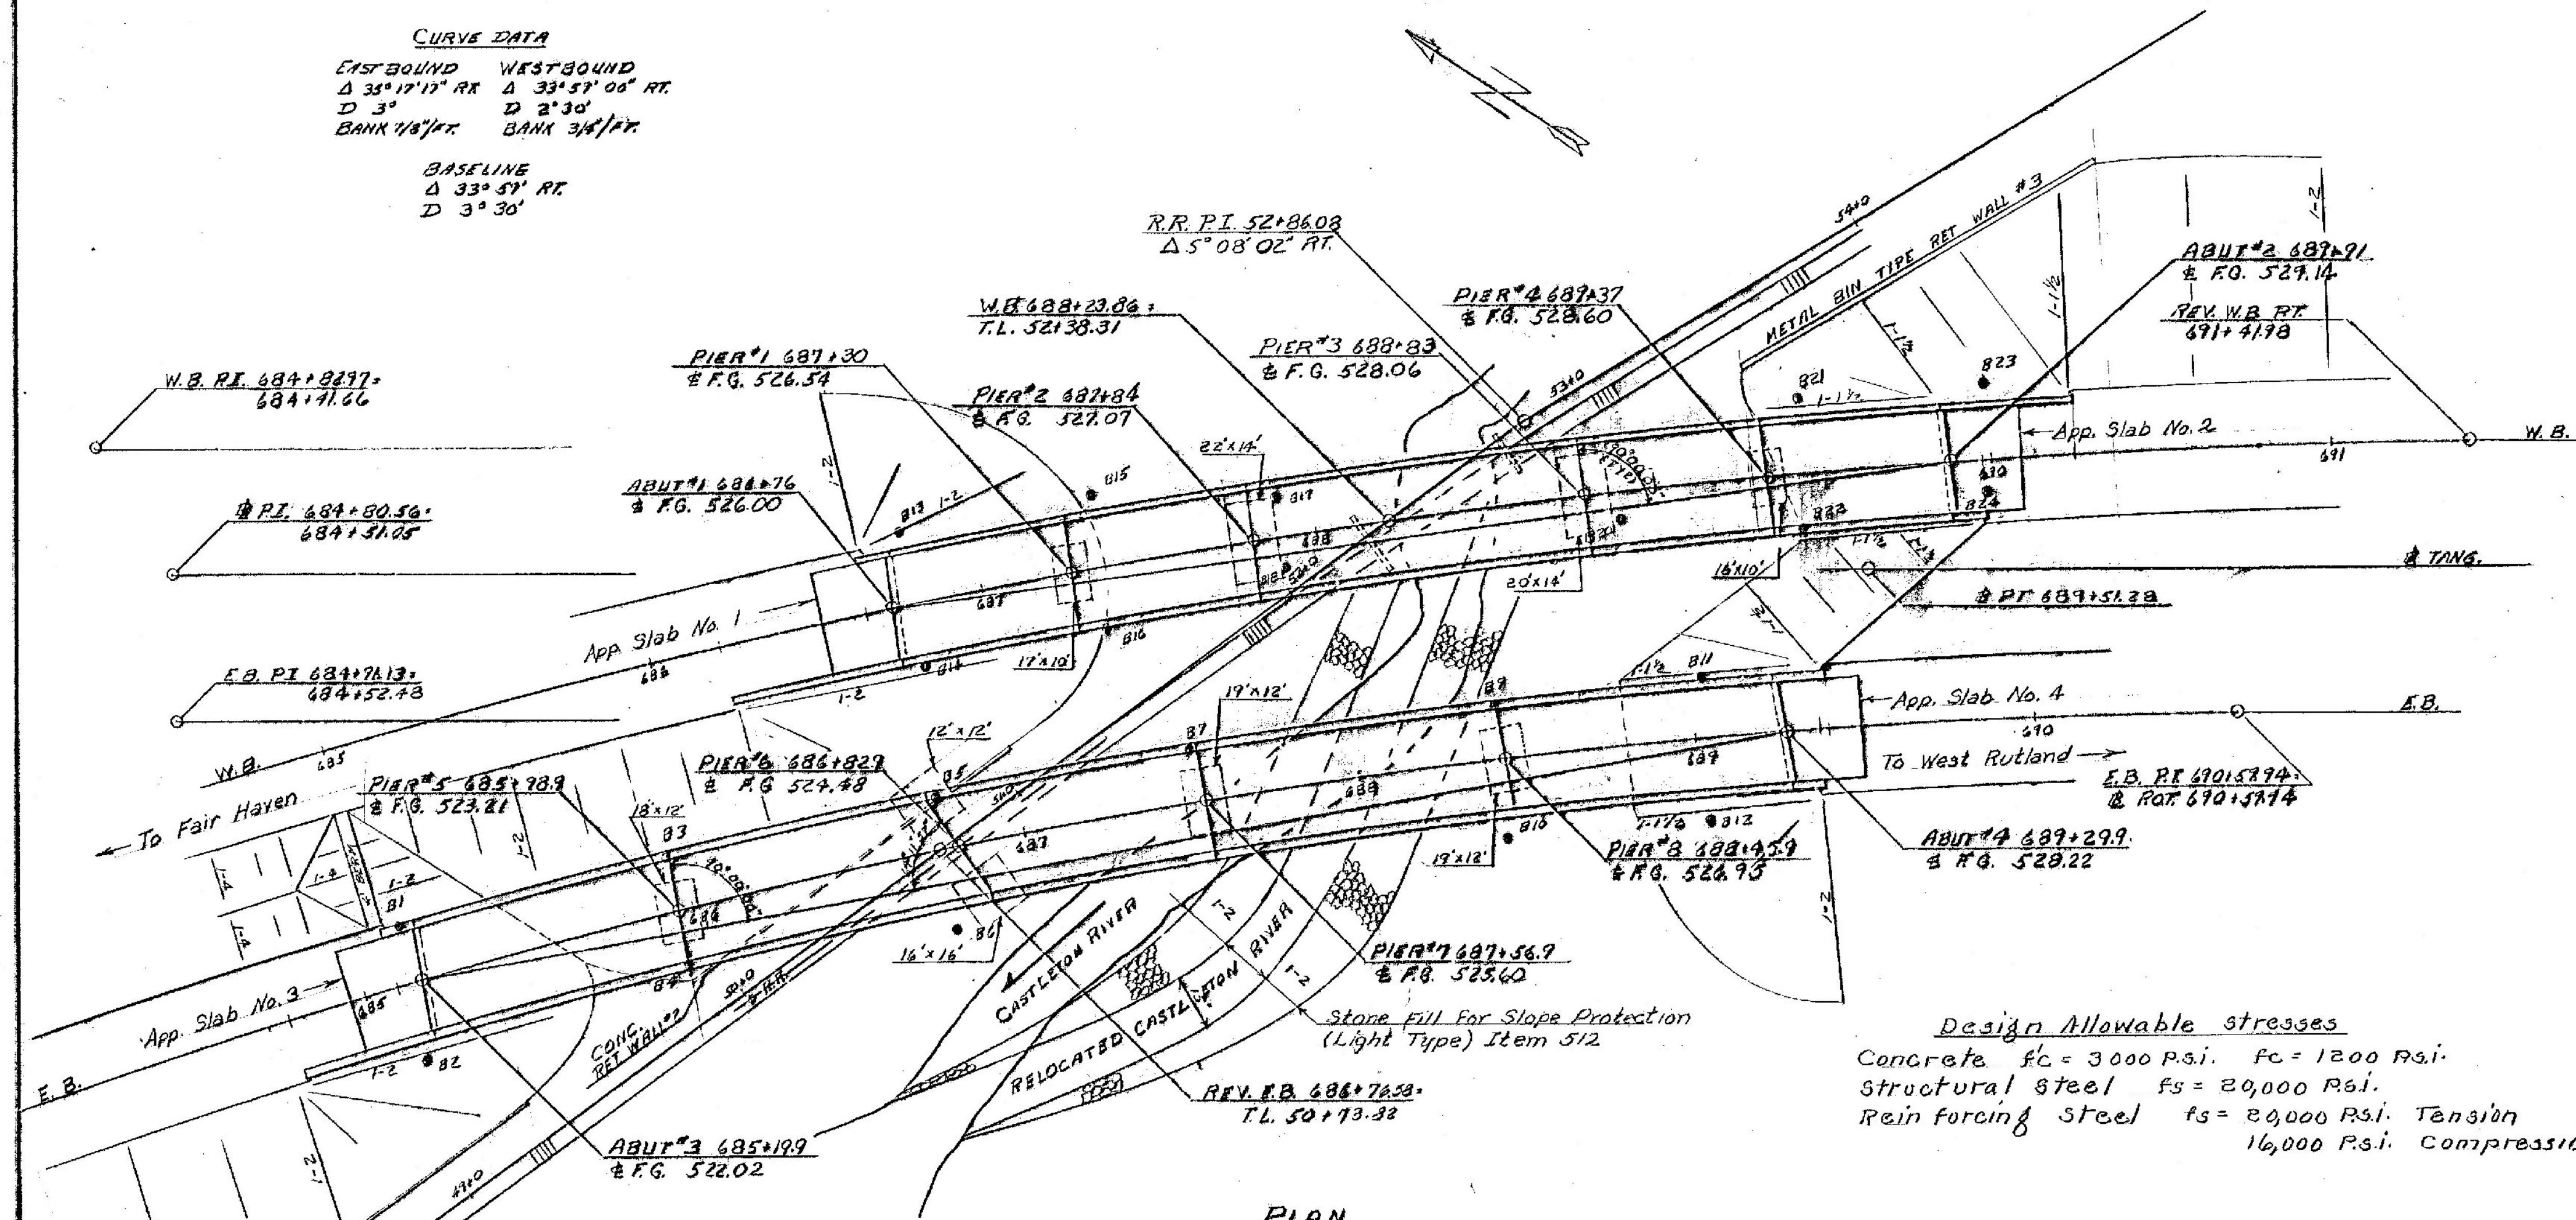

**PLAN**  
 SCALE 1" = 30'

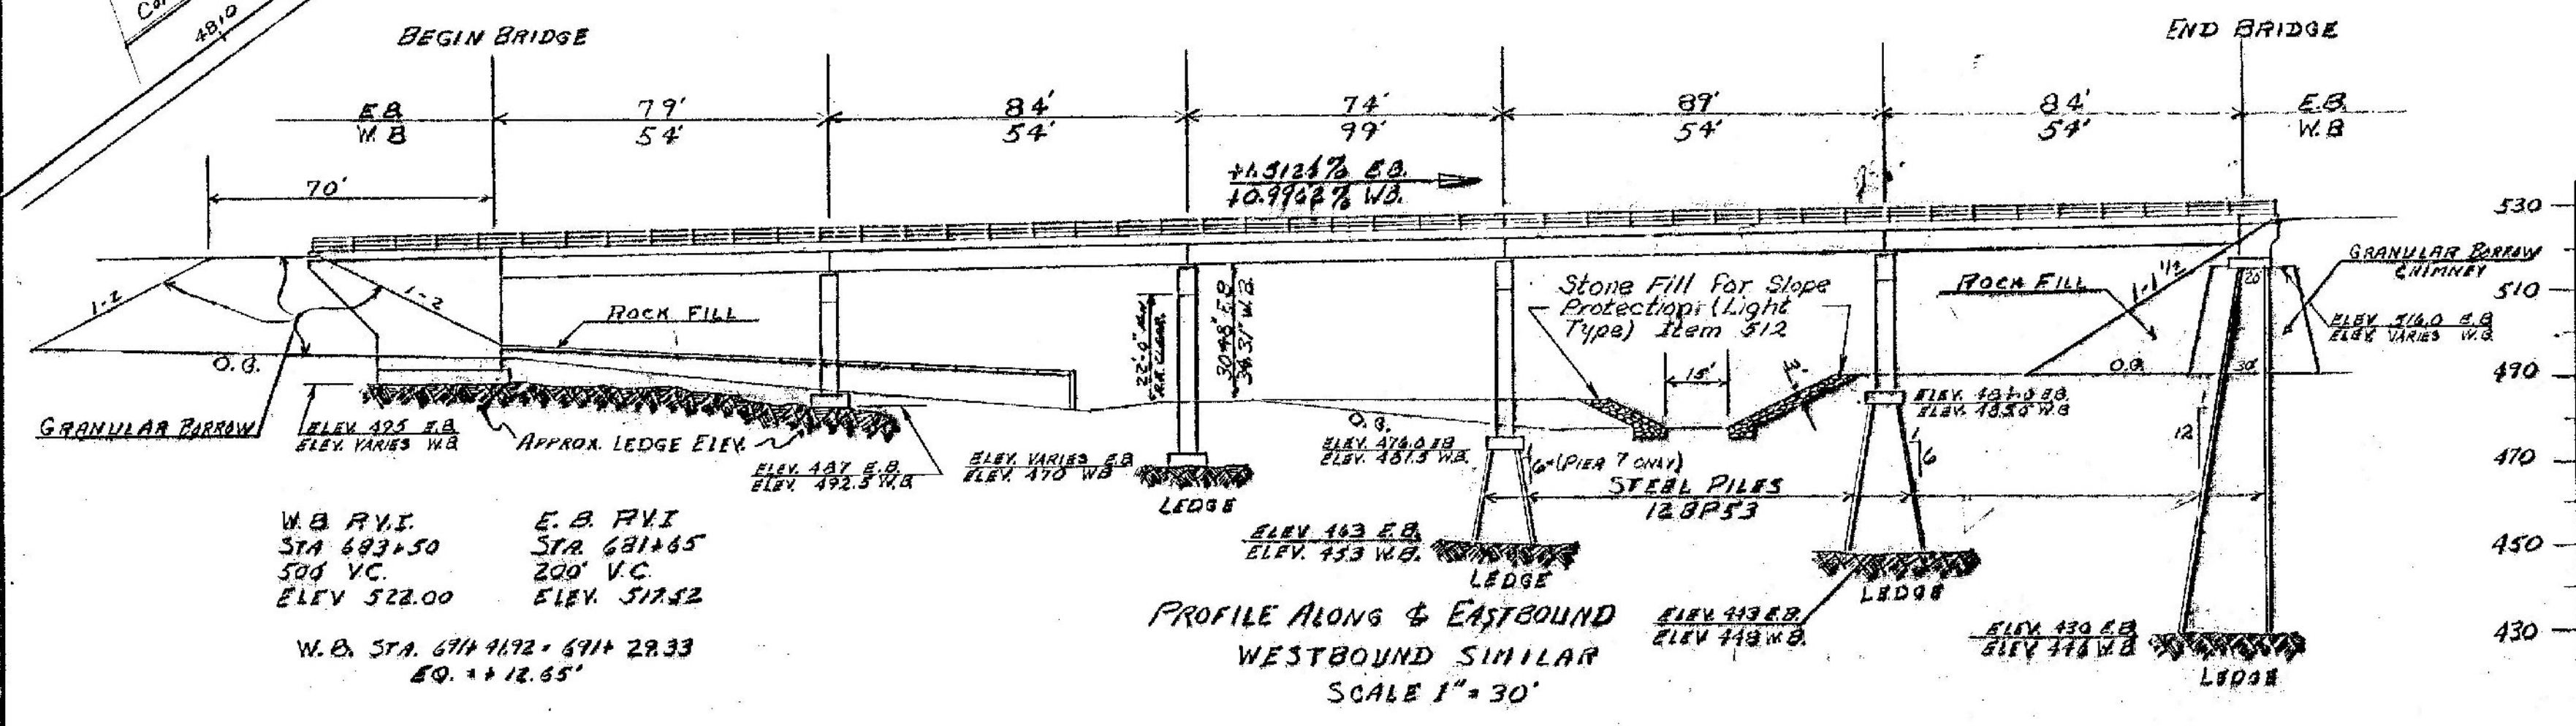

**PROFILE ALONG E & WESTBOUND**  
 WESTBOUND SIMILAR  
 SCALE 1" = 30'

Stage 2 Construction

Sheet 12 of 170 Sheets