




GENERAL NOTES

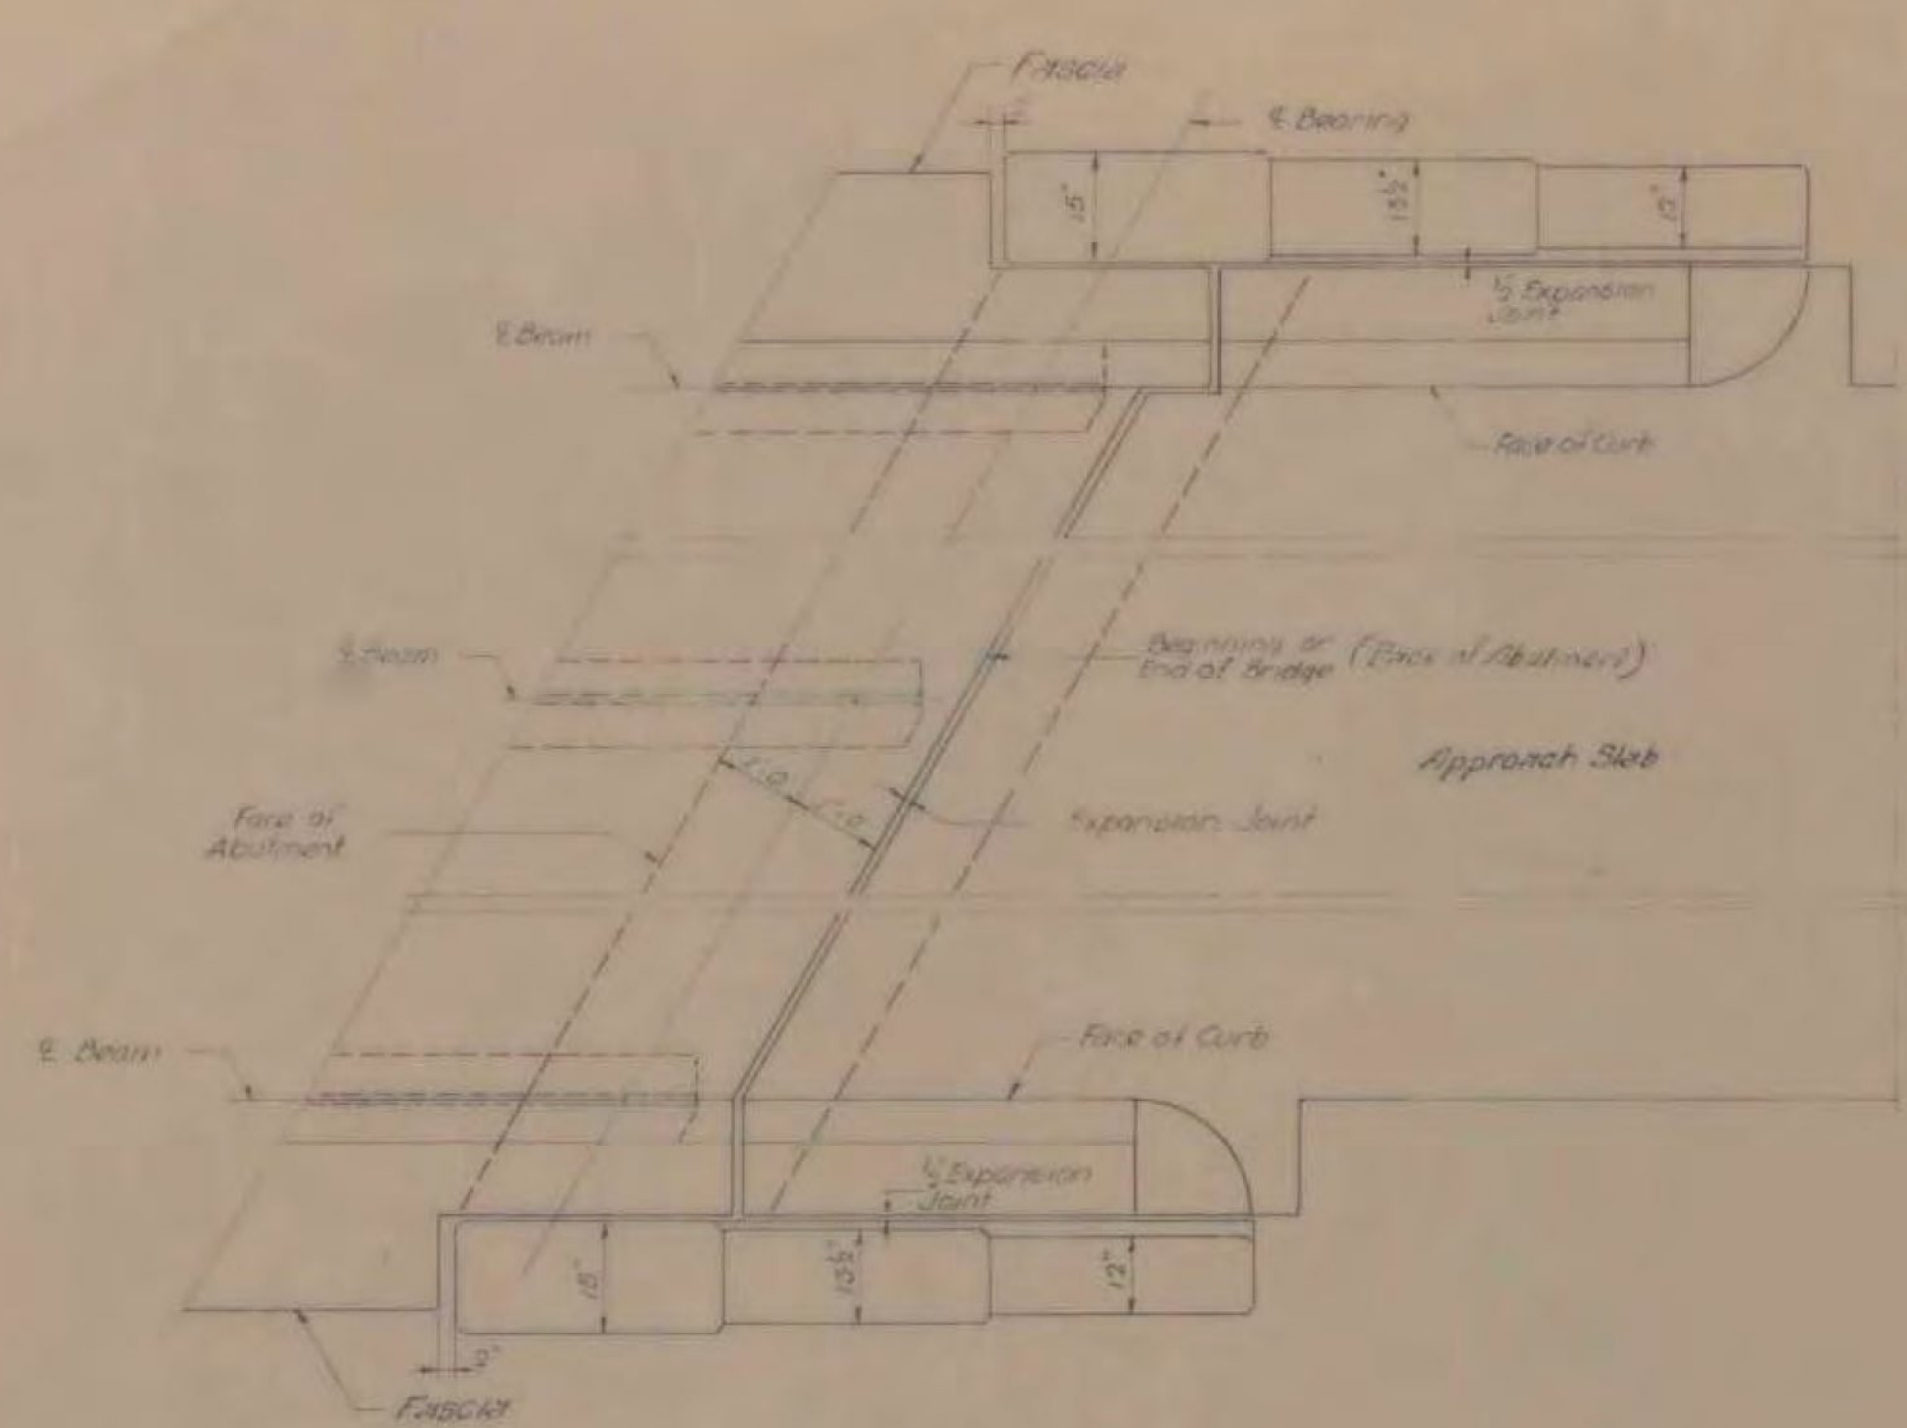


PLAN AT ABUTMENT
Scale 1/2" = 1'-0"

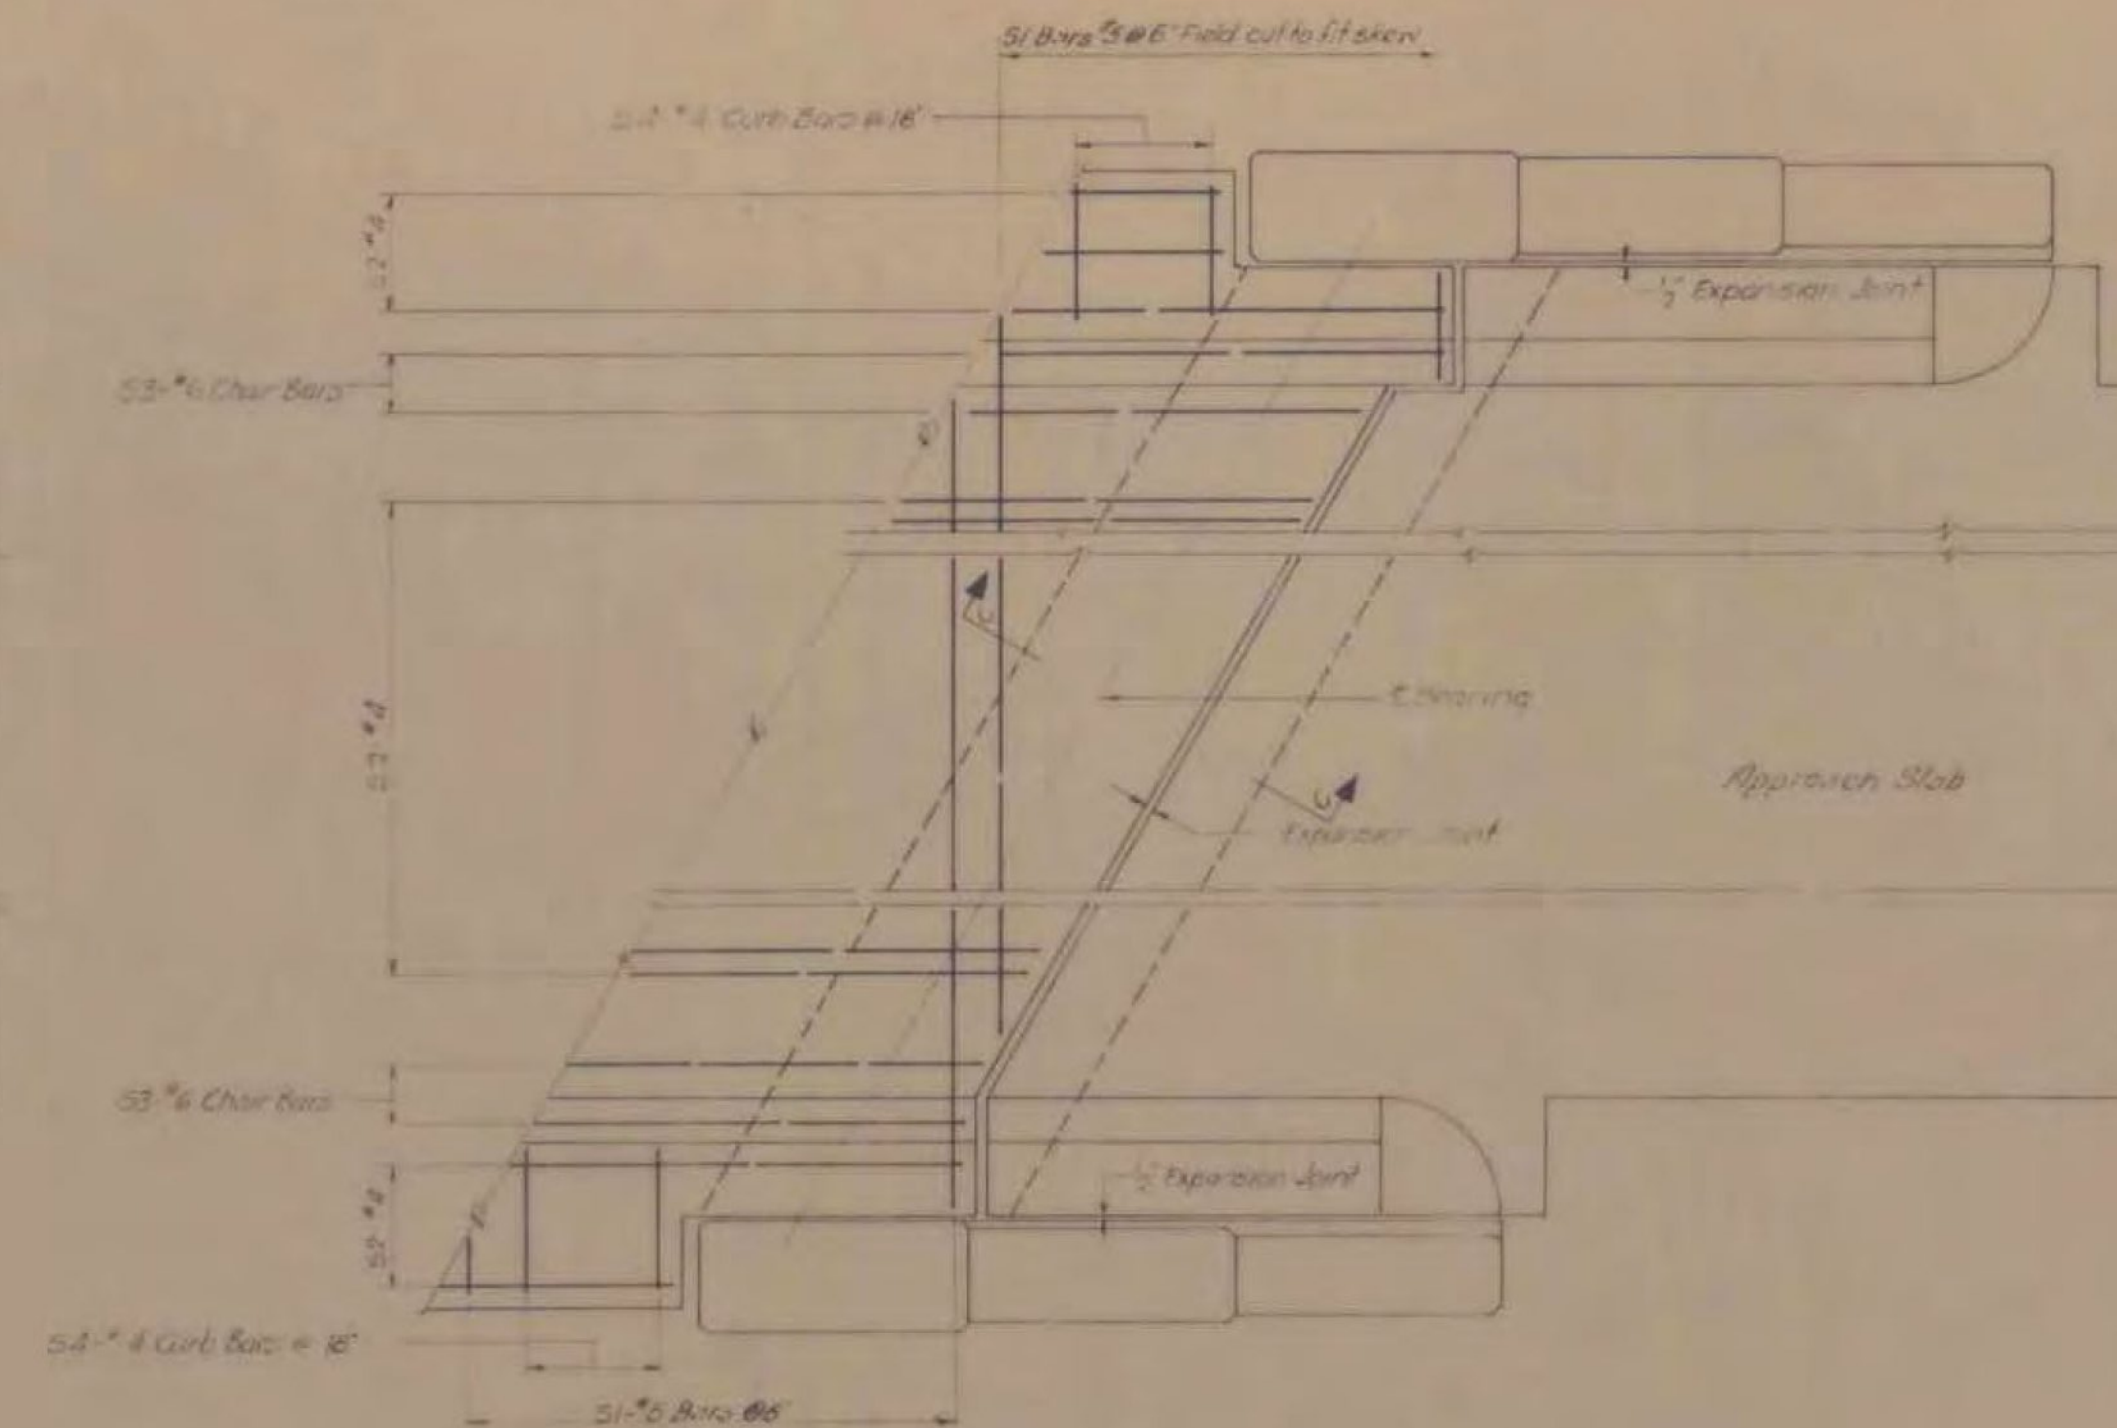

REINFORCEMENT LAYOUT AT ABUTMENT
Scale 1/2" = 1'-0"

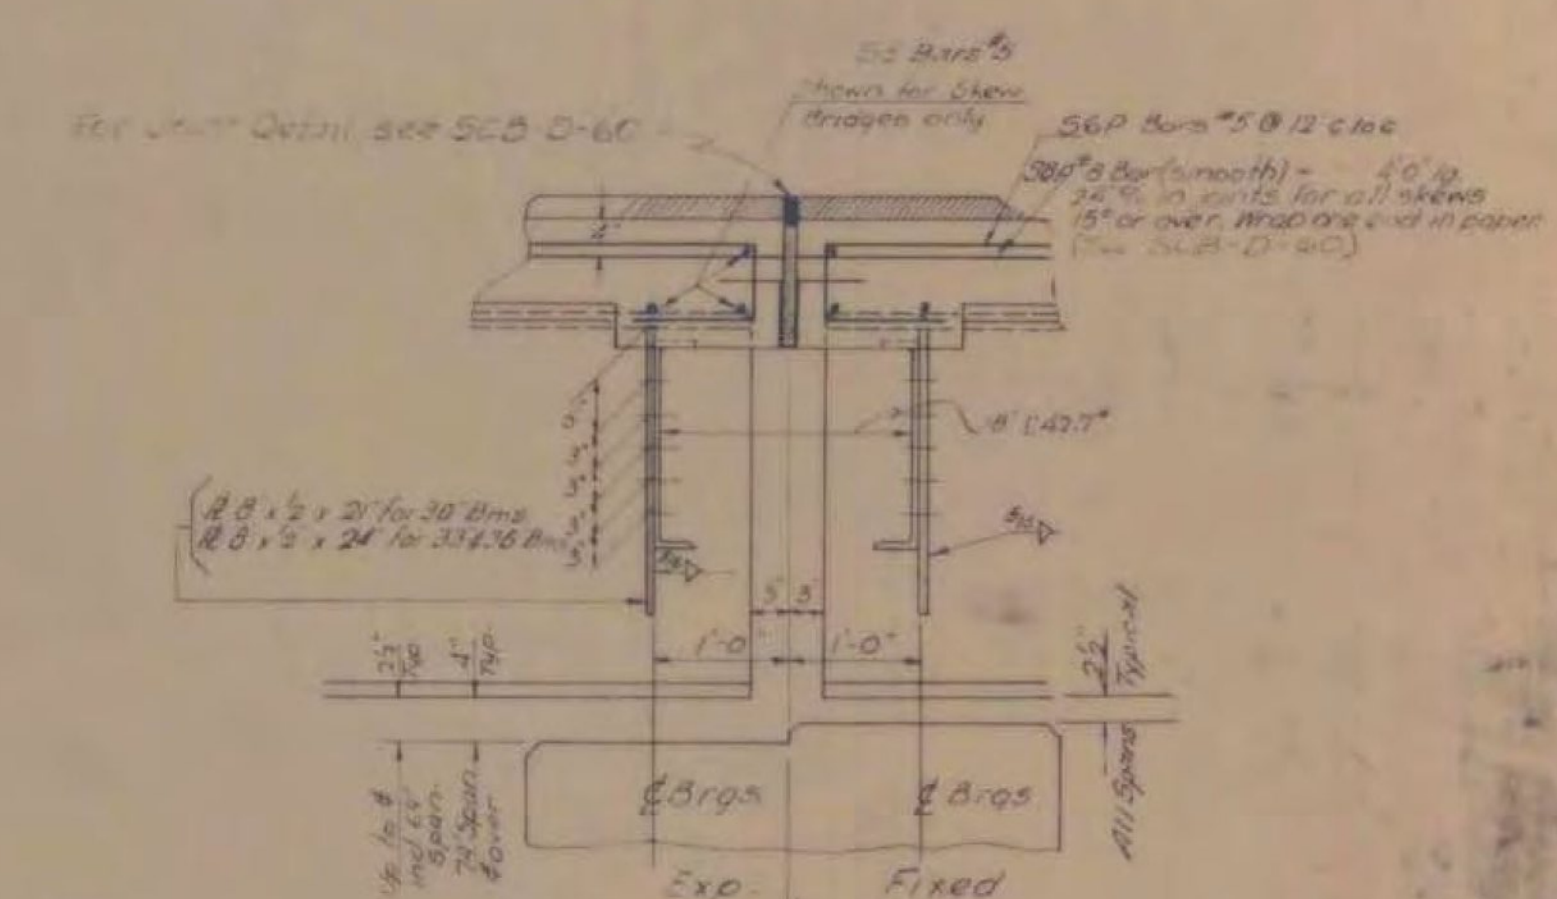


SECTION B-B
Scale 1/2" = 1'-0"

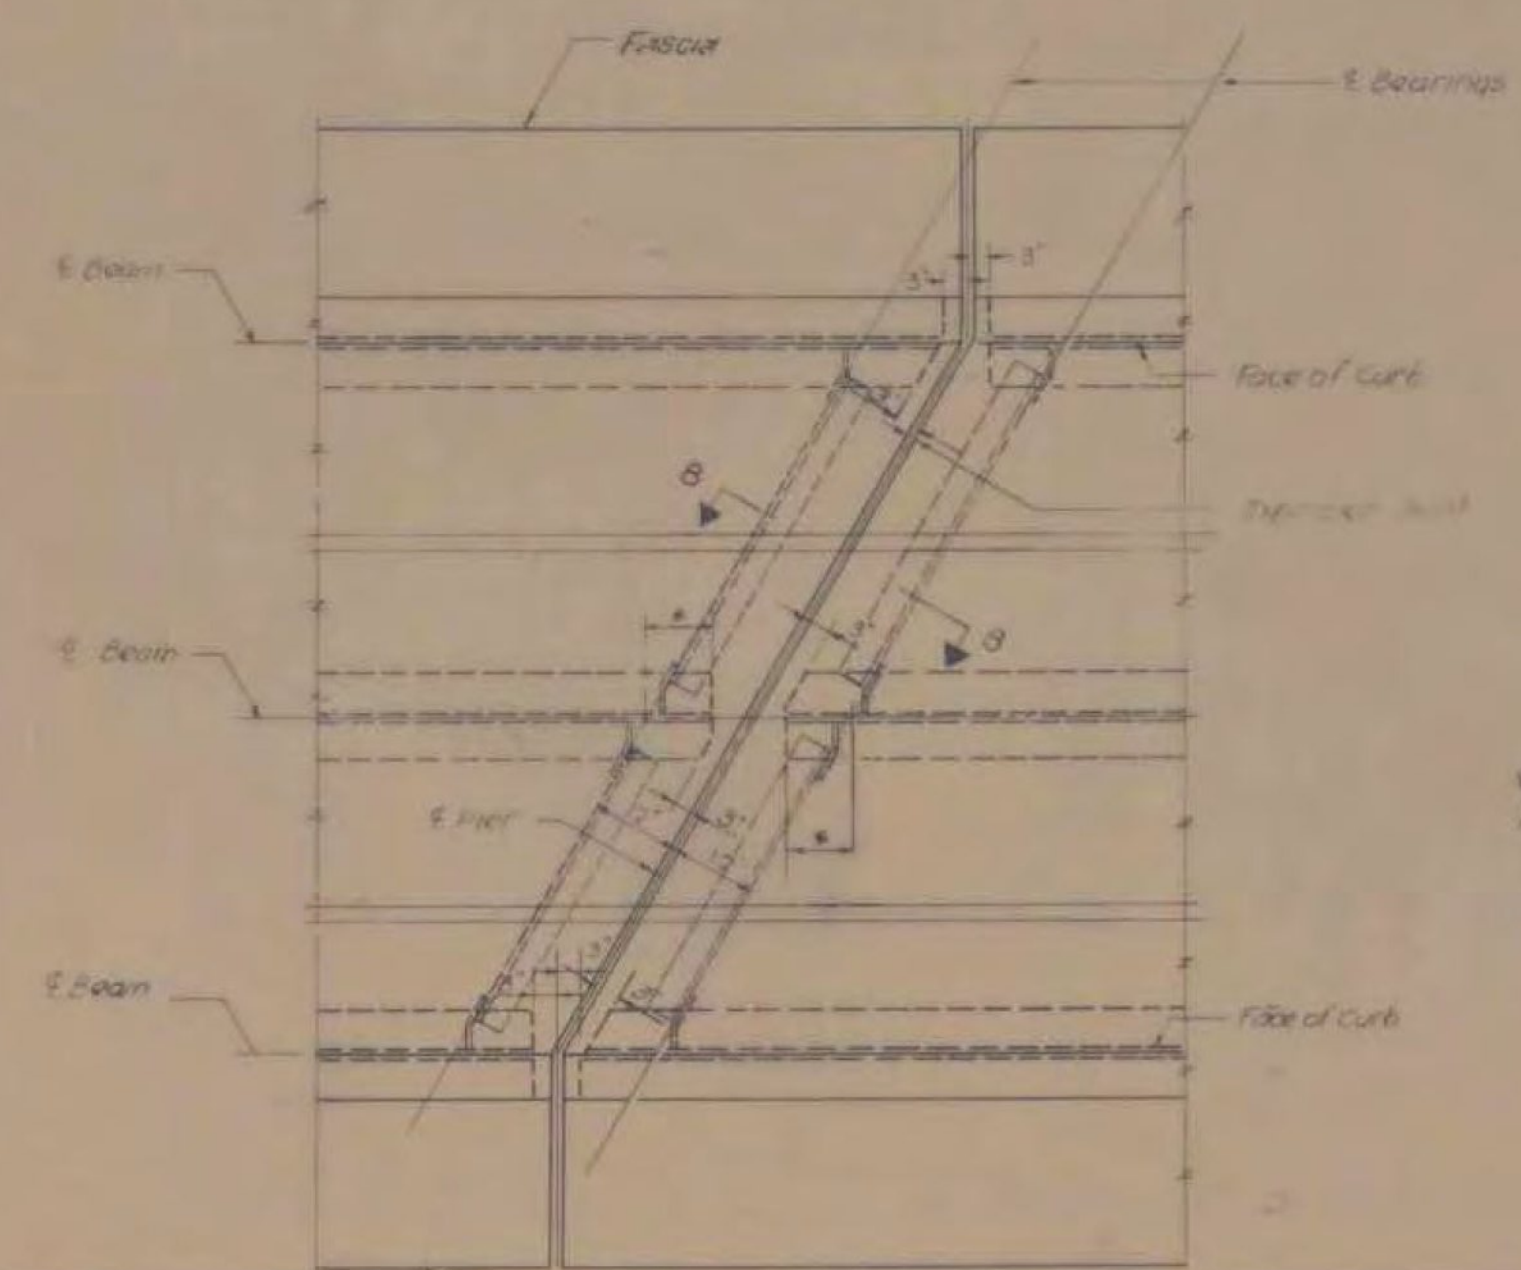


PLAN AT PIER
Scale 1/2" = 1'-0"

* This dimension varies according to the skew See Standards SCB-D-60

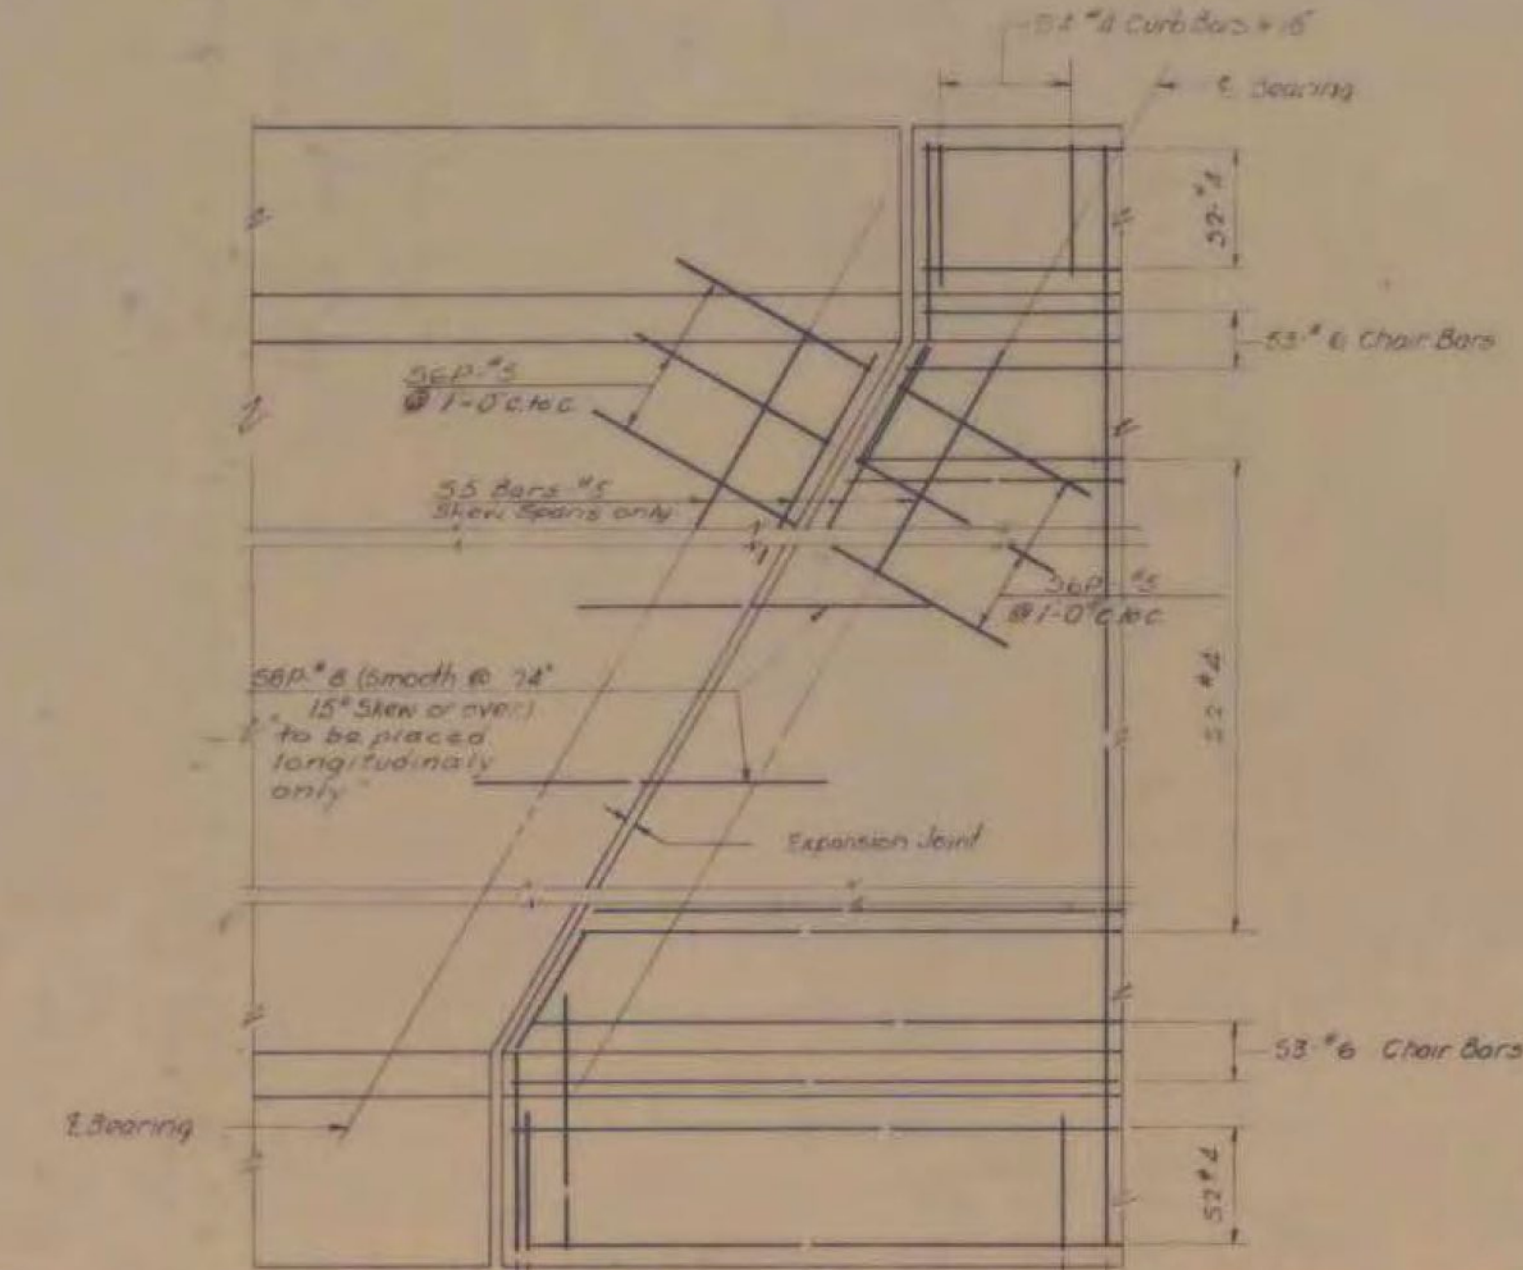

REINFORCEMENT LAYOUT AT PIER
Scale 1/2" = 1'-0"

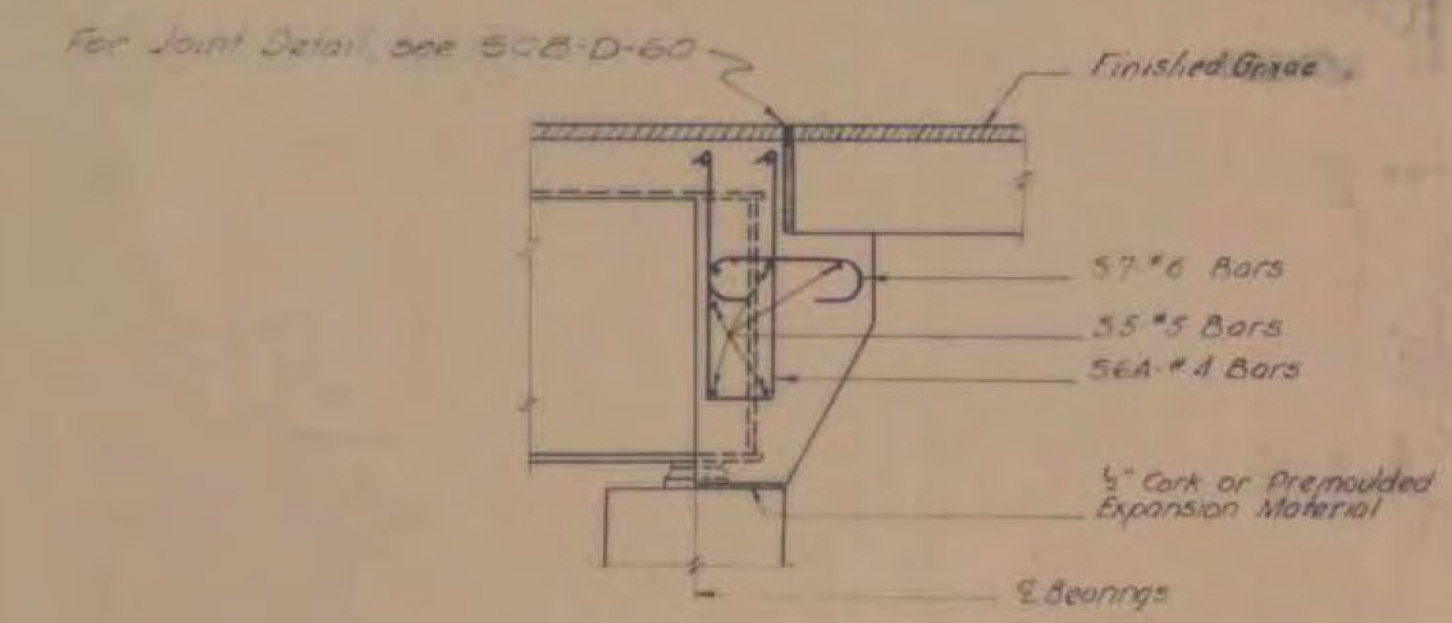

SECTION C-C
Scale 1/2" = 1'-0"

DETAIL OF EXPANSION JOINT OVER PIERS AND AT ABUTMENTS

DEPARTMENT OF HIGHWAYS
STANDARD STRUCTURES

BENNINGTON - MT TABOR
BF BPNT (16)
PROJECT BRIDGE 56C
SHEET 21 OF 23
FOR INFORMATION ONLY

SB-22-60

Revisions & Corrections:
Remove #4 Bar Sec BB 7/26/60
Added General Note 10/6/60
Corrected Joint Detail 1-2-60
Added note to 58 bars 3-2-61

Drawn by: H.W.S. June 1960
Traced by: H.W.S. June 1960
Checked by: R.S.H. & R.T.B. June 1960
Corrected 13 July 1960
Approved 13 July 1960
Chief Engineer

(RE-ADVERTISED)