


- NOTES:
1. THESE PLANS WERE PREPARED WITHOUT THE BENEFIT OF AS-BUILT BRIDGE PLANS. THE CONTRACTOR SHALL MAKE ALLOWANCE FOR BRIDGE ELEMENTS AND MODIFICATIONS NOT SHOWN ON THESE PLANS.
 2. WORK PHASE I SHOWN SCHEMATICALLY. REFERENCE MOT PLANS FOR LIMITS OF WORK PHASES.
 3. WORK PHASE I MAY BE WORKED IN ANY ORDER AT THE CONVENIENCE OF THE CONTRACTOR'S MEANS AND METHODS, TRAFFIC PATTERNS AND DENSITY, OR OTHER SITE CHARACTERISTICS THAT INFLUENCE A PREFERRED WORK AREA.
 4. THE CONTRACTOR HAS THE OPTION TO USE ADDITIONAL MOBILE DUST COLLECTORS, OR PLACE LONGITUDINAL OR TRANSVERSE INTERMEDIATE TARPULIN WALLS.
 5. FOR ADDITIONAL DETAILS, SEE CONTAINMENT MISCELLANEOUS DETAILS SHEETS.

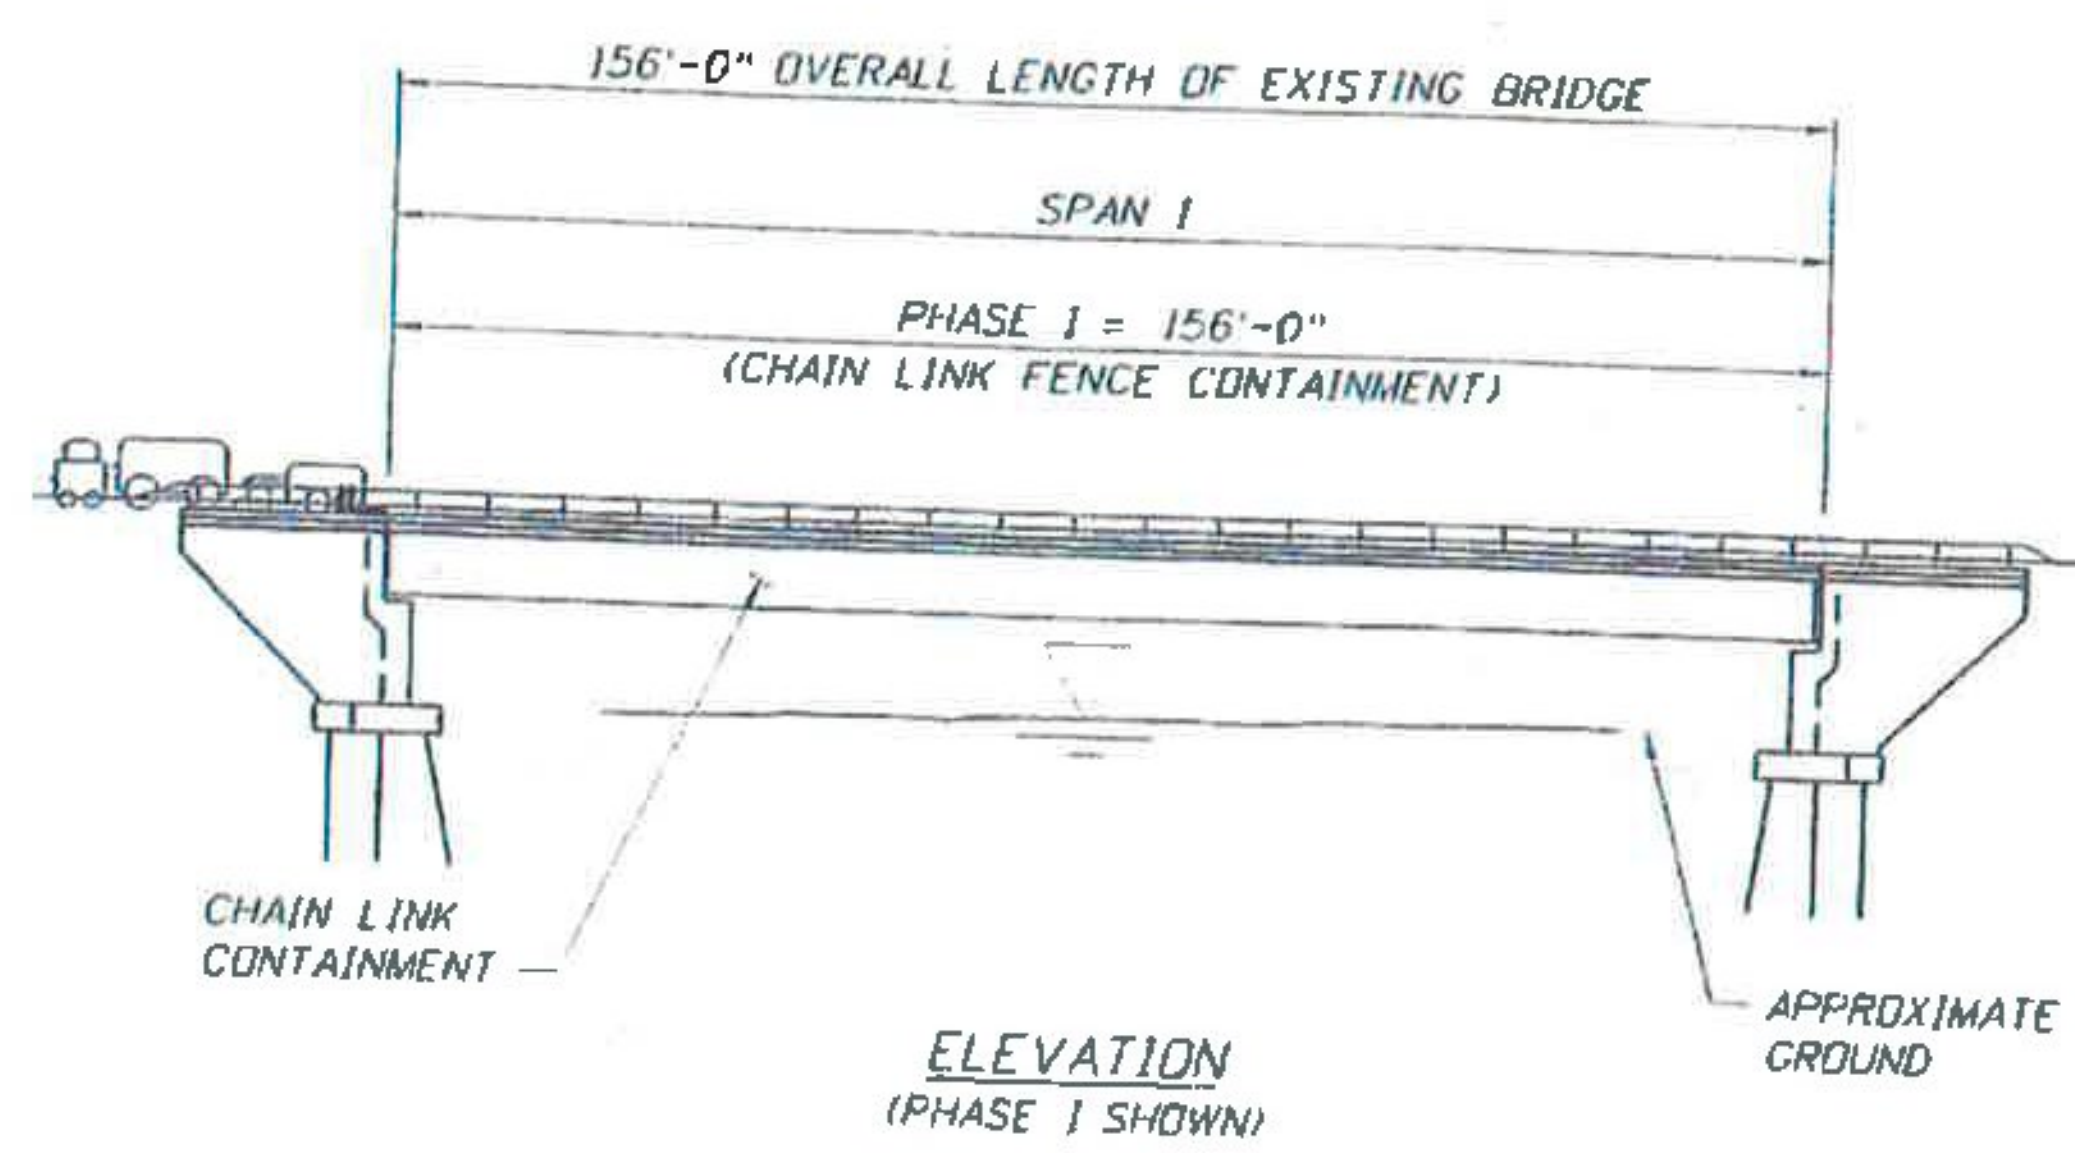

SUBMITTAL REVIEW

Review is only for general conformity to the contract drawings and specifications and shall not relieve the contractor of his entire responsibility under the contract, including among other things, dimensions to be confirmed and correlated at the job site, and information that pertains to the fabrication processes or to techniques of construction.

NO EXCEPTIONS TAKEN
 MAKE CORRECTIONS NOTED
 RESUBMITTAL NOT REQUIRED
 AMEND AND RESUBMIT
 REJECTED - SEE REMARKS

BY: **PB AMERICAS, INC.**
By: Brynagle
 DATE: **5/9/16**

Vermont Agency of Transportation
RECEIVED
 ON: **May 10, 2016**
 and Checked for
CONFORMANCE
 BY: Mark Sargent DATE: 05/13/2016



REVISIONS			PAUL STEJLLE P.E. P.E. LICENSE NUMBER 10795 A2B ENGINEERING, LLC. 5406 N. HOOVER BLVD., SUITE 12 TAMPA, FL 33634		MONOKO, LLC. 1037 PENINSULA AVENUE TARPON SPRINGS, FL 34689 PHONE (727) 940-3244 FAX (727) 279-8795		VERMONT AGENCY OF TRANSPORTATION		SHEET TITLE PLAN & ELEVATION		Bridge No. 11	
DATE	BY	DESCRIPTION	DRAWN BY	CHECKED BY	DESIGNED BY	CHECKED BY	ROAD NO.	COUNTY	PROJECT ID	PROJECT NAME	REF. DATE NO.	SHEET NO.
			BDN 11/15	PDB 11/15	MAT 11/15	PRS 11/15		BENNINGTON	BF BPNT (116)	FIVE BRIDGES ON OR OVER US ROUTE 7		C-4

© 2015 Monoko, LLC 17 Bennington, VT Tabular Containment Plans/CDs/DT/Plan/Rev.dgn