

TYPICAL SECTION
(MOBILE DUST COLLECTOR NOT SHOWN FOR CLARITY)

SUBMITTAL REVIEW


Review is only for general conformity to the contract drawings and specifications and shall not relieve the contractor of his entire responsibility under the contract, including among other things, dimensions to be confirmed and correlated at the job site, and information that pertains to the fabrication processes or to techniques of construction.

NO EXCEPTIONS TAKEN
 MAKE CORRECTIONS NOTED RESUBMITTAL NOT REQUIRED
 AMEND AND RESUBMIT
 REJECTED - SEE REMARKS

BY: *St. Boyington*
 DATE: *5/9/16*

PB AMERICAS, INC.

CONTAINMENT PLATFORM CONSTRUCTED W/CHAIN LINK FENCE HAVING A 2" MESH & 9 GAUGE WIRE. SECURE FENCE TO CABLE WITH 1/2"Ø ROPE TIES OR CABLE CLIPS. SEE CHAIN LINK FENCE LAYOUT DETAIL.

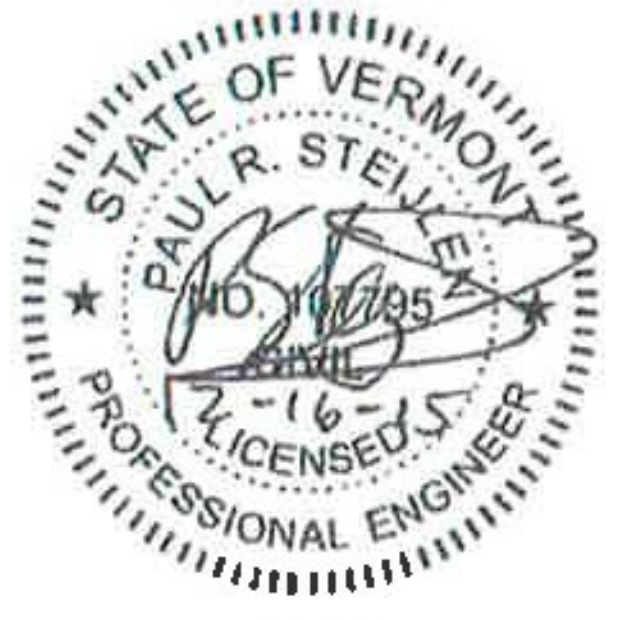

* BASED ON MAXIMUM CONTAINMENT AREA OF 450 FT² AS MEASURED PERPENDICULAR TO THE DIRECTION OF CROSS-DRAFT (SEE VENTILATION SYSTEM TABLE ON GENERAL NOTES SHEETS)

- NOTES:
1. THESE PLANS WERE PREPARED WITHOUT THE BENEFIT OF AS-BUILT BRIDGE PLANS. THE CONTRACTOR SHALL MAKE ALLOWANCE FOR BRIDGE ELEMENTS AND MODIFICATIONS NOT SHOWN ON THESE PLANS.
 2. THE CONTRACTOR SHALL AVOID ATTACHING/CONNECTING TO BRIDGE ELEMENTS EXHIBITING SIGNIFICANT SECTION LOSS.
 3. FOR ADDITIONAL DETAILS, SEE CONTAINMENT MISCELLANEOUS DETAILS SHEETS.
 4. CONTRACTOR TO PROVIDE LIFE LINES MEETING OSHA 1910.66 APPENDIX C AS REQUIRED.

Vermont Agency of Transportation
RECEIVED
 ON: **May 10, 2016**
 and Checked for
CONFORMANCE
 BY: Mark Sargent DATE: 05/13/2016

REVISIONS		DATE	BY	DESCRIPTION	DRAWN BY BDN 11/15	CHECKED BY POB 11/15	DESIGNED BY MAT 11/15	CHECKED BY PRS 11/15	VERMONT AGENCY OF TRANSPORTATION			SHEET TITLE	REF. DRAW. NO.
DATE	BY								ROAD NO.	COUNTY	PROJECT #		
									BENNINGTON	BF BPNT 1161	CONTAINMENT SECTION DETAILS		
FIVE BRIDGES ON OR OVER US ROUTE 7												C-5	

Bridge No. 11