


PLAN
(PHASE I SHOWN,
PHASES II THRU IV SIMILAR)

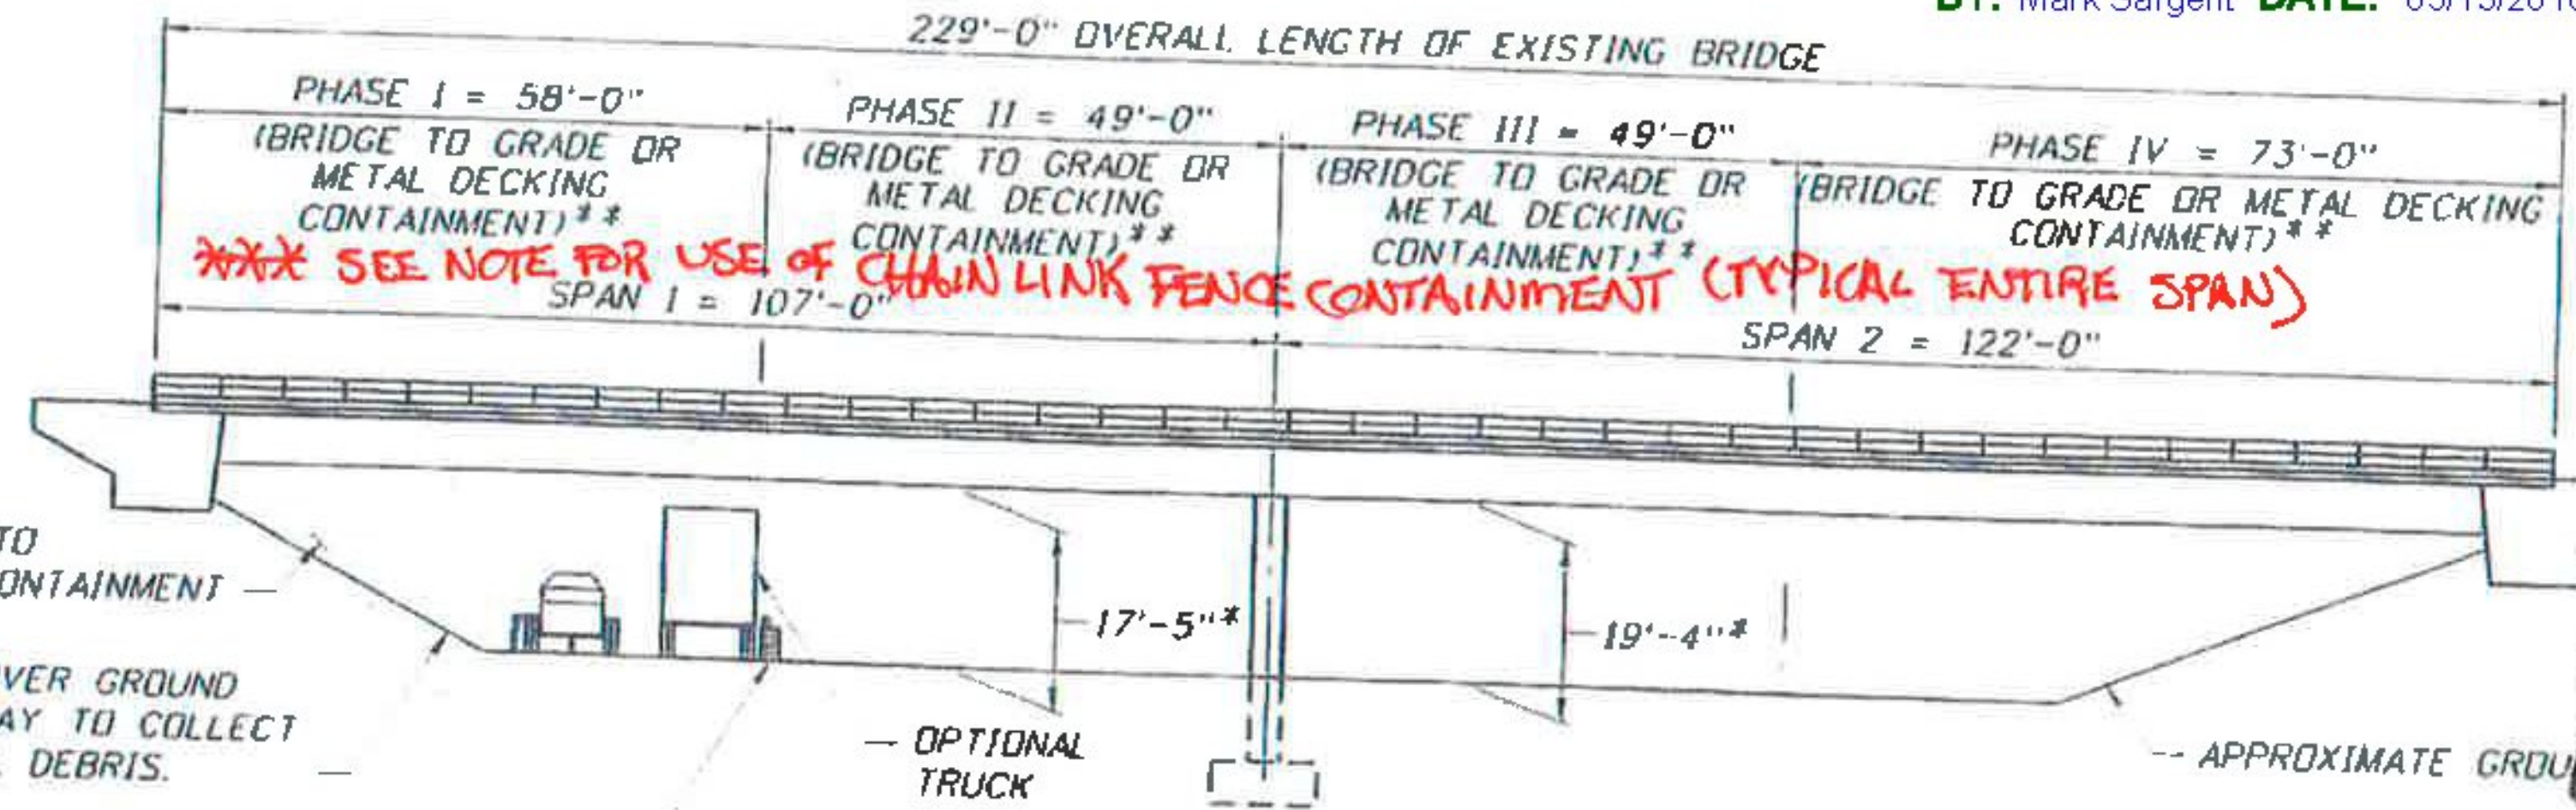

ELEVATION
(PHASE I SHOWN,
PHASES II THRU IV SIMILAR)

Vermont Agency of Transportation
RECEIVED
ON: May 10, 2016
and Checked for
CONFORMANCE
BY: Mark Sargent DATE: 05/13/2016

SUBMITTAL REVIEW

Review is only for general conformity to the contract drawings and specifications and shall not relieve the contractor of his entire responsibility under the contract, including among other things, dimensions to be confirmed and correlated at the job site, and information that pertains to the fabrication processes or to techniques of construction.

NO EXCEPTIONS TAKEN
 MAKE CORRECTIONS NOTED
 RESUBMITTAL NOT REQUIRED
 AMEND AND RESUBMIT
 REJECTED - SEE REMARKS

BY: *Mark Sargent* **PB AMERICAS, INC.**
DATE: *5/9/16*

- NOTES:
1. THESE PLANS WERE PREPARED WITHOUT THE BENEFIT OF AS-BUILT BRIDGE PLANS. THE CONTRACTOR SHALL MAKE ALLOWANCE FOR BRIDGE ELEMENTS AND MODIFICATIONS NOT SHOWN ON THESE PLANS.
 2. WORK PHASES I-IV SHOWN SCHEMATICALLY. REFERENCE NOT PLANS FOR LIMITS OF WORK PHASES.
 3. WORK PHASES I-IV MAY BE WORKED IN ANY ORDER AT THE CONVENIENCE OF THE CONTRACTOR'S MEANS AND METHODS, TRAFFIC PATTERNS AND DENSITY, OR OTHER SITE CHARACTERISTICS THAT INFLUENCE A PREFERRED WORK AREA.
 4. THE CONTRACTOR HAS THE OPTION TO USE ADDITIONAL MOBILE DUST COLLECTORS, OR PLACE LONGITUDINAL OR TRANSVERSE INTERMEDIATE TARPULIN WALL.
 5. FOR ADDITIONAL DETAILS, SEE CONTAINMENT MISCELLANEOUS DETAILS SHEETS.

***** USE OF CHAIN LINK FENCE CONTAINMENT IS NOT ALLOWED IN AREAS OVER LIVE TRAFFIC, BUT MAY BE USED ELSEWHERE.**

- * EXISTING MINIMUM VERTICAL CLEARANCE BASED ON EXISTING BRIDGE PLANS. CONTRACTOR SHALL OBTAIN APPROVAL FOR REDUCTION OF EXISTING VERTICAL CLEARANCE AND RAISE CABLES AS NEEDED OVER ACTIVE ROADWAY.
- ** CONTRACTOR MAY USE BRIDGE-TO-GRADE OPTION FOR PRESSURE WASHING OPERATIONS AND METAL DECKING CONTAINMENT FOR ABRASIVE BLASTING OPERATIONS.



REVISIONS		DATE	BY	DESCRIPTION	DRAWN BY: BDN 11/15	CHECKED BY: PDB 11/15	DESIGNED BY: MAT 11/15	CHECKED BY: PRS 11/15	VERMONT AGENCY OF TRANSPORTATION			SHEET TITLE	REF. DIV. NO.
DATE	BY								ROAD NO.	COUNTY	PROJECT NO.		
									BENNINGTON	BF BPNT (16)		Bridge No. D15 PLAN & ELEVATION	
PAUL STEIJLEN P.E. P.E. LICENSE NUMBER 107795 A2B ENGINEERING, LLC. 5406 N. HOOVER BLVD., SUITE 12 TAMPA, FL 33634					MONOKO, LLC. 1037 PENINSULA AVENUE TARPON SPRINGS, FL 34689 PHONE (727) 940-3244 FAX (727) 279-8795					FIVE BRIDGES ON OR OVER US ROUTE 7			SHEET NO. C-6

C:\187 Monoko, LLC - 17 Bennington - H Tabors - Containment Plans\ContElev.dwg