


TYPICAL EXTERIOR SUPPORT HANGER DETAIL (TYP.)

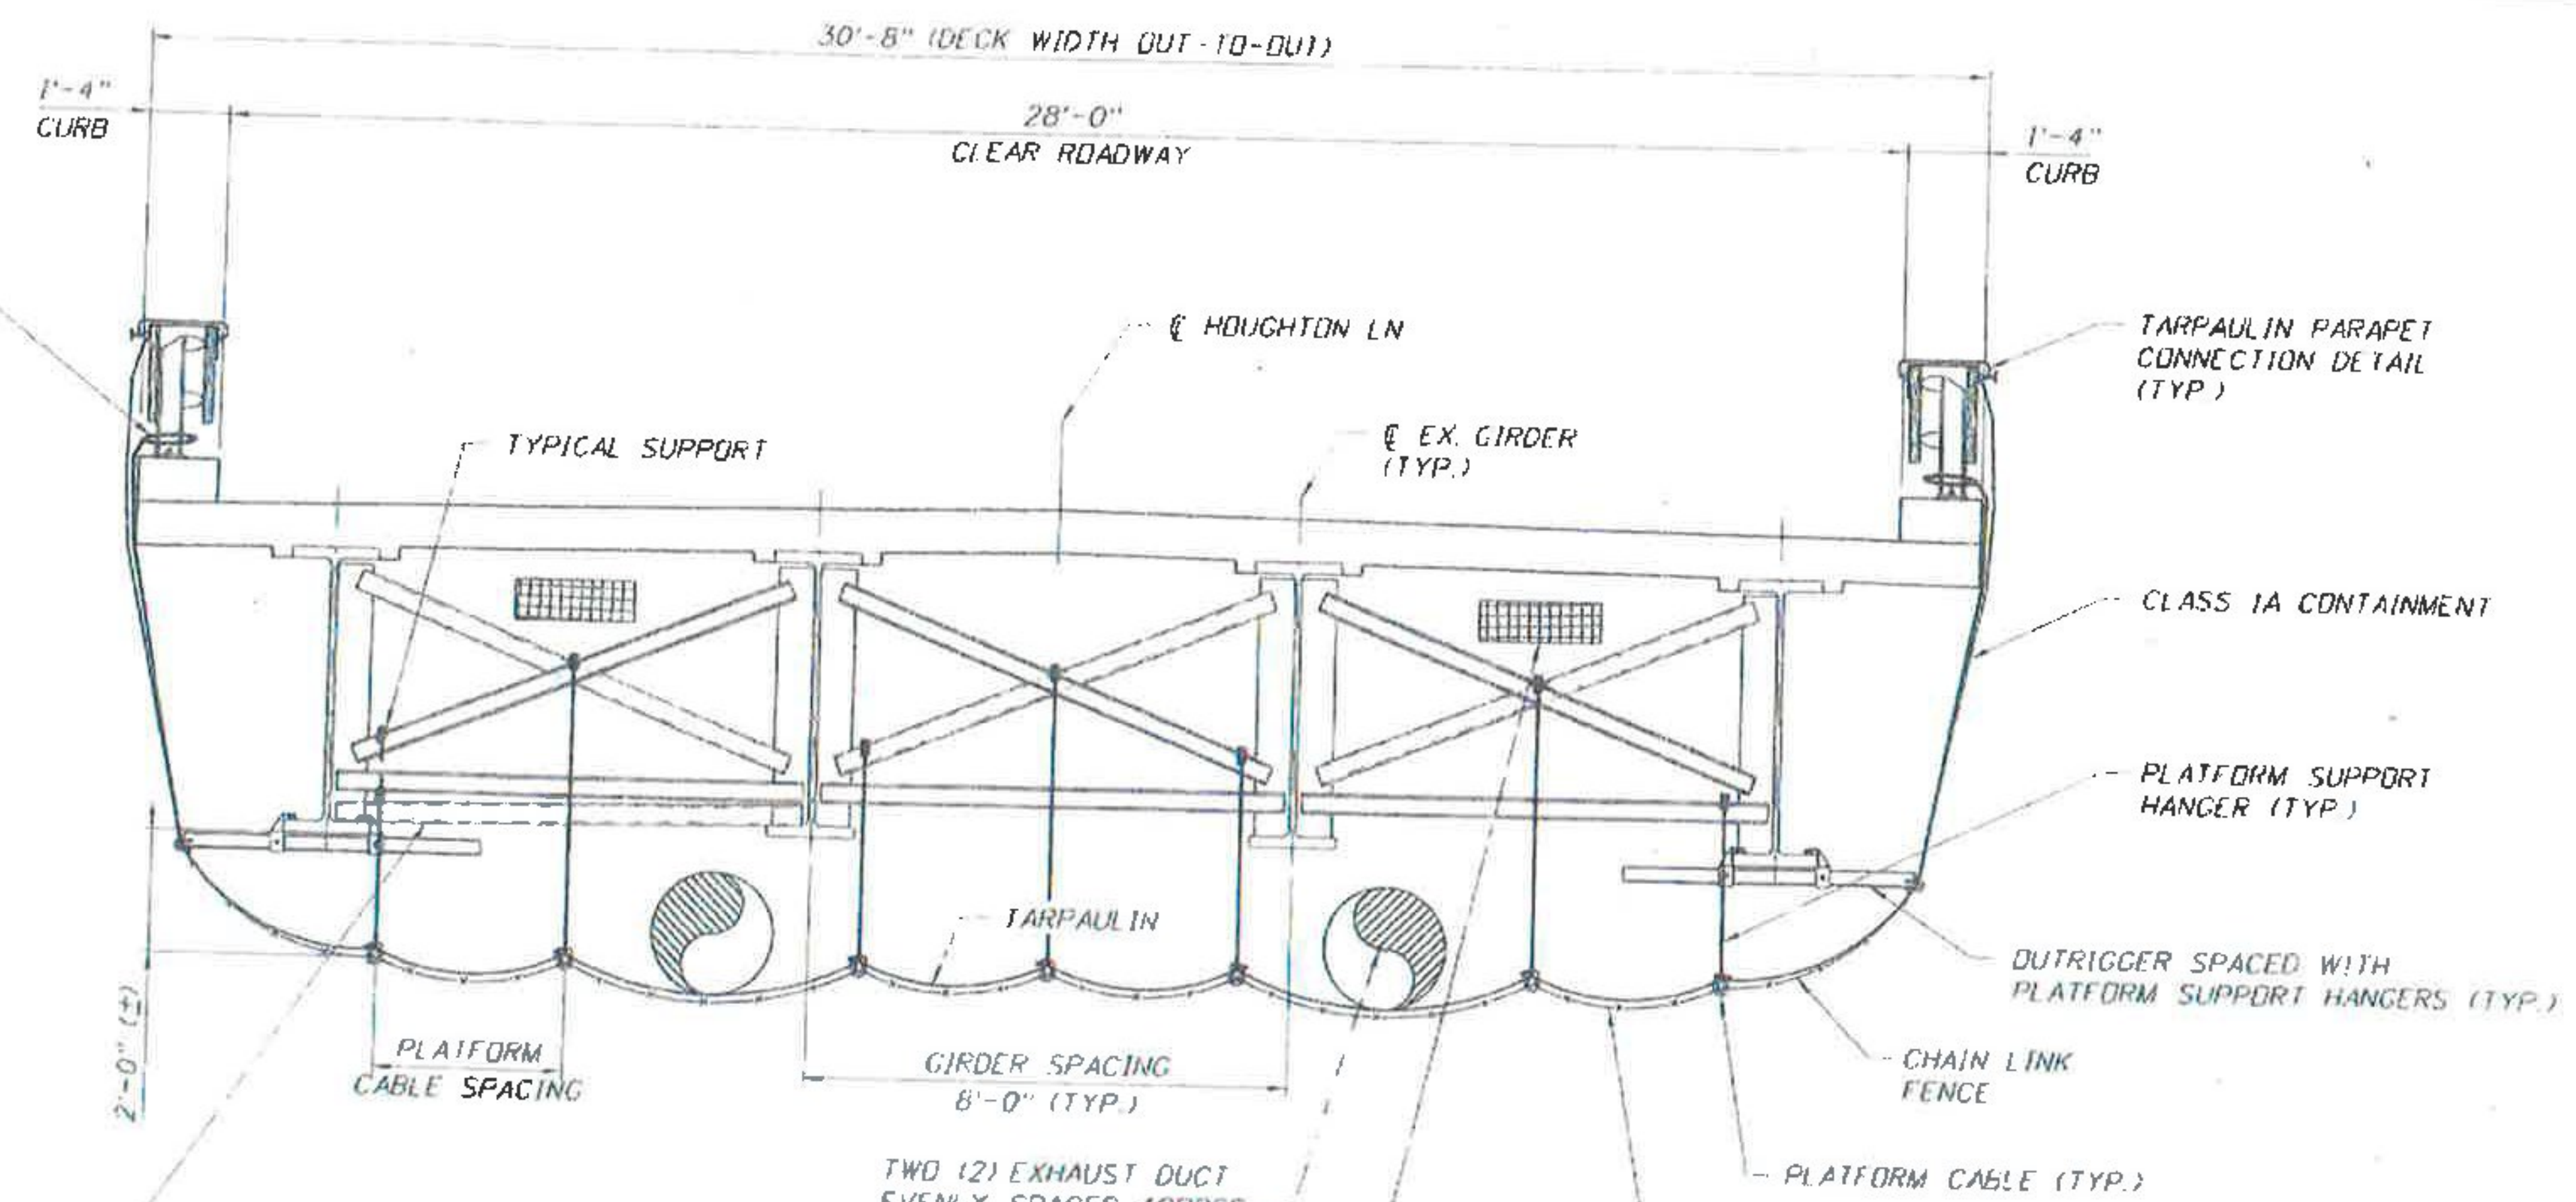

OPTIONAL STRUCTURAL TUBING ALTERNATE TO SUSPENDING PLATFORM FROM THE DIAPHRAGMS (SEE TYPICAL SUPPORT HANGER DETAIL 1)

TWO (2) EXHAUST DUCT EVENLY SPACED ACROSS DECK SECTION (TYP.)
 PROVIDE APPROXIMATELY ~~240~~ **24.0** FT² OF AIR INLET OPENINGS INSTALLED AT EXHAUST DUCTS (TYP.)

CONTAINMENT PLATFORM CONSTRUCTED W/ CHAIN LINK FENCE HAVING A 2" MESH & 9 GAUGE WIRE OR NETTING (MEETING ANSI A10.11 & OSHA 1926.500 SUBPART M) SECURE FENCE TO CABLE WITH 1/4" ROPE TIES OR CABLE CLIPS SEE CHAIN LINK FENCE LAYOUT DETAIL

* BASED ON MAXIMUM CONTAINMENT AREA OF 240 FT² AS MEASURED PERPENDICULAR TO THE DIRECTION OF CROSS-DRAFT (SEE VENTILATION SYSTEM TABLE ON GENERAL NOTES SHEETS)

- NOTES:
1. THESE PLANS WERE PREPARED WITHOUT THE BENEFIT OF AS-BUILT BRIDGE PLANS. THE CONTRACTOR SHALL MAKE ALLOWANCE FOR BRIDGE ELEMENTS AND MODIFICATIONS NOT SHOWN ON THESE PLANS.
 2. THE CONTRACTOR SHALL AVOID ATTACHING/CONNECTING TO BRIDGE ELEMENTS EXHIBITING SIGNIFICANT SECTION LOSS.
 3. FOR ADDITIONAL DETAILS, SEE CONTAINMENT MISCELLANEOUS DETAILS SHEETS.
 4. CONTRACTOR TO PROVIDE LIFE LINES MEETING DSHA 1910.66 APPENDIX C AS REQUIRED.

TYPICAL SECTION
 (PHASES I THRU IV)
 (MOBILE DUST COLLECTOR NOT SHOWN FOR CLARITY)

Vermont Agency of Transportation
RECEIVED
 ON: **May 10, 2016**
 and Checked for
CONFORMANCE
 BY: Mark Sargent DATE: 05/13/2016

SUBMITTAL REVIEW	
Review is only for general conformity to the contract drawings and specifications and shall not relieve the contractor of his entire responsibility under the contract, including among other things, dimensions to be confirmed and correlated at the job site, and information that pertains to the fabrication processes or to techniques of construction.	
<input type="checkbox"/>	NO EXCEPTIONS TAKEN
<input checked="" type="checkbox"/>	MAKE CORRECTIONS NOTED RESUBMITTAL NOT REQUIRED
<input type="checkbox"/>	AMEND AND RESUBMIT
<input type="checkbox"/>	REJECTED - SEE REMARKS
BY: PB AMERICAS, INC.	
DATE:	5/11/16



REVISIONS DATE BY DESCRIPTION 05/05/16 PR GENERAL REVISION		PAUL STEILEN P.E. P.E. LICENSE NUMBER 107795 A2B ENGINEERING, LLC. 5406 N. HOOVER BLVD., SUITE 12 TAMPA, FL 33634	MONOKO, LLC. 1037 PENINSULA AVENUE TARPON SPRINGS, FL 34689 PHONE (727) 940-3244 FAX (727) 279-8795	DRAWN BY: PON 11/15 CHECKED BY: PDB 11/15 DESIGNED BY: MAI 11/15 CHECKED BY: PRS 11/15	VERMONT AGENCY OF TRANSPORTATION ROAD NO: COUNTY: PROJECT ID: BENNINGTON OF BPRT 116	SHEET TITLE: CONTAINMENT SECTION DETAILS (3 OF 3) FIVE BRIDGES ON OR OVER US ROUTE ?	REF. DWG NO: SHEET NO: C-8A
---	--	---	---	---	--	--	-----------------------------------