


SUBMITTAL REVIEW

Review is only for general conformity to the contract drawings and specifications and shall not relieve the contractor of his entire responsibility under the contract, including among other things, dimensions to be confirmed and correlated at the job site, and information that pertains to the fabrication processes or to techniques of construction.

- NO EXCEPTIONS TAKEN
- MAKE CORRECTIONS NOTED US 7 - RESUBMITTAL NOT REQUIRED
- AMEND AND RESUBMIT
- REJECTED - SEE REMARKS

BY: PB AMERICAS, INC.
St. Bayington
 DATE: 5/9/16

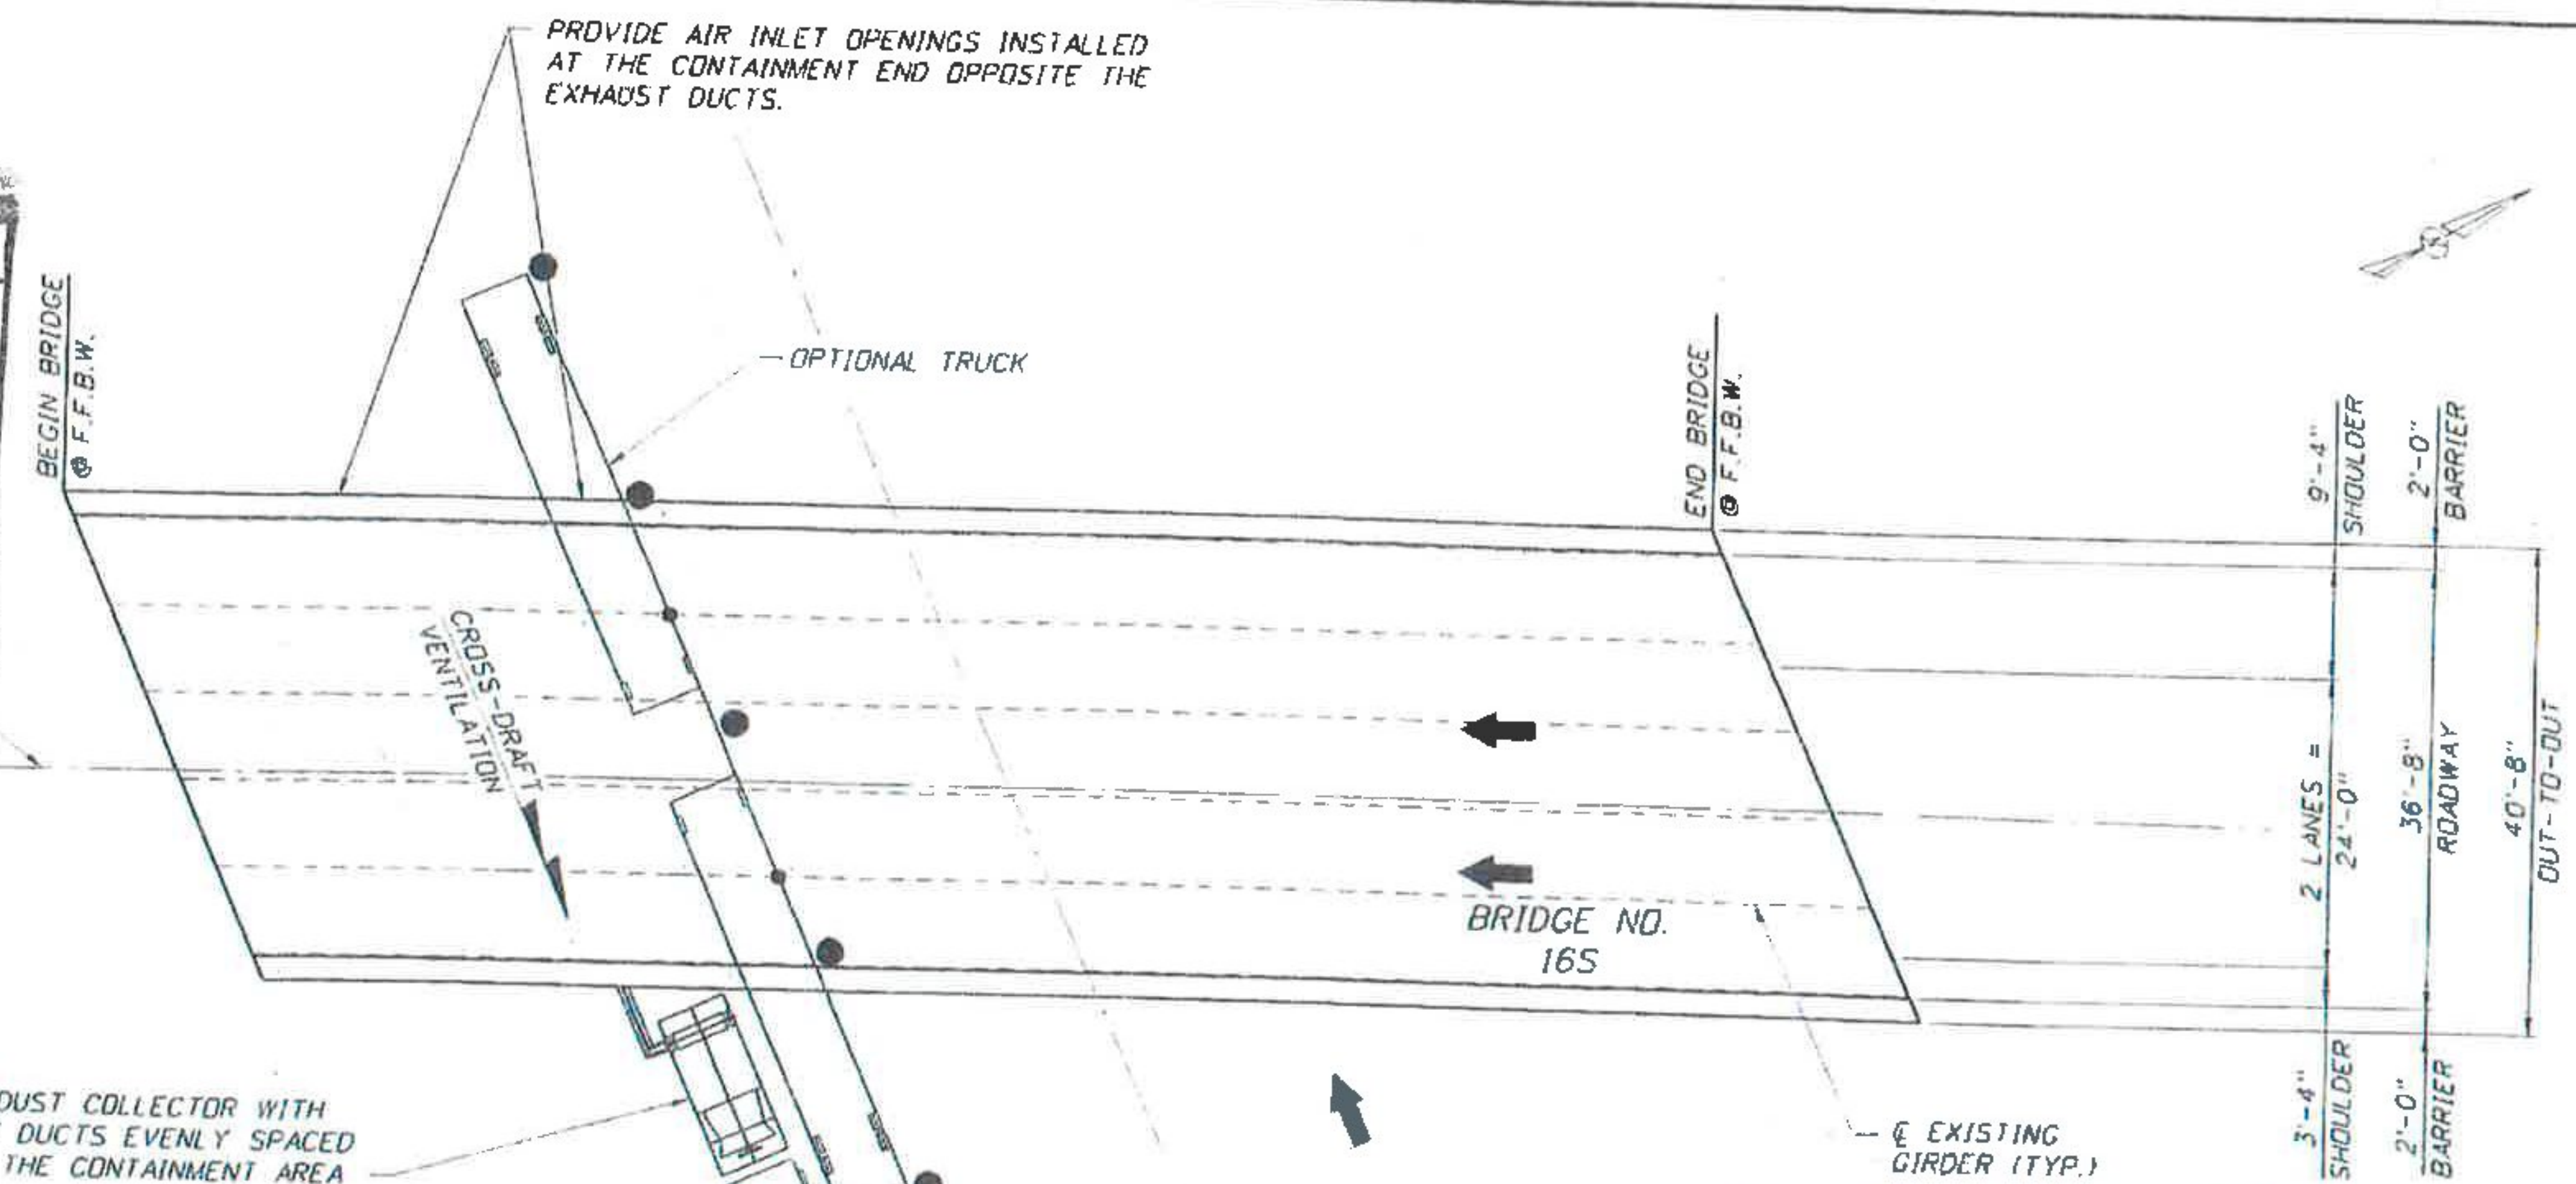

MOBILE DUST COLLECTOR WITH EXHAUST DUCTS EVENLY SPACED ACROSS THE CONTAINMENT AREA


AIR COMPRESSOR

SANDBLASTING POT

TRAFFIC CONTROL DEVICE (TYP.)

PLAN
 (BRIDGE 165 SHOWN, BRIDGE 16N SIMILAR)
 (PHASE I SHOWN, PHASE II & III SIMILAR)

- NOTES:**
- THESE PLANS WERE PREPARED WITHOUT THE BENEFIT OF AS-BUILT BRIDGE PLANS. THE CONTRACTOR SHALL MAKE ALLOWANCE FOR BRIDGE ELEMENTS AND MODIFICATIONS NOT SHOWN ON THESE PLANS.
 - WORK PHASES I-III SHOWN SCHEMATICALLY. REFERENCE MOT PLANS FOR LIMITS OF WORK PHASES.
 - WORK PHASES I-III MAY BE WORKED IN ANY ORDER AT THE CONVENIENCE OF THE CONTRACTOR'S MEANS AND METHODS, TRAFFIC PATTERNS AND DENSITY, OR OTHER SITE CHARACTERISTICS THAT INFLUENCE A PREFERRED WORK AREA.
 - THE CONTRACTOR HAS THE OPTION TO USE ADDITIONAL MOBILE DUST COLLECTORS, OR PLACE LONGITUDINAL OR TRANSVERSE INTERMEDIATE TARPULIN WALL.
 - FOR ADDITIONAL DETAILS, SEE CONTAINMENT MISCELLANEOUS DETAILS SHEETS.

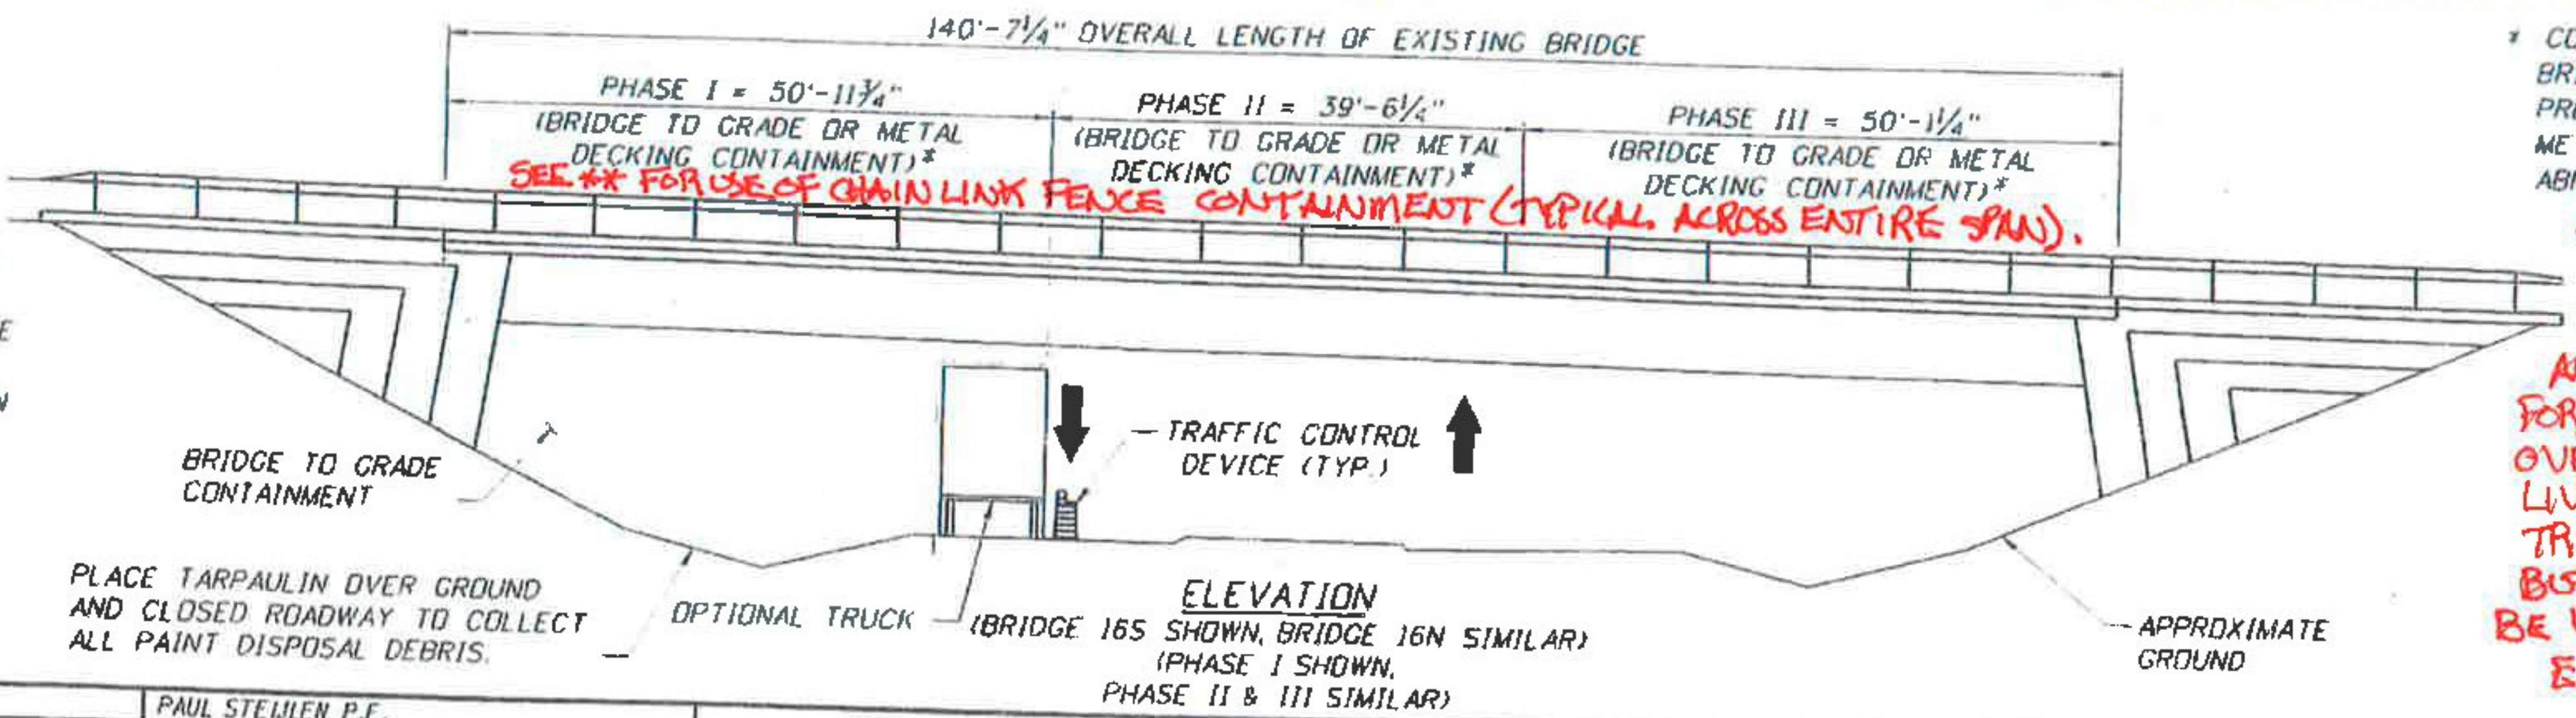

ELEVATION
 (BRIDGE 165 SHOWN, BRIDGE 16N SIMILAR)
 (PHASE I SHOWN, PHASE II & III SIMILAR)

Vermont Agency of Transportation
RECEIVED
 ON: **May 10, 2016**
 and Checked for
CONFORMANCE
 BY: Mark Sargent DATE: 05/13/2016

* CONTRACTOR MAY USE BRIDGE-TO-GRADE OPTION FOR PRESSURE WASHING OPERATIONS AND METAL DECKING CONTAINMENT FOR ABRASIVE BLASTING OPERATIONS.

**** USE OF CHAIN LINK FENCE CONTAINMENT IS NOT ALLOWED FOR AREAS OVER LIVE TRAFFIC, BUT MAY BE USED ELSEWHERE.**



Bridge No. 16N & 16S

REVISIONS		
DATE	BY	DESCRIPTION

PAUL STEFFEN P.E.
 P.E. LICENSE NUMBER 107795
 A2B ENGINEERING, LLC.
 5406 N. HOOVER BLVD., SUITE 12
 TAMPA, FL 33634

MONOKO, LLC.
 1037 PENINSULA AVENUE
 TARPON SPRINGS, FL 34689
 PHONE (727) 940-3244
 FAX (727) 279-8785

DESIGNED BY: BON 11/15
 CHECKED BY: PDB 11/15
 DESIGNED BY: MAT 11/15
 CHECKED BY: PRS 11/15

VERMONT AGENCY OF TRANSPORTATION
 ROAD NO. COUNTY PROJECT #
 BENNINGTON BF BPNT (16)

SHEET TITLE: **PLAN & ELEVATION**
 PROJECT NAME: **FIVE BRIDGES ON OR OVER US ROUTE 7**

REF. DWG. NO.
 SHEET NO.
 C-9