


PLAN  
(PHASE I SHOWN)

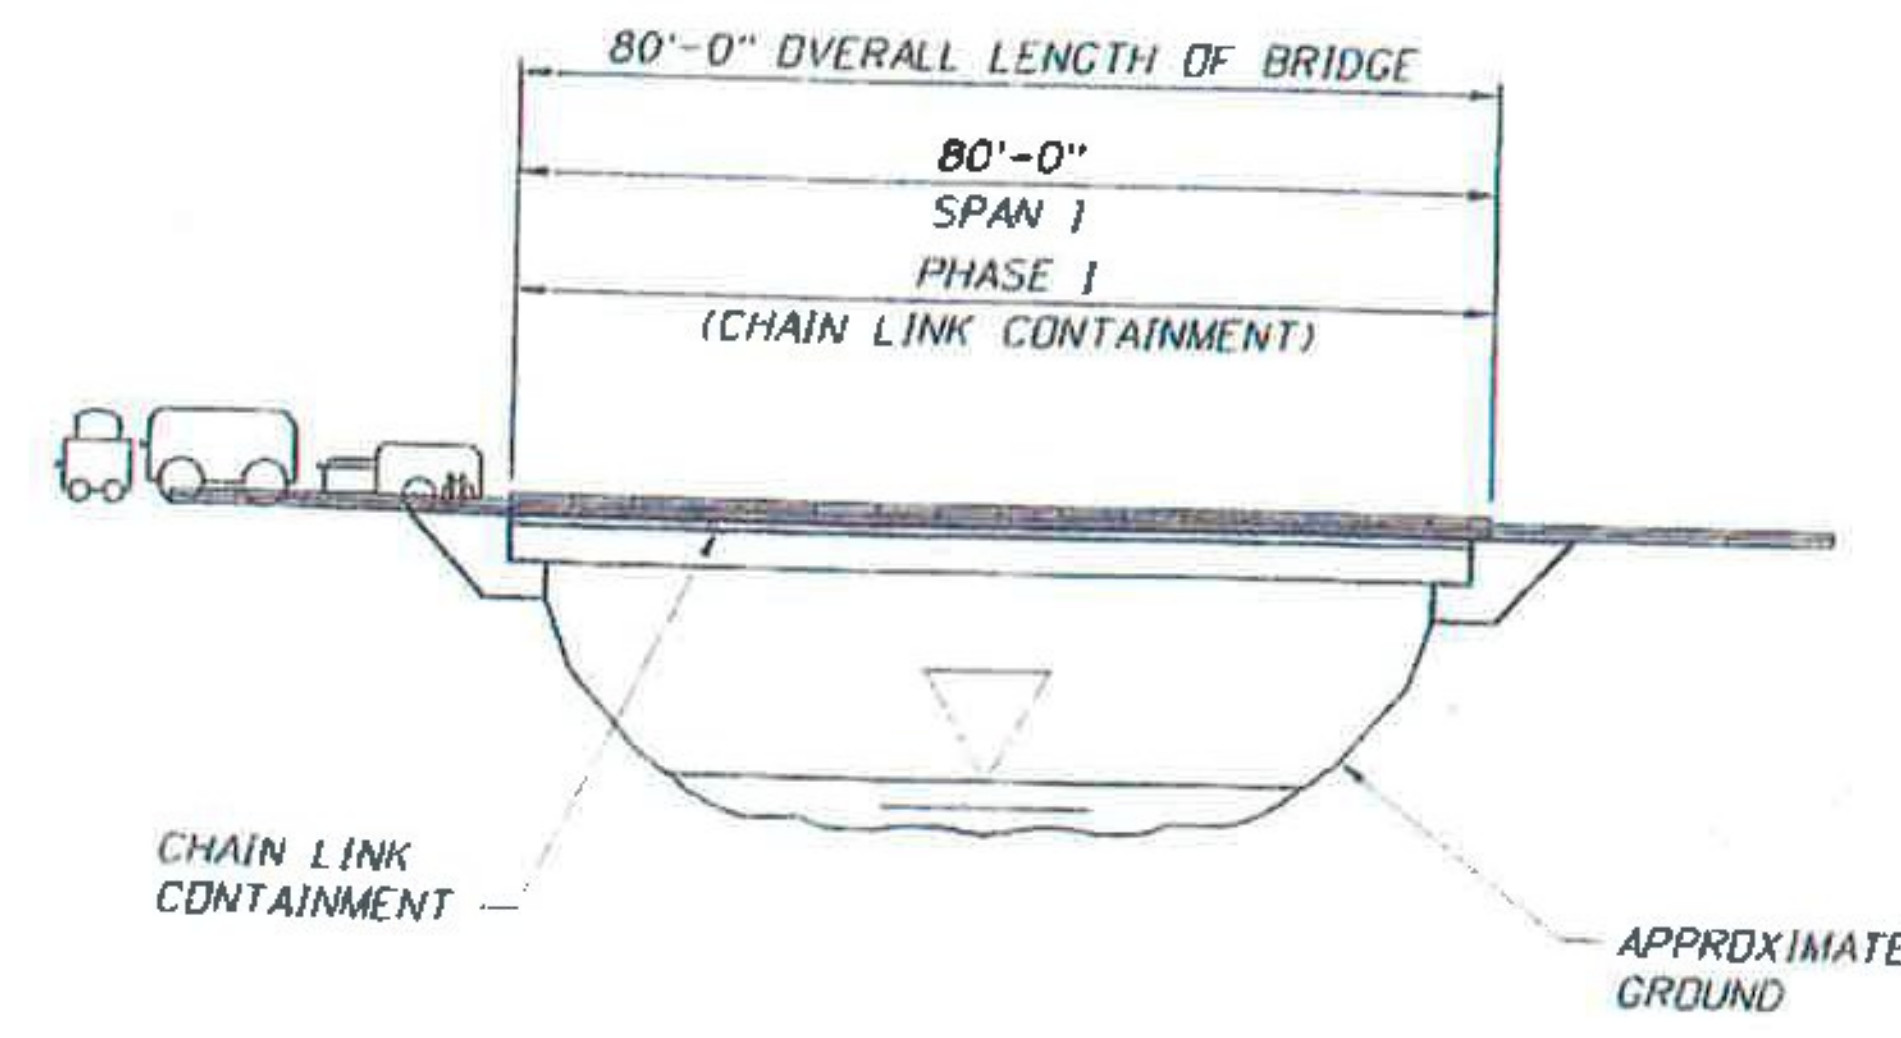

ELEVATION  
(PHASE I SHOWN)

- NOTES:
1. THESE PLANS WERE PREPARED WITHOUT THE BENEFIT OF AS-BUILT BRIDGE PLANS. THE CONTRACTOR SHALL MAKE ALLOWANCE FOR BRIDGE ELEMENTS AND MODIFICATIONS NOT SHOWN ON THESE PLANS.
  2. WORK PHASE I SHOWN SCHEMATICALLY. REFERENCE MDT PLANS FOR LIMITS OF WORK PHASES.
  3. WORK PHASE I MAY BE WORKED IN ANY ORDER AT THE CONVENIENCE OF THE CONTRACTOR'S MEANS AND METHODS, TRAFFIC PATTERNS AND DENSITY, OR OTHER SITE CHARACTERISTICS THAT INFLUENCE A PREFERRED WORK AREA.
  4. THE CONTRACTOR HAS THE OPTION TO USE ADDITIONAL MOBILE DUST COLLECTORS, OR PLACE LONGITUDINAL OR TRANSVERSE INTERMEDIATE TARPULIN WALLS.
  5. FOR ADDITIONAL DETAILS, SEE CONTAINMENT MISCELLANEOUS DETAILS SHEETS.

SUBMITTAL REVIEW	
Review is only for general conformity to the contract drawings and specifications and shall not relieve the contractor of his entire responsibility under the contract, including among other things, dimensions to be confirmed and correlated at the job site, and information that pertains to the fabrication processes or to techniques of construction.	
<input checked="" type="checkbox"/>	NO EXCEPTIONS TAKEN
<input type="checkbox"/>	MAKE CORRECTIONS NOTED
<input type="checkbox"/>	RESUBMITTAL NOT REQUIRED
<input type="checkbox"/>	AMEND AND RESUBMIT
<input type="checkbox"/>	REJECTED - SEE REMARKS
BY: <b>PB AMERICAS, INC.</b>	
DATE:	<i>5/9/16</i>

Vermont Agency of Transportation  
**RECEIVED**  
 ON: **May 10, 2016**  
 and Checked for  
**CONFORMANCE**  
 BY: Mark Sargent DATE: 05/13/2016



REVISIONS		DATE	BY	DESCRIPTION	DRAWING NO.	PROJECT NO.	SHEET NO.

PAUL STEJLEN P.E. P.E. LICENSE NUMBER 07795 A2B ENGINEERING, LLC. 5406 N. HOOVER BLVD., SUITE 12 TAMPA, FL 33634		<b>MONOKO, LLC.</b> 1037 PENINSULA AVENUE TARPON SPRINGS, FL 34689 PHONE (727) 840-3244 FAX (727) 279-0795		DRAWN BY: BDN 11/15 CHECKED BY: PDB 11/15 DESIGNED BY: MAT 11/15 CHECKED BY: PRS 11/15	VERMONT AGENCY OF TRANSPORTATION ROAD NO: RUTLAND COUNTY: BF BPNT 116	BRIDGE NO.: 56C PROJECT NAME: FIVE BRIDGES ON OR OVER US ROUTE 7	SHEET NO.: C-12
--	--	--	--	---	--	---	-----------------

P:\167 Monoko, LLC\17 Berrington-Bl Tabors\1 Containment Plans\Cadd\BSP10nElev.dwg