

NOTE:
ATTACHMENT CABLES MAY BE RIGGED ACROSS ENTIRE WIDTH OF BRIDGE, BETWEEN FASCIA GIRDER BEARINGS AND/OR BETWEEN INDIVIDUAL PAIRS OF BEARINGS.

SUBMITTAL REVIEW


Review is only for general conformity to the contract documents and shall not relieve the contractor of his entire responsibility under the contract, including among other things, dimensions to be confirmed and correlated at the job site, and information that pertains to the fabrication processes or to techniques of construction.

NO EXCEPTIONS TAKEN
 MAKE CORRECTIONS NOTED
 RESUBMITTAL NOT REQUIRED
 AMEND AND RESUBMIT
 REJECTED - SEE REMARKS

BY: *82 [Signature]*
 DATE: *5/9/16*

PB AMERICAS, INC.

* SANDBLASTING POT SHALL BE CENTERED OVER PIER. IF EQUIPMENT EXCEEDS LEGAL LOAD LIMITS WHEN FULL, EQUIPMENT SHALL BE USED PARTIALLY FULL ONLY AS REQUIRED TO STAY WITHIN LEGAL LOAD LIMITS. ANY LOAD THAT EXCEEDS LEGAL LOAD LIMIT SHALL BE SUBMITTED TO THE DEPARTMENT FOR REVIEW AND APPROVAL.

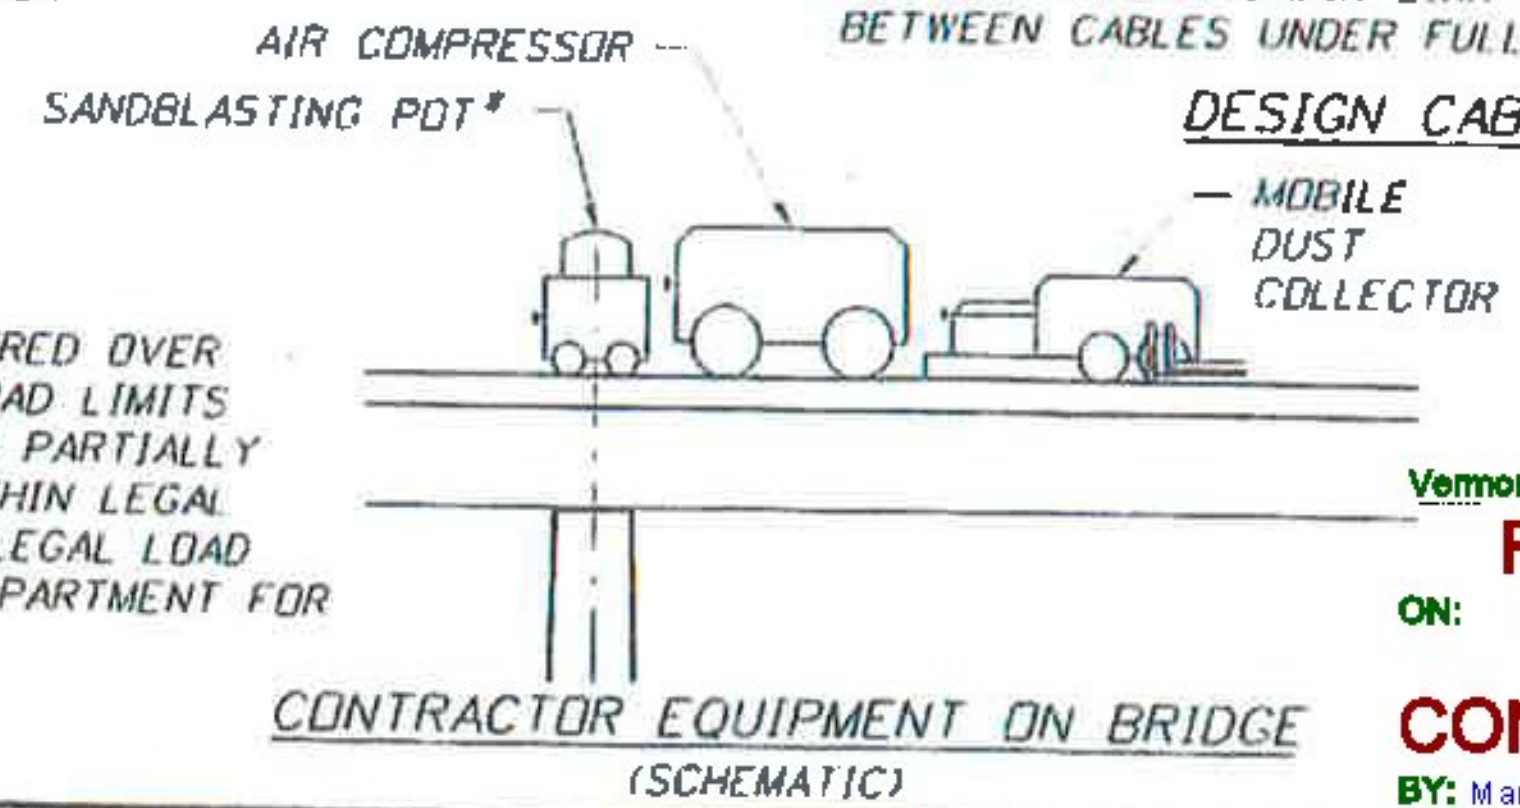

Vermont Agency of Transportation
RECEIVED
 ON: May 10, 2016
 and Checked for
CONFORMANCE
 BY: Mark Sargent DATE: 05/13/2016

REVISIONS		DESCRIPTION	DATE	BY
NO.	DATE			

PAUL STEGLER P.E. P.E. LICENSE NUMBER 107795 A2B ENGINEERING, LLC. 5406 N. HOOVER BLVD., SUITE 12 TAMPA, FL 33634	MONOKO, LLC. 1037 PENINSULA AVENUE TARPON SPRINGS, FL 34689 PHONE (727) 940-3244 FAX (727) 279-8795	DRAWN BY: BDN 11/15 CHECKED BY: PDS 11/15 DESIGNED BY: MAT 11/15 CHECKED BY: PRS 11/15	VERMONT AGENCY OF TRANSPORTATION ROAD NO. COUNTY PROJECT ID BENNINGTON RUTLAND BF BPNT (116)	SHEET TITLE: CONTAINMENT MISCELLANEOUS DETAILS (2 OF 4) PROJECT NAME: FIVE BRIDGES ON OR OVER US ROUTE 7	REF. DWG. NO. SHEET NO. C-15
---	--	---	--	---	------------------------------------