
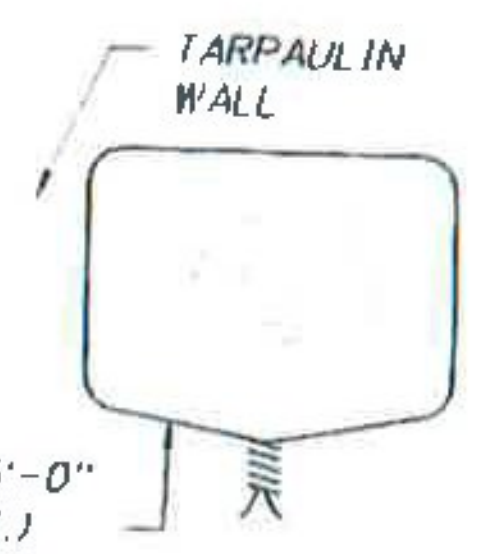
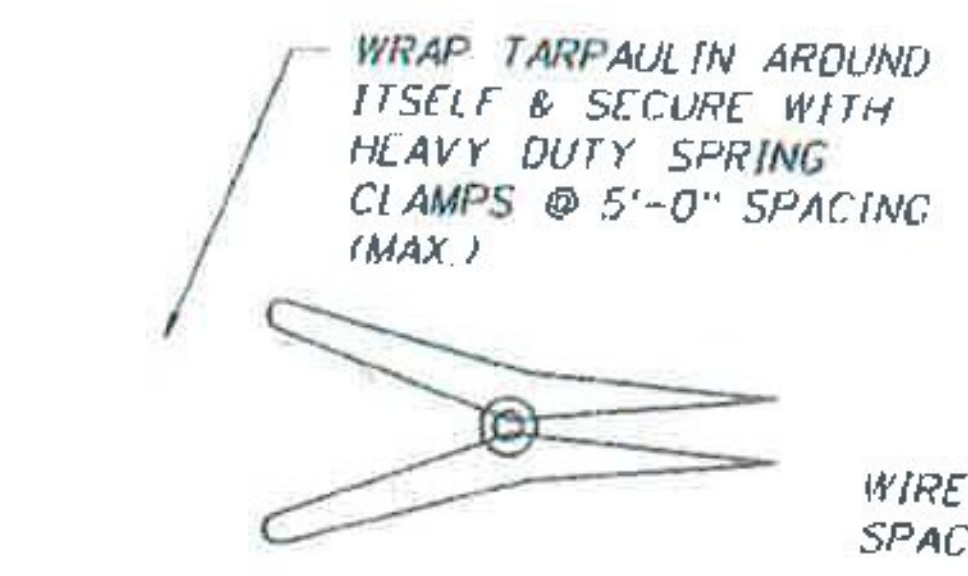
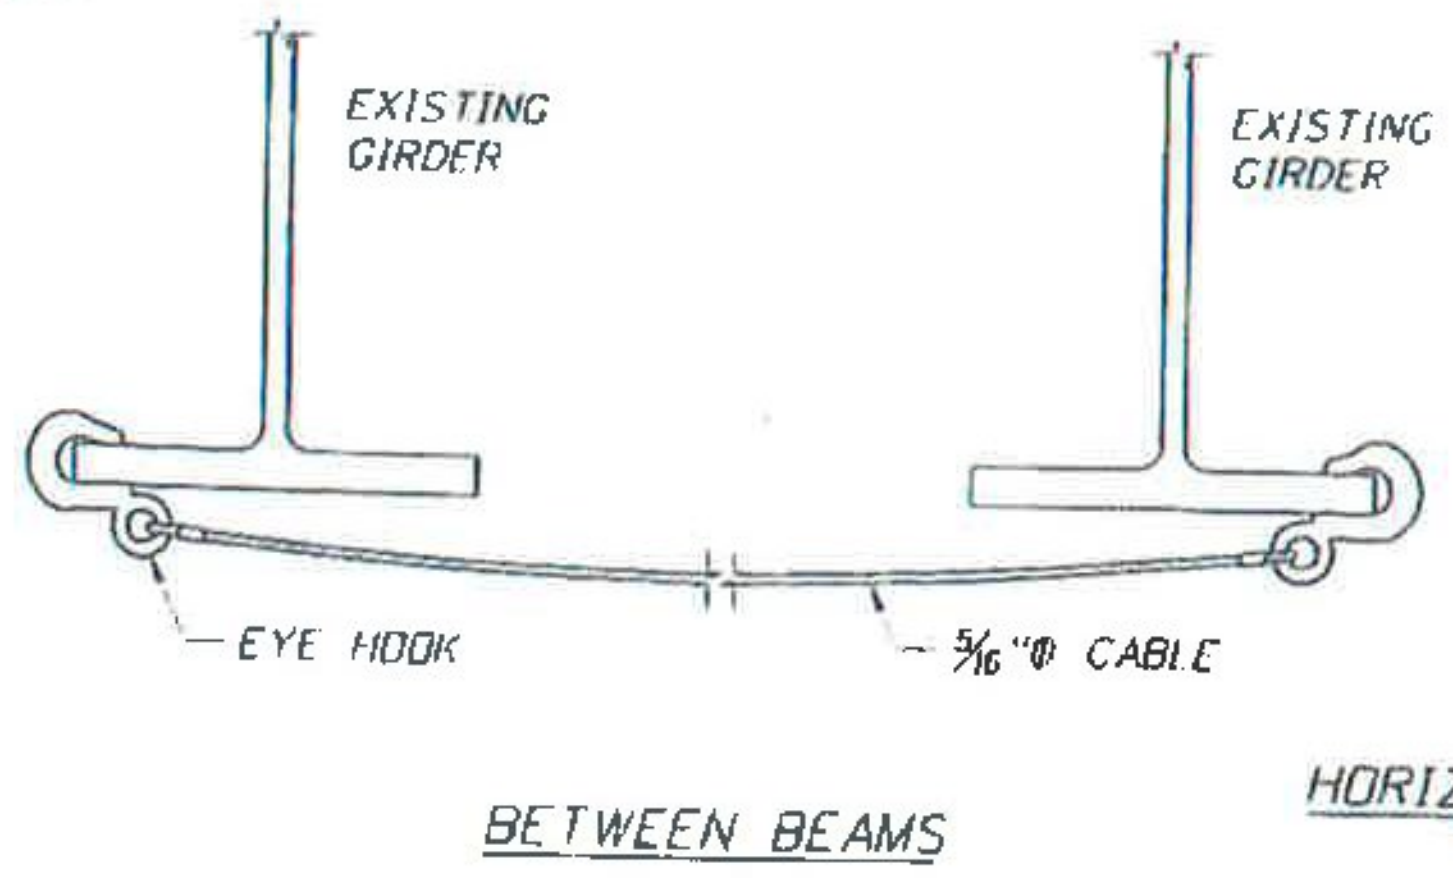
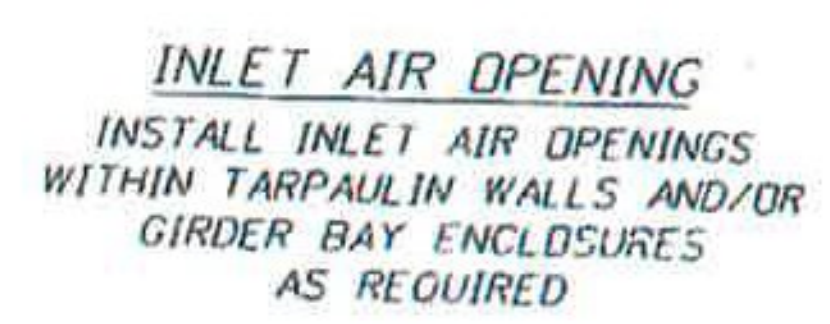
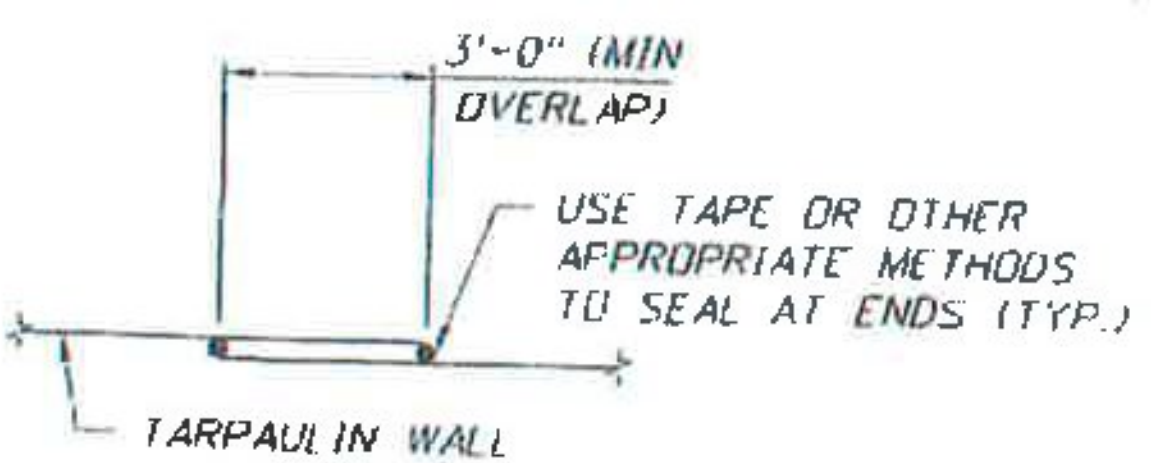
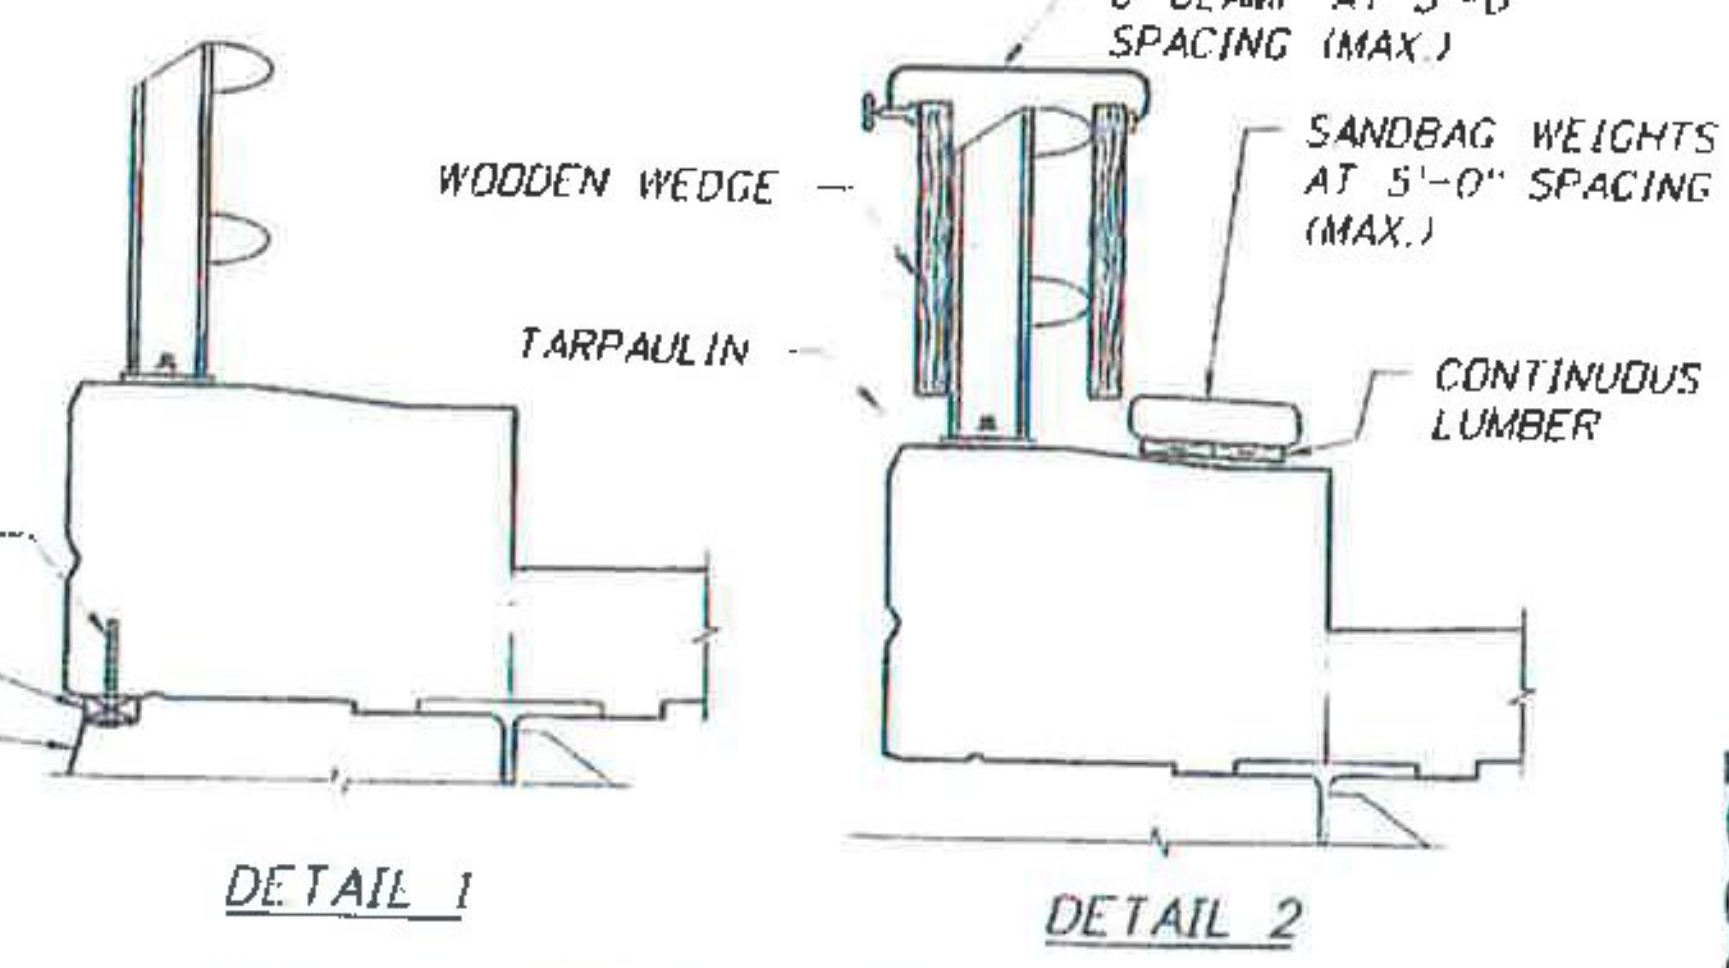


EXTERIOR SUPPORT HANGER
(CHAIN LINK PLATFORM SHOWN, NETTING OR METAL DECKING IS SIMILAR)

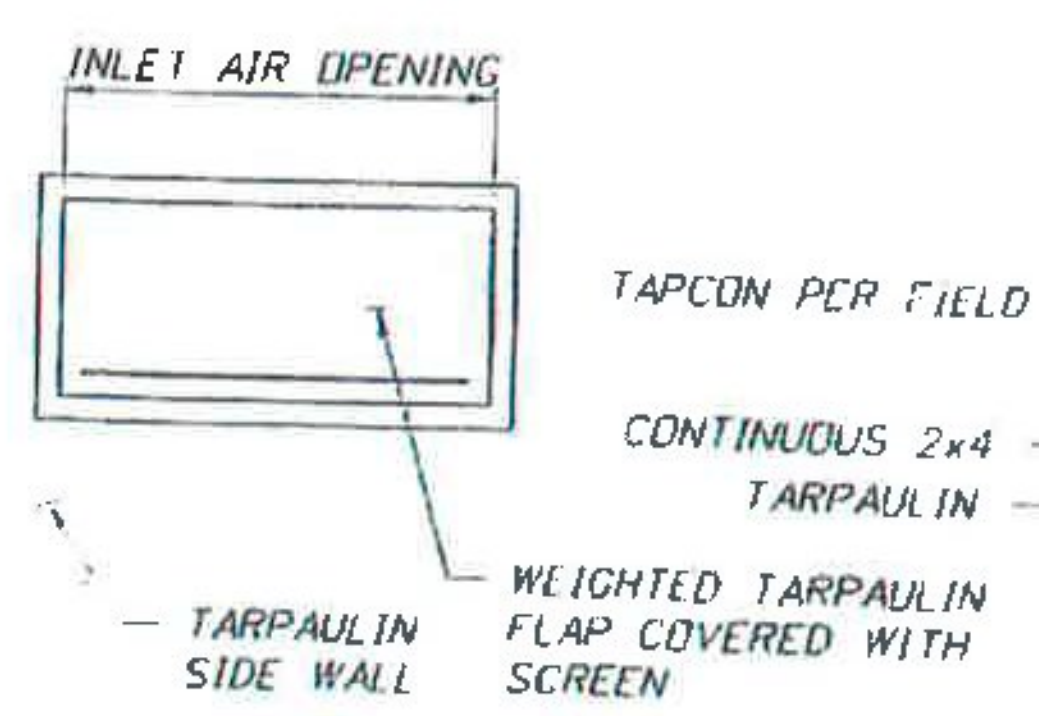

ADJACENT TARPULIN CONNECTION ALTERNATIVES

SUBMITTAL REVIEW

This review is only for general conformity to the contract drawing and specifications and shall not constitute an approval of the contractor's work. The contractor shall be responsible for the accuracy of the information submitted and for the quality of the work. Any exceptions noted shall be corrected and resubmitted.

RESUBMITTAL NOT REQUIRED
 AMEND AND RESUBMIT
 REJECTED - SEE REMARKS

PB AMERICAS, INC.
 BY: *sebyingda*
 DATE: *5/9/16*

Vermont Agency of Transportation
RECEIVED
 ON: May 10, 2016
 and Checked for
CONFORMANCE
 BY: Mark Sargent DATE: 05/13/2016



REVISIONS		DESCRIPTION	DATE	BY

PAUL STEJLEN P.E. P.E. LICENSE NUMBER 107795 A2B ENGINEERING, LLC. 5406 N. HOOVER BLVD., SUITE 12 TAMPA, FL 33634		MONOKO, LLC. 1037 PENINSULA AVENUE TARPON SPRINGS, FL 34689 PHONE (727) 940-3244 FAX (727) 279-8785		DRAWN BY: BDN 11/15 CHECKED BY: PDB 11/15 DESIGNED BY: MAT 11/15 CHECKED BY: PRS 11/15	VERMONT AGENCY OF TRANSPORTATION ROAD NO. COUNTY PROJECT ID BENNINGTON RUTLAND BF BPNT 1161	SHEET TITLE: CONTAINMENT MISCELLANEOUS DETAILS (4 OF 4) PROJECT NAME: FIVE BRIDGES ON OR OVER US ROUTE 7	REF. DRAW. NO. SHEET NO. C-17
---	--	--	--	---	---	---	-------------------------------------

P:\107 Monoko, LLC\17 Bennington\17 Tabu\1 Containment Plans\Cadd\BUD\111501.dgn