


TYPICAL SECTION - ALTERNATE A
PAVER PLACED SURFACE TREATMENT, TYPE C
MM 4.135 (WAITSFIELD) - MM 0.450 (MORETOWN)

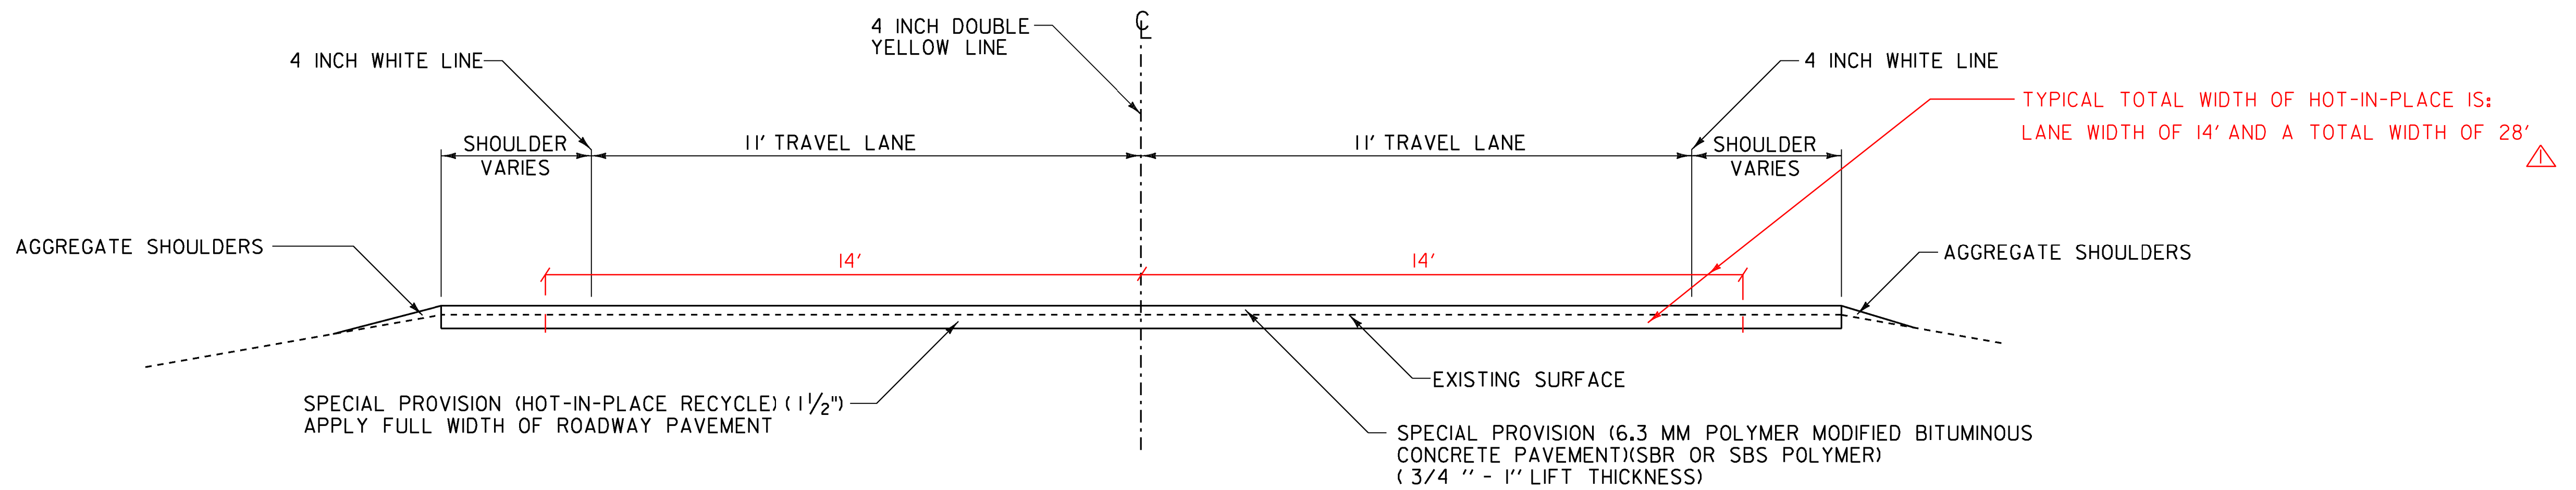

TYPICAL SECTION - ALTERNATE B
6.3 MM POLYMER MODIFIED BITUMINOUS CONCRETE PAVEMENT (SBR OR SBS POLYMER)
MM 4.135 (WAITSFIELD) - MM 0.450 (MORETOWN)

NOTES:

1. PRIOR TO THE PLACEMENT OF THE POLYMER MODIFIED BITUMINOUS CONCRETE PAVEMENT, EMULSIFIED ASPHALT SHALL BE APPLIED TO ALL SPECIAL PROVISION (HOT-IN-PLACE RECYCLE) SURFACES, EXISTING SURFACES, AND ON ALL COLD PLANED SURFACES AT A RATE OF 0.080 GAL/SY (+/- 0.01GAL/SY) OR AS DIRECTED BY THE RESIDENT ENGINEER. EMULSIFIED ASPHALT SHALL BE RS-IH OR CRS-IH PER THE MANUFACTURER'S RECOMMENDATION AND PAID UNDER ITEM 900.683 SPECIAL PROVISION (EMULSIFIED ASPHALT)(RS-IH OR CRS-IH).

2. THE GYRATION SPECIFICATION FOR THE 6.3 MM POLYMER - MODIFIED BITUMINOUS CONCRETE PAVEMENT SHALL BE 65. PG BINDER SHALL BE 58-28.

KEY	DATE	BY	REVISION
△	10/21/15	CPP	HOT-IN-PLACE TYP. WIDTH

TYPICAL SECTIONS

PROJECT NAME: WAITSFIELD-MORETOWN
 PROJECT NUMBER: STP SURF(39)

FILE NAME: I3BI68\pi3BI68.dgn PLOT DATE: 06-MAY-2014
 PROJECT LEADER: FOWLER DRAWN BY: BULLOCK
 DESIGNED BY: BULLOCK CHECKED BY: M. FOWLER
 IPARM FILE NAME: pi368+yp2.1 SHEET 4 OF 26

NOT TO SCALE