


TYPICAL SECTION - ALTERNATE A
PAVER PLACED SURFACE TREATMENT, TYPE C
MM 0.450 (MORETOWN) - MM 1.227 (MORETOWN)

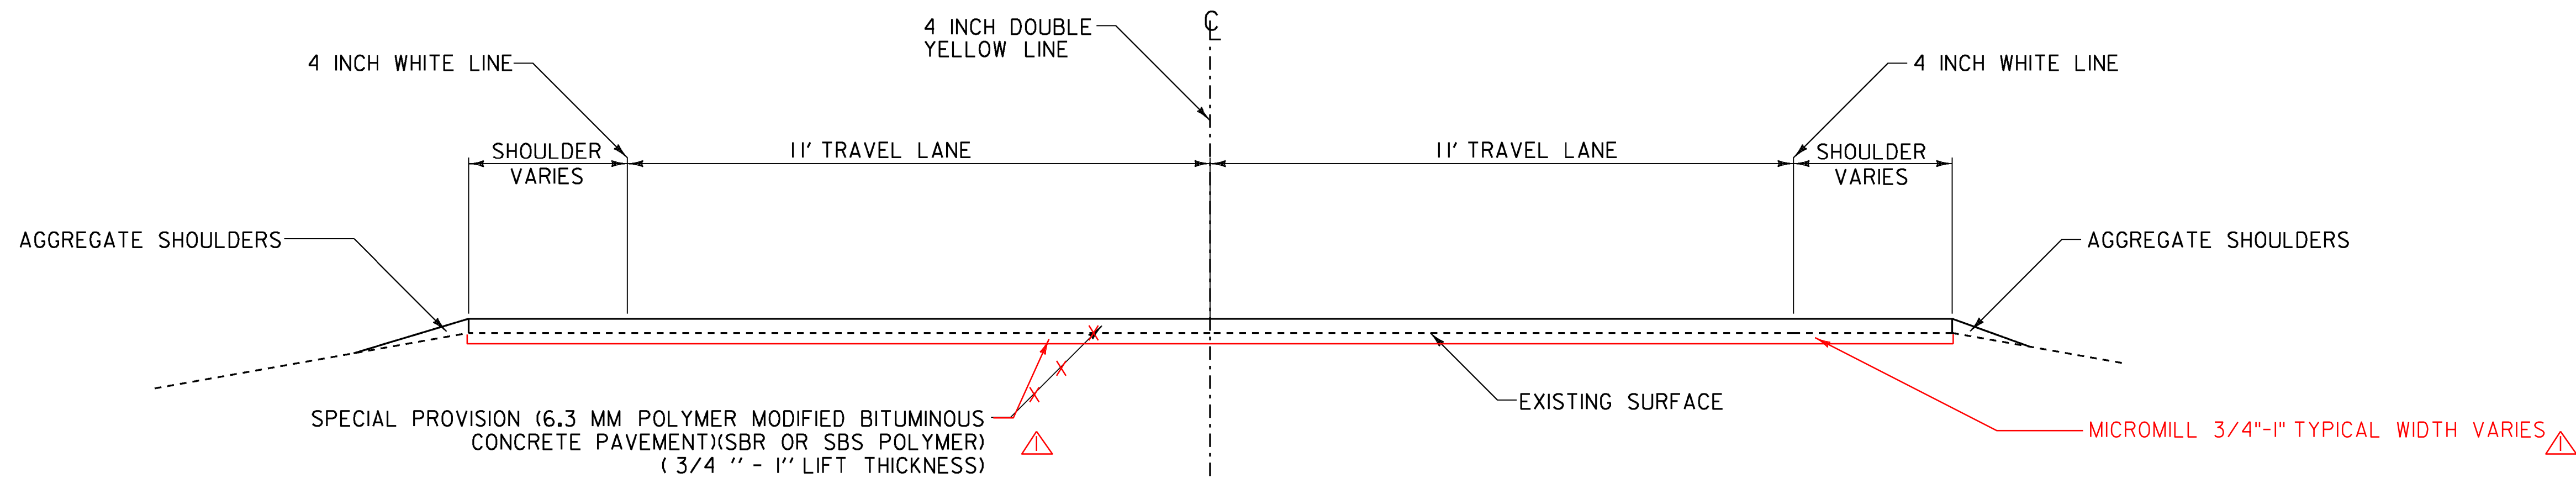

TYPICAL SECTION - ALTERNATE B
6.3 MM POLYMER MODIFIED BITUMINOUS CONCRETE PAVEMENT (SBR OR SBS POLYMER)
MM 0.450 (MORETOWN) - MM 1.227 (MORETOWN)

NOTES:

1. PRIOR TO THE PLACEMENT OF THE POLYMER MODIFIED BITUMINOUS CONCRETE PAVEMENT, EMULSIFIED ASPHALT SHALL BE APPLIED TO ALL EXISTING PAVEMENT SURFACES AND ON ALL COLD PLANED SURFACES AT A RATE OF 0.080 GAL/SY (+/- 0.01GAL/SY) OR AS DIRECTED BY THE RESIDENT ENGINEER. EMULSIFIED ASPHALT SHALL BE RS-IH OR CRS-IH PER THE MANUFACTURER'S RECOMMENDATION AND PAID UNDER ITEM 900.683 SPECIAL PROVISION (EMULSIFIED ASPHALT)(RS-IH OR CRS-IH).
2. THE GYRATION SPECIFICATION FOR THE 6.3 MM POLYMER - MODIFIED BITUMINOUS CONCRETE PAVEMENT SHALL BE 65. PG BINDER SHALL BE 58-28.

KEY	DATE	BY	REVISION
△	10/21/15	CPP	MICROMILL PER CHANGE ORDER #1

NOT TO SCALE

TYPICAL SECTION	PROJECT NAME:	WAITSFIELD-MORETOWN	
	PROJECT NUMBER:	STP SURF(39)	
	FILE NAME:	I3BI68\p13BI68.dgn	
	PLOT DATE:	06-MAY-2014	
	PROJECT LEADER:	FOWLER	
	DESIGNED BY:	BULLOCK	
	CHECKED BY:	M. FOWLER	
	IPARM FILE NAME:	p13bi68+yp3.1	
		DRAWN BY:	BULLOCK
		CHECKED BY:	M. FOWLER
		SHEET	5 OF 26