
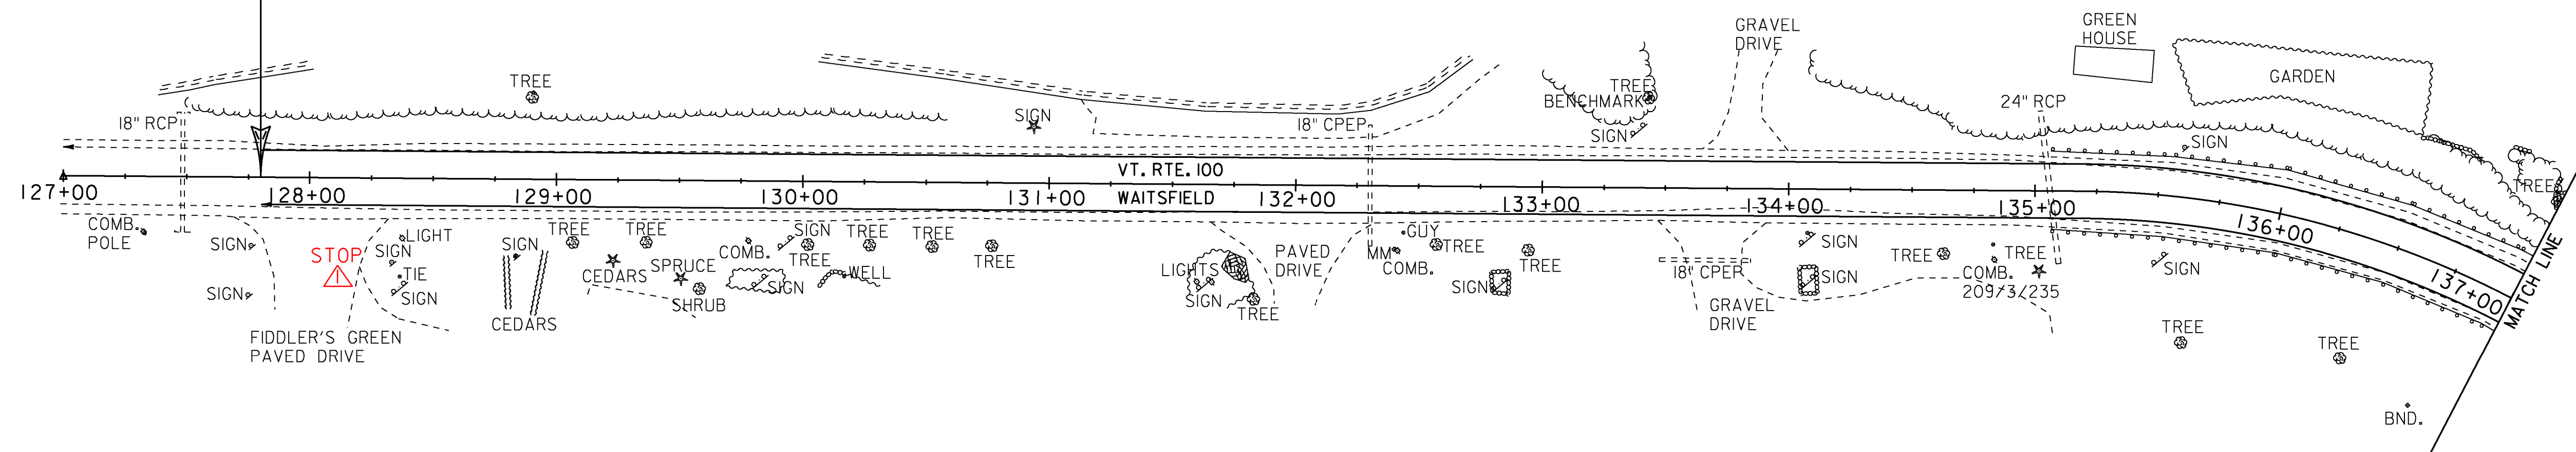


DURABLE 4 INCH WHITE LINE, POLYUREA
 TEMPORARY 4 INCH WHITE LINE, PAINT
 VT. RTE. 100 STA. 127+80 LT. - STA. 137+00 LT.
 VT. RTE. 100 STA. 127+80 RT. - STA. 137+00 RT.

DURABLE 4 INCH YELLOW LINE, POLYUREA
 TEMPORARY 4 INCH YELLOW LINE, PAINT
 VT. RTE. 100 STA. 127+80 C/L - STA. 137+00 C/L

DURABLE LETTER OR SYMBOL
 THERMOPLASTIC
 ▲ VT RTE.100 STA 128+00 O/S RT

VT. RTE. 100 MM 2.422 (STA. 127+88.00)
 END WARREN-WAITSFIELD STP 2506(I)
 BEGIN WAITSFIELD-MORETOWN STP SURF(39)

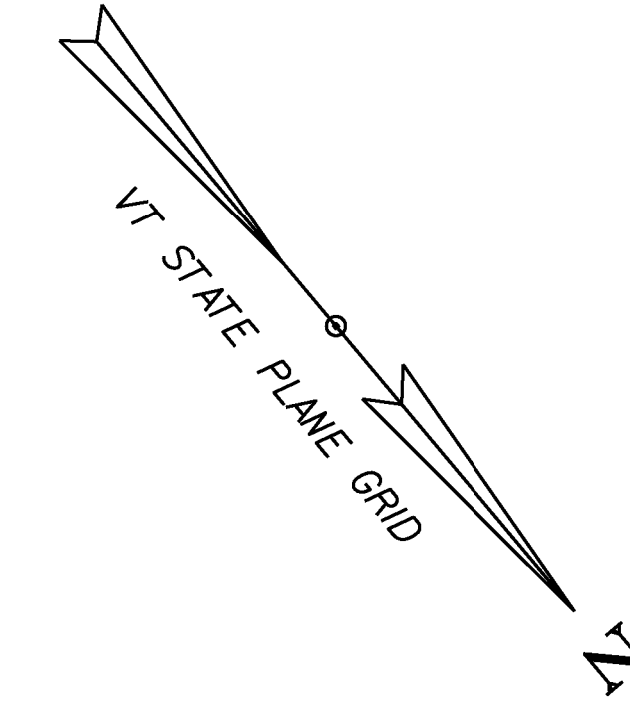

| KEY | DATE | BY | REVISION |
|-----|----------|-----|-------------------------------------|
| ▲ | 10/21/15 | CPP | ADDITIONAL DURABLE LETTER OR SYMBOL |

SCALE 1" = 40'-0"
 40 0 40

| | | | | | | | | |
|--------------------------------|-----------------------------------------------------------------------------------------------------------------------------------------------------------------------------------------------------------------------------------------------------------------------------------------------------------------------------------------------|---------------------------|------------------------|---------------------------|----------------------|-------------------------|-----------------------|--------------|
| PROJECT LAYOUT SHEET #1 | PROJECT NAME: WAITSFIELD-MORETOWN | | | | | | | |
| | PROJECT NUMBER: STP SURF(39) | | | | | | | |
| | <table border="0" style="width: 100%;"> <tr> <td>FILE NAME: pi3bi68bdr.dgn</td> <td>PLOT DATE: 06-MAY-2014</td> </tr> <tr> <td>PROJECT LEADER: M. FOWLER</td> <td>DRAWN BY: L. BULLOCK</td> </tr> <tr> <td>DESIGNED BY: L. BULLOCK</td> <td>CHECKED BY: M. FOWLER</td> </tr> <tr> <td>pi3bi68lay.l</td> <td>SHEET 8 OF 26</td> </tr> </table> | FILE NAME: pi3bi68bdr.dgn | PLOT DATE: 06-MAY-2014 | PROJECT LEADER: M. FOWLER | DRAWN BY: L. BULLOCK | DESIGNED BY: L. BULLOCK | CHECKED BY: M. FOWLER | pi3bi68lay.l |
| FILE NAME: pi3bi68bdr.dgn | PLOT DATE: 06-MAY-2014 | | | | | | | |
| PROJECT LEADER: M. FOWLER | DRAWN BY: L. BULLOCK | | | | | | | |
| DESIGNED BY: L. BULLOCK | CHECKED BY: M. FOWLER | | | | | | | |
| pi3bi68lay.l | SHEET 8 OF 26 | | | | | | | |