

DURABLE CROSSWALK MARKING, THERMOPLASTIC OR  
 DURABLE CROSSWALK MARKING, POLYUREA  
 TEMPORARY CROSSWALK MARKING, PAINT

VT. RTE. 100 STA. 155+07 LT. - RT.  
 VT. RTE. 100 STA. 149+93-150+44 LT



DURABLE 24 INCH STOP BAR, THERMOPLASTIC  
 VT. RTE. 100 STA. 150+18 LT

DURABLE 4 INCH WHITE LINE, POLYUREA  
 TEMPORARY 4 INCH WHITE LINE, PAINT

VT. RTE. 100 STA. 146+00 LT. - STA. 157+00 LT.  
 VT. RTE. 100 STA. 146+00 RT. - STA. 157+00 RT.

DURABLE 4 INCH YELLOW LINE, POLYUREA  
 TEMPORARY 4 INCH YELLOW LINE, PAINT

VT. RTE. 100 STA. 146+00 C/L - STA. 157+00 C/L

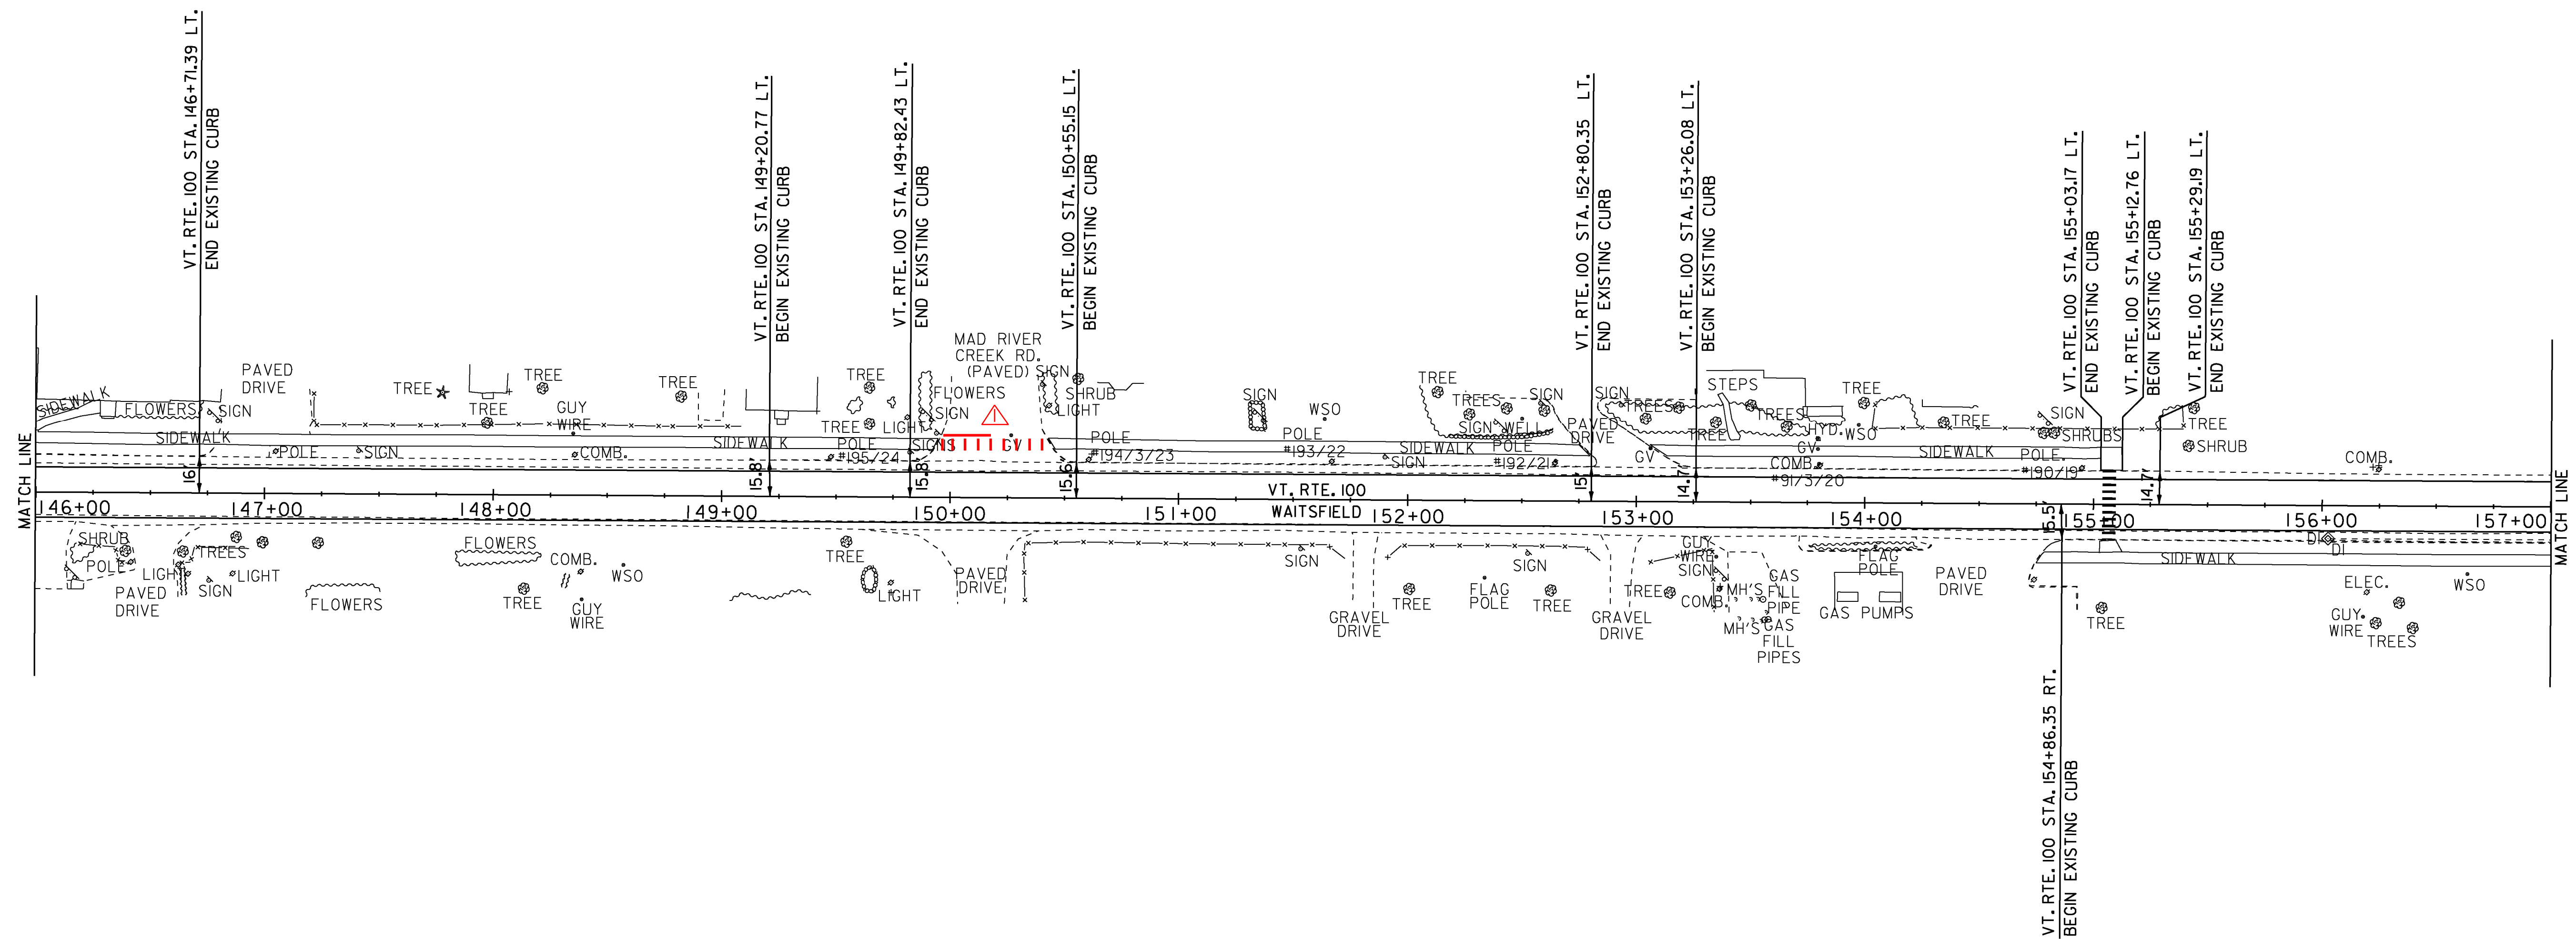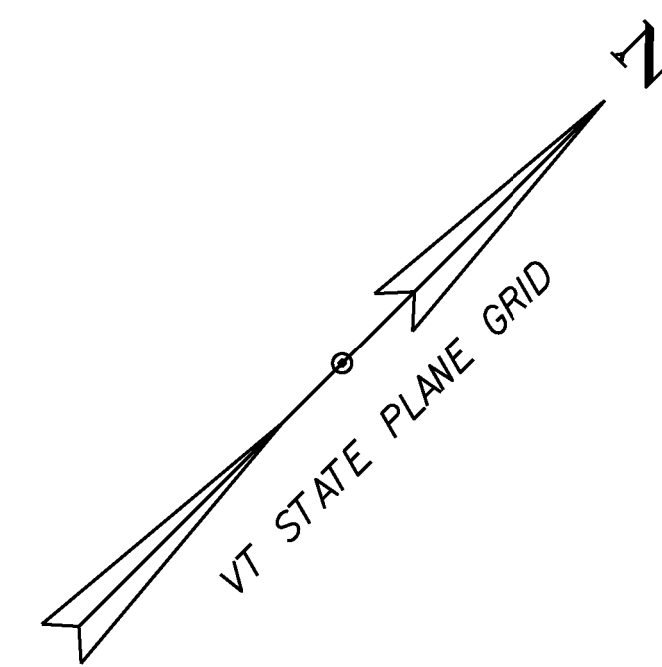

| KEY | DATE     | BY  | REVISION                             |
|-----|----------|-----|--------------------------------------|
| △   | 10/21/15 | CPP | ADDITIONAL 24 INCH DURABLE STOP BAR  |
| △   | 10/21/15 | CPP | ADDITIONAL DURABLE CROSSWALK MARKING |

SCALE 1" = 40'-0"  
 40 0 40

**PROJECT LAYOUT SHEET #3**

PROJECT NAME: WAITSFIELD-MORETOWN  
 PROJECT NUMBER: STP SURF(39)  
 FILE NAME: pi3bi68bdr.dgn PLOT DATE: 06-MAY-2014  
 PROJECT LEADER: M. FOWLER DRAWN BY: L. BULLOCK  
 DESIGNED BY: L. BULLOCK CHECKED BY: M. FOWLER  
 pi3bi68lay3.i SHEET 10 OF 26