



604.412(0060):REHAB DROP INLETS, CATCH BASINS,  
OR MANHOLES, CLASS 1  
▲ STA. 157+75 RT

DURABLE LETTER OR SYMBOL, THERMOPLASTIC OR  
▲ DURABLE LETTER OR SYMBOL, POLYUREA  
VT.RTE.100 STA. 158+40 LT "STOP"  
VT.RTE.100 STA. 167+30 LT "STOP"

DURABLE 4 INCH WHITE LINE, POLYUREA  
TEMPORARY 4 INCH WHITE LINE, PAINT  
VT. RTE. 100 STA. 157+00 LT. - STA. 168+00 LT.  
VT. RTE. 100 STA. 157+00 RT. - STA. 168+00 RT.

DURABLE 4 INCH YELLOW LINE, POLYUREA  
TEMPORARY 4 INCH YELLOW LINE, PAINT  
VT. RTE. 100 STA. 157+00 C/L - STA. 168+00 C/L

DURABLE 24 INCH STOP BAR, THERMOPLASTIC OR  
▲ DURABLE 24 INCH STOP BAR, POLYUREA  
VT.RTE.100 STA. 158+40 LT "STOP"  
VT.RTE.100 STA. 167+30 LT "STOP"

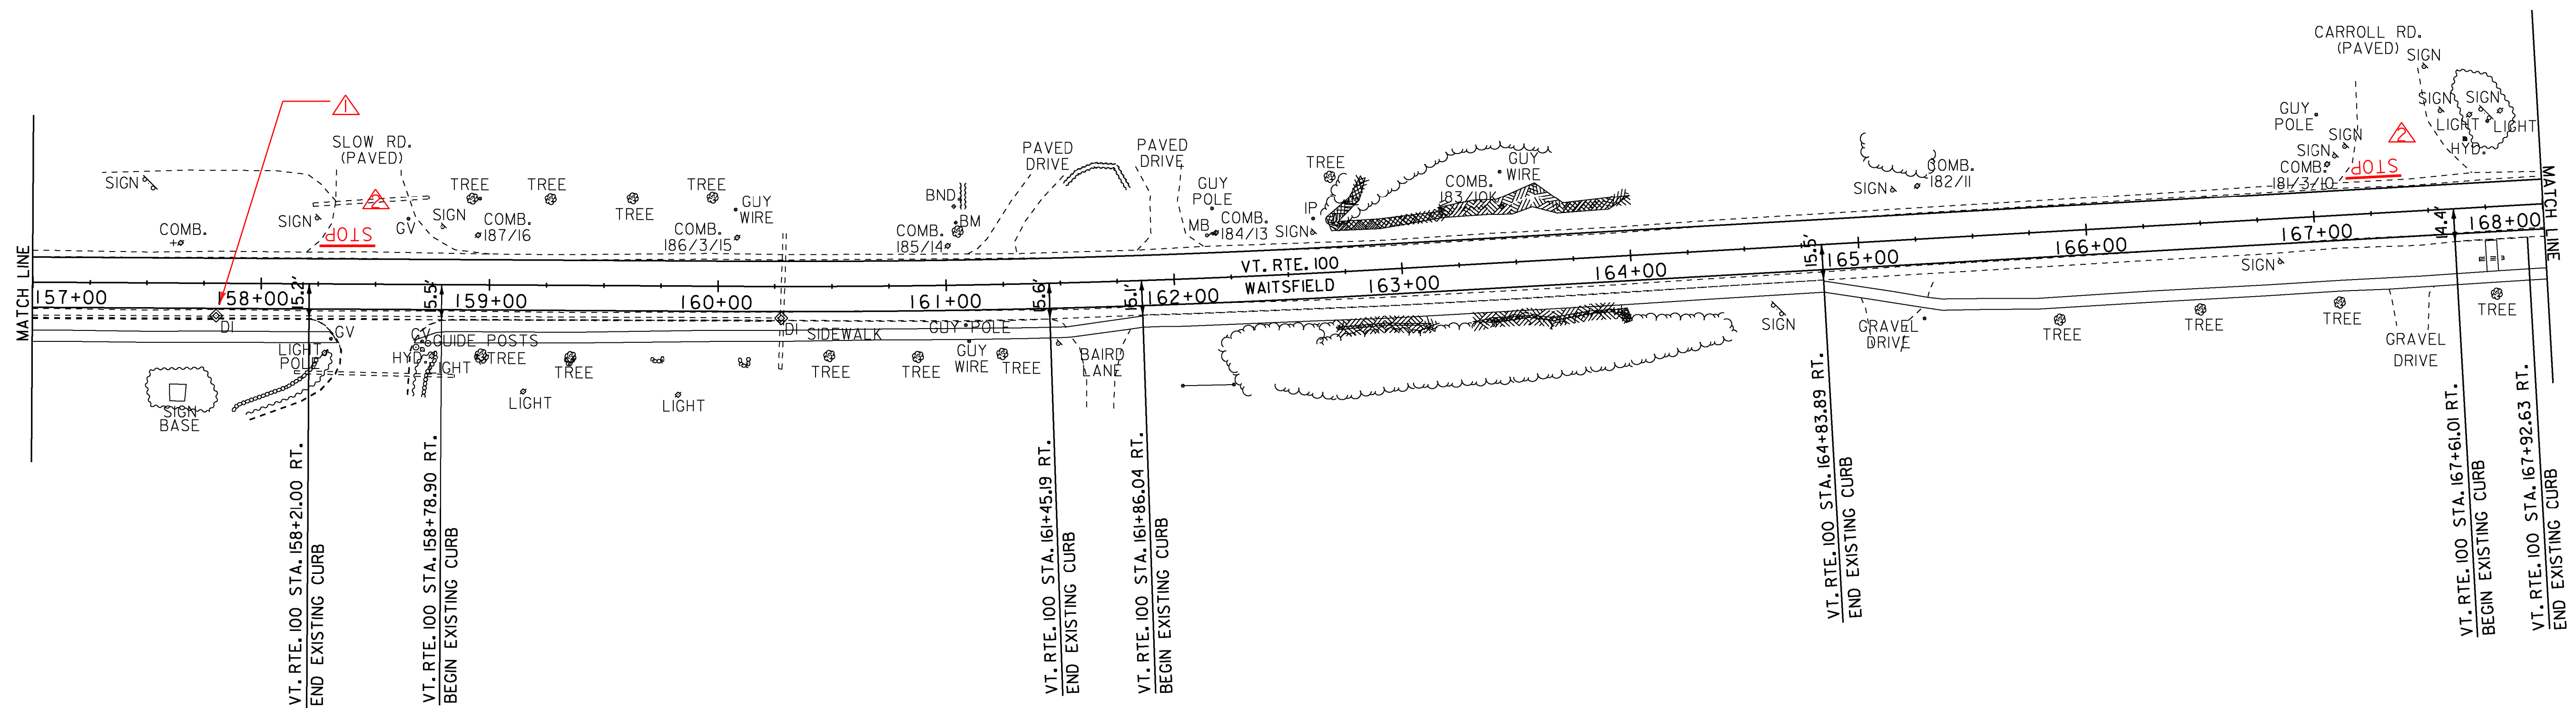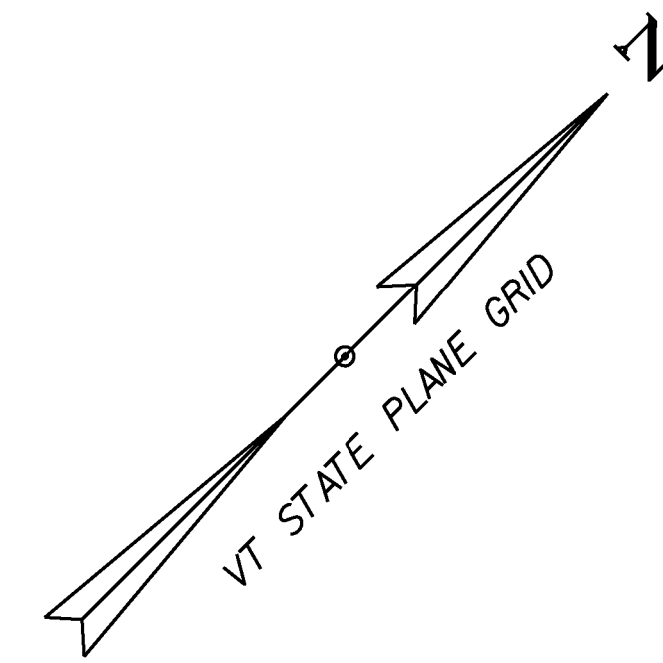

KEY	DATE	BY	REVISION
▲	10/21/15	CPP	REHAB. DROP INLET, CATCH BASIN OR MANHOLE, CLASS 1
▲	10/21/15	CPP	ADDITIONAL DURABLE LETTER OR SYMBOL
▲	10/21/15	CPP	ADDITIONAL 24 INCH DURABLE STOP BAR

SCALE 1" = 40' - 0"  
40 0 40

<b>PROJECT LAYOUT SHEET #4</b>	PROJECT NAME: WAITSFIELD-MORETOWN
	PROJECT NUMBER: STP SURF(39)
	FILE NAME: pi3bi68bdr.dgn PROJECT LEADER: M. FOWLER DESIGNED BY: L. BULLOCK pi3bi68lay4.i