
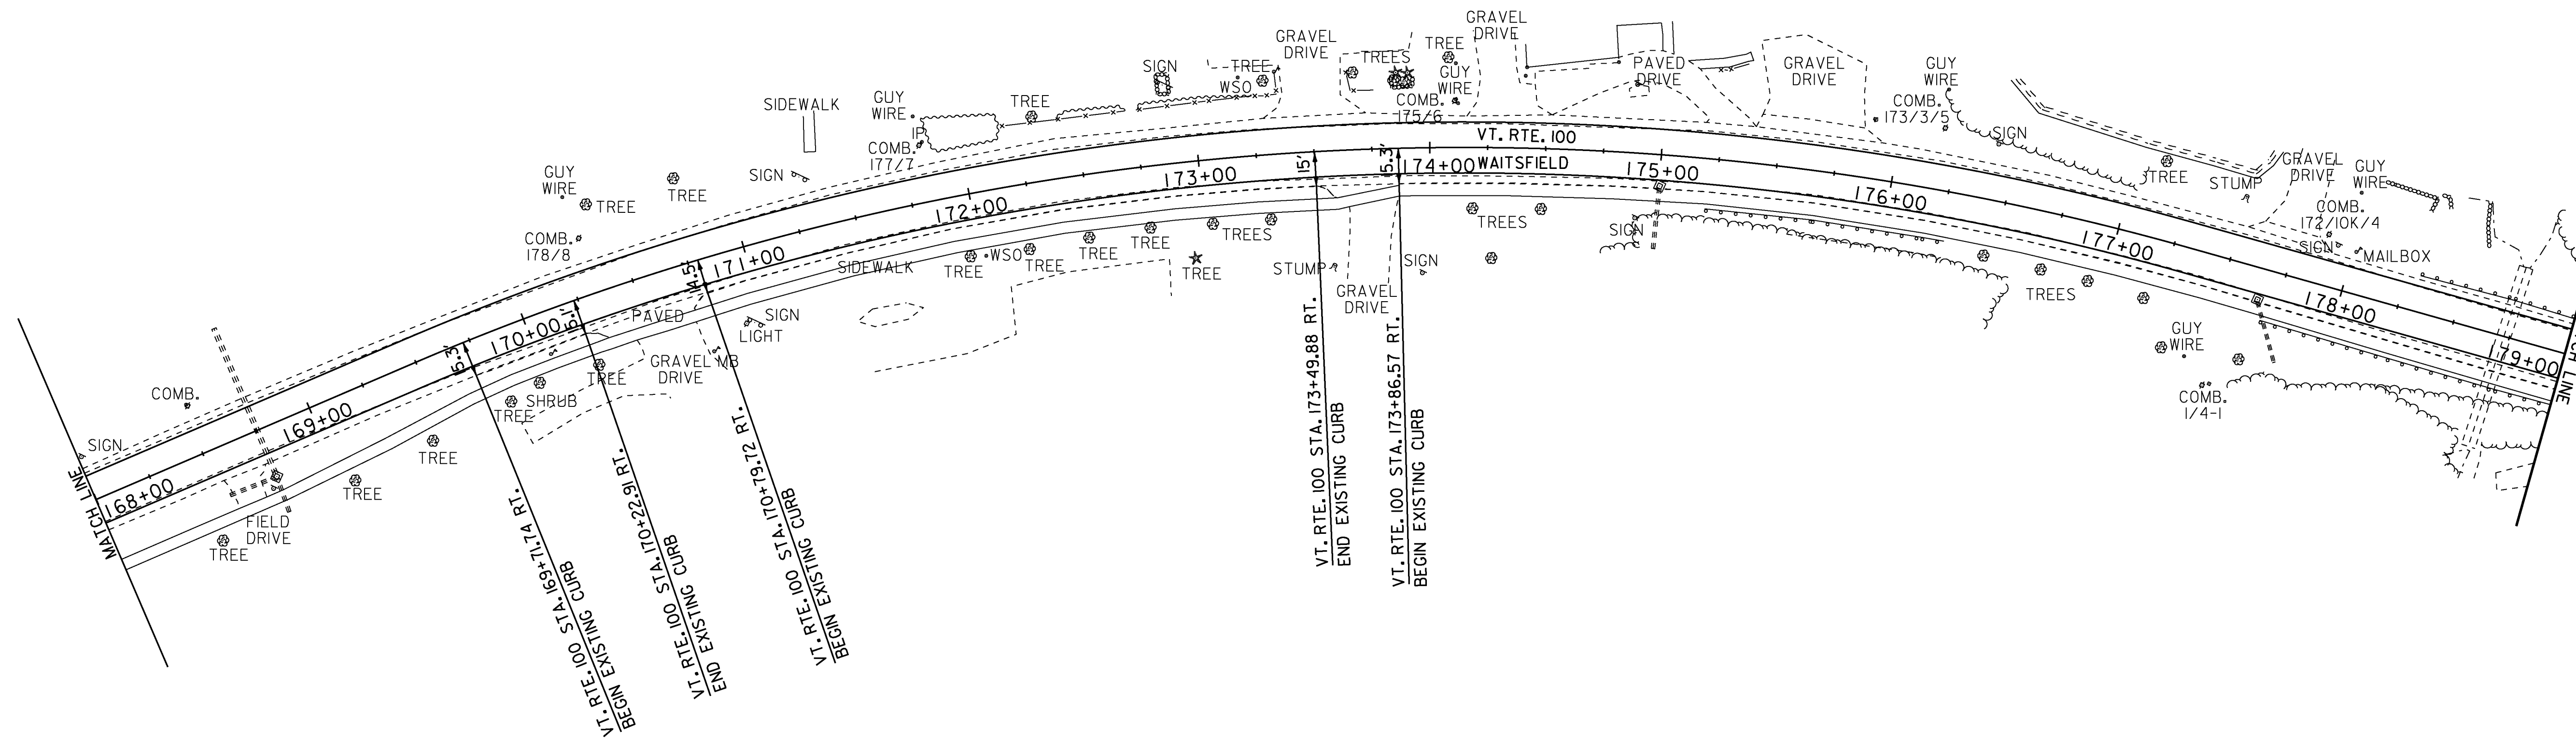


DURABLE 4 INCH WHITE LINE, POLYUREA
 TEMPORARY 4 INCH WHITE LINE, PAINT

VT. RTE. 100 STA. 168+00 LT. - STA. 179+00 LT.
 VT. RTE. 100 STA. 168+00 RT. - STA. 179+00 RT.

DURABLE 4 INCH YELLOW LINE, POLYUREA
 TEMPORARY 4 INCH YELLOW LINE, PAINT

VT. RTE. 100 STA. 168+00 C/L - STA. 179+00 C/L

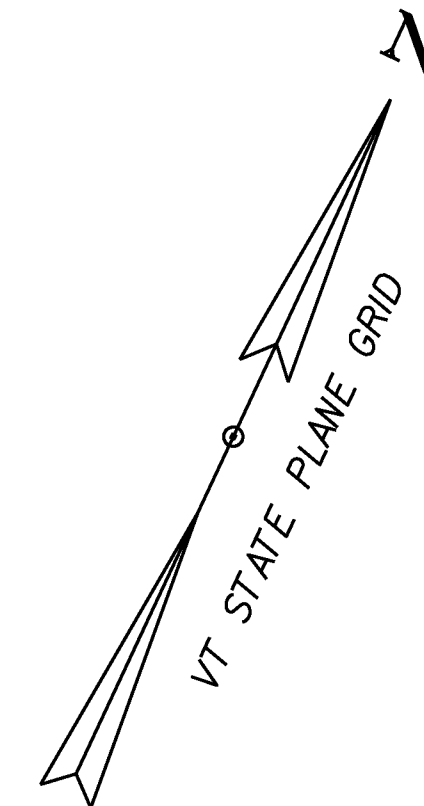

SCALE 1" = 40'-0"
 40 0 40

PROJECT LAYOUT SHEET #5

PROJECT NAME: WAITSFIELD-MORETOWN

PROJECT NUMBER: STP SURF(39)

FILE NAME: pi3b168bdr.dgn
 PROJECT LEADER: M. FOWLER
 DESIGNED BY: L. BULLOCK
 pi3b168lay5.i

PLOT DATE: 06-MAY-2014
 DRAWN BY: L. BULLOCK
 CHECKED BY: M. FOWLER
 SHEET 12 OF 26