
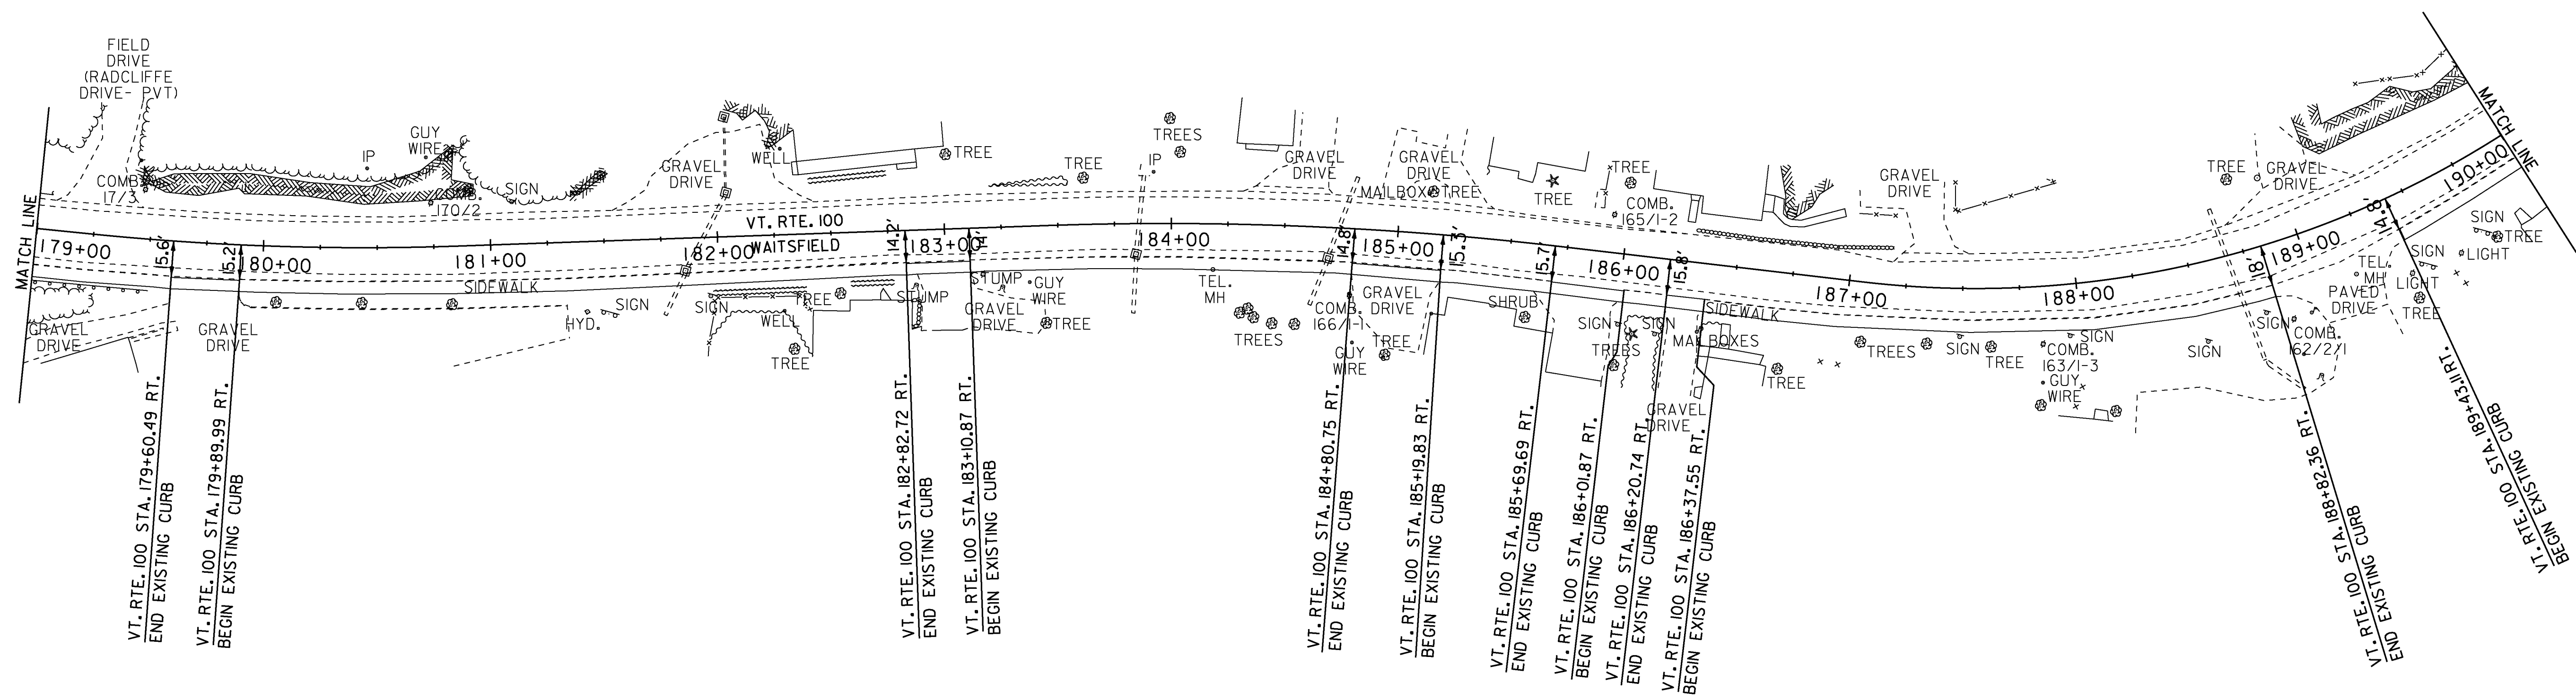


DURABLE 4 INCH WHITE LINE, POLYUREA  
 TEMPORARY 4 INCH WHITE LINE, PAINT  
 VT. RTE. 100 STA. 179+00 LT. - STA. 190+00 LT.  
 VT. RTE. 100 STA. 179+00 RT. - STA. 190+00 RT.

DURABLE 4 INCH YELLOW LINE, POLYUREA  
 TEMPORARY 4 INCH YELLOW LINE, PAINT  
 VT. RTE. 100 STA. 179+00 C/L - STA. 190+00 C/L

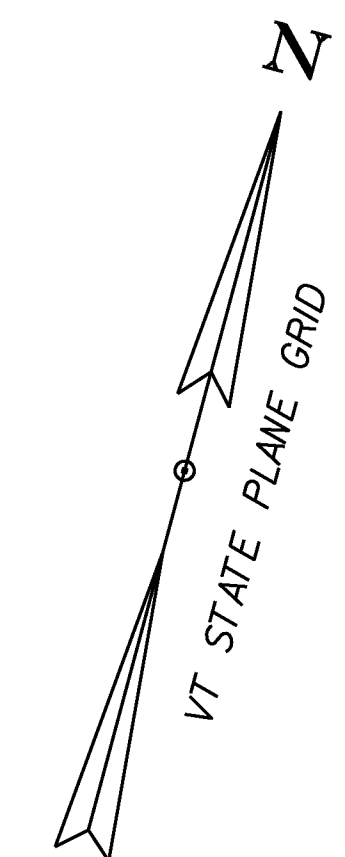

VT. RTE. 100 STA. 179+60.49 RT.  
 END EXISTING CURB  
 VT. RTE. 100 STA. 179+89.99 RT.  
 BEGIN EXISTING CURB

VT. RTE. 100 STA. 182+82.72 RT.  
 END EXISTING CURB  
 VT. RTE. 100 STA. 183+10.87 RT.  
 BEGIN EXISTING CURB

VT. RTE. 100 STA. 184+80.75 RT.  
 END EXISTING CURB  
 VT. RTE. 100 STA. 185+19.83 RT.  
 BEGIN EXISTING CURB

VT. RTE. 100 STA. 185+69.69 RT.  
 END EXISTING CURB  
 VT. RTE. 100 STA. 186+01.87 RT.  
 BEGIN EXISTING CURB  
 VT. RTE. 100 STA. 186+20.74 RT.  
 END EXISTING CURB  
 VT. RTE. 100 STA. 186+37.55 RT.  
 BEGIN EXISTING CURB

VT. RTE. 100 STA. 188+82.36 RT.  
 END EXISTING CURB  
 VT. RTE. 100 STA. 189+43.1 RT.  
 BEGIN EXISTING CURB

SCALE 1" = 40'-0"  
 0 40

|                                |                                   |                        |
|--------------------------------|-----------------------------------|------------------------|
| <b>PROJECT LAYOUT SHEET #6</b> | PROJECT NAME: WAITSFIELD-MORETOWN | PLOT DATE: 06-MAY-2014 |
|                                | PROJECT NUMBER: STP SURF(39)      | DRAWN BY: L. BULLOCK   |
|                                | FILE NAME: pi3bi68bdr.dgn         | CHECKED BY: M. FOWLER  |
|                                | DESIGNED BY: L. BULLOCK           | SHEET 13 OF 26         |
|                                | pi3bi68loy6.1                     |                        |