

DURABLE CROSSWALK MARKING, THERMOPLASTIC OR
 DURABLE CROSSWALK MARKING, POLYUREA
 TEMPORARY CROSSWALK MARKING, PAINT

VT. RTE. 100 STA. 192+60 RT. - STA. 193+03 RT.
 VT. RTE. 100 STA. 193+13 LT. - RT.



▲ DURABLE 24 INCH STOP BAR, THERMOPLASTIC
 VT. RTE. 100 STA. 194+30 LT

DURABLE 4 INCH WHITE LINE, POLYUREA
 TEMPORARY 4 INCH WHITE LINE, PAINT

VT. RTE. 100 STA. 190+00 LT. - STA. 201+00 LT.
 VT. RTE. 100 STA. 190+00 RT. - STA. 201+00 RT.

DURABLE 4 INCH YELLOW LINE, POLYUREA
 TEMPORARY 4 INCH YELLOW LINE, PAINT

VT. RTE. 100 STA. 190+00 C/L - STA. 201+00 C/L

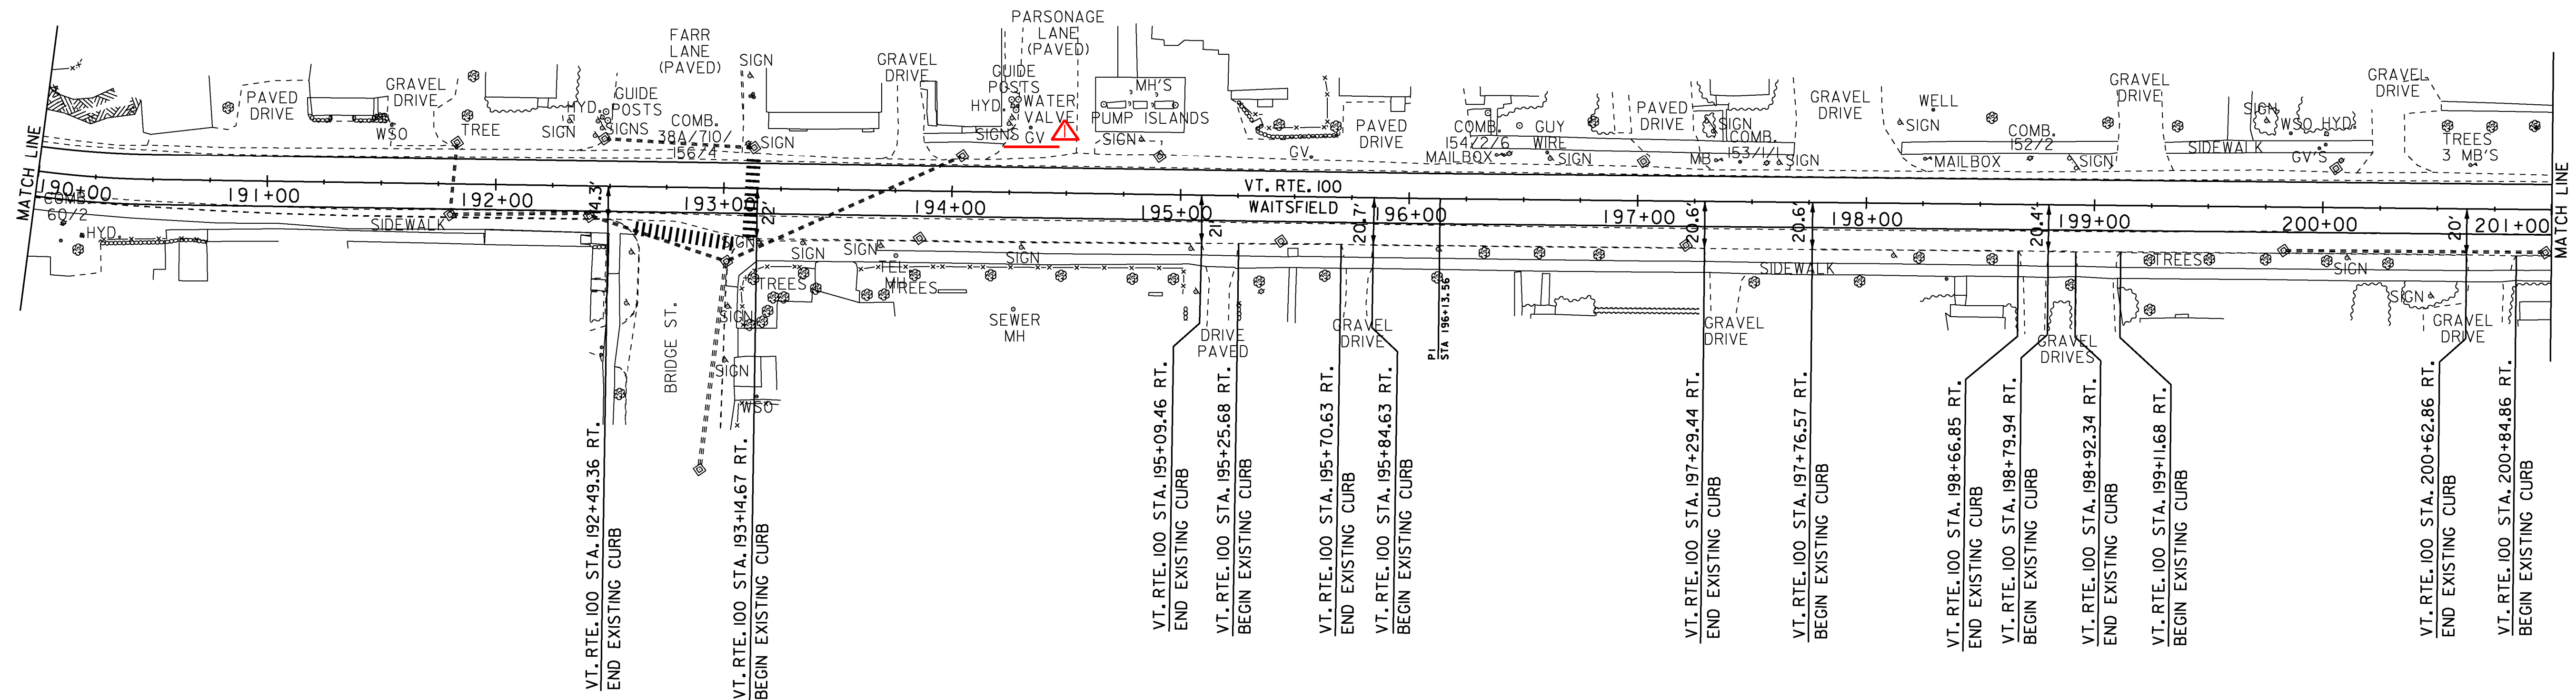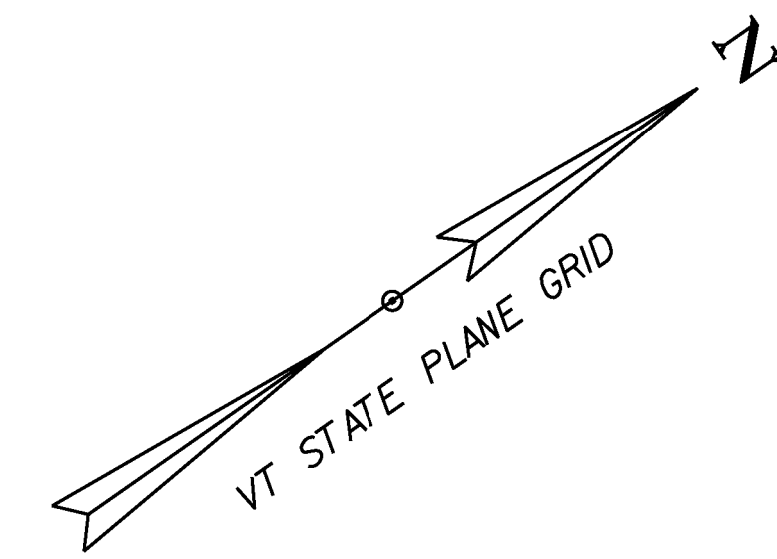

KEY	DATE	BY	REVISION
▲	10/21/15	CPP	ADDITIONAL 24 INCH DURABLE STOP BAR

SCALE 1" = 40'-0"
 40 0 40

PROJECT LAYOUT SHEET #7

PROJECT NAME: WAITSFIELD-MORETOWN
 PROJECT NUMBER: STP SURF(39)
 FILE NAME: pi3bi68bdr.dgn
 PROJECT LEADER: M. FOWLER
 DESIGNED BY: L. BULLOCK
 pi3bi68lay7.l
 PLOT DATE: 06-MAY-2014
 DRAWN BY: L. BULLOCK
 CHECKED BY: M. FOWLER
 SHEET 14 OF 26