



DURABLE LETTER OR SYMBOL, THERMOPLASTIC OR
 DURABLE LETTER OR SYMBOL, POLYUREA
 VT. RTE. 100 STA. 208+50 RT "SCHOOL"

DURABLE 4 INCH WHITE LINE, POLYUREA
 TEMPORARY 4 INCH WHITE LINE, PAINT
 VT. RTE. 100 STA. 201+00 LT. - STA. 212+00 LT.
 VT. RTE. 100 STA. 201+00 RT. - STA. 212+00 RT.

TEMPORARY LETTER OR SYMBOL, PAINT
 VT. RTE. 100 STA. 208+50 RT "SCHOOL"

DURABLE 4 INCH YELLOW LINE, POLYUREA
 TEMPORARY 4 INCH YELLOW LINE, PAINT
 VT. RTE. 100 STA. 201+00 C/L - STA. 212+00 C/L

DURABLE CROSSWALK MARKING, THERMOPLASTIC OR
 DURABLE CROSSWALK MARKING, POLYUREA
 ▲ VT. RTE. 100 STA. 208+68 LT/RT

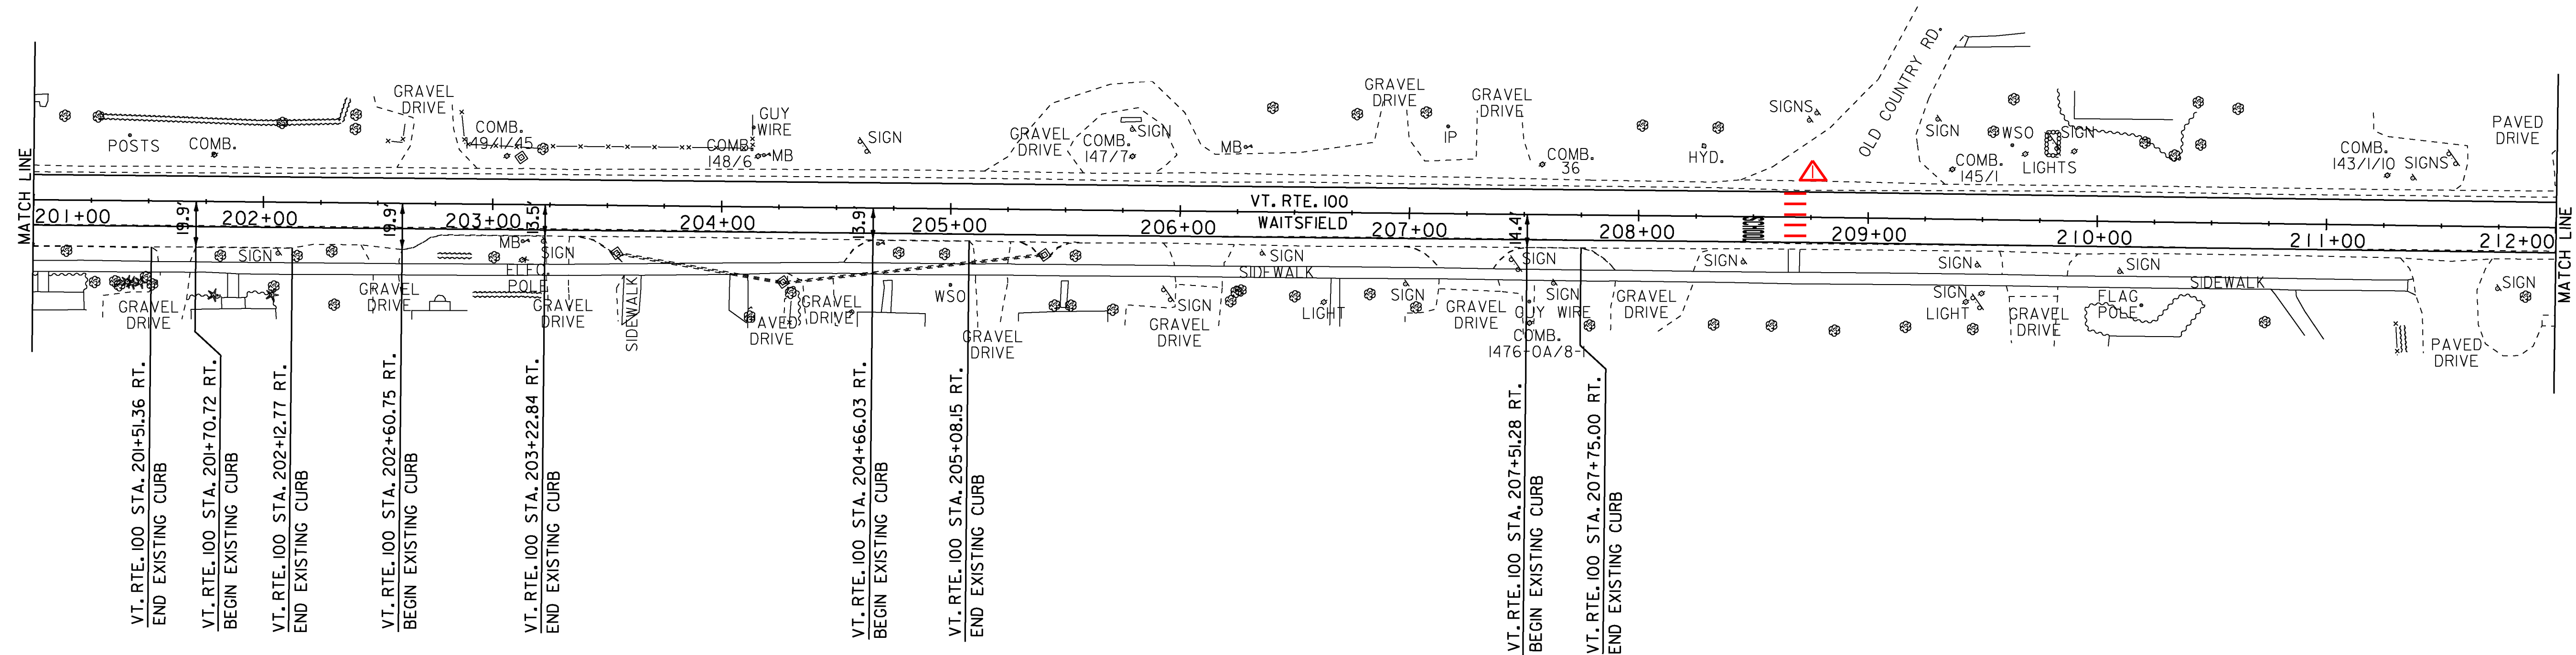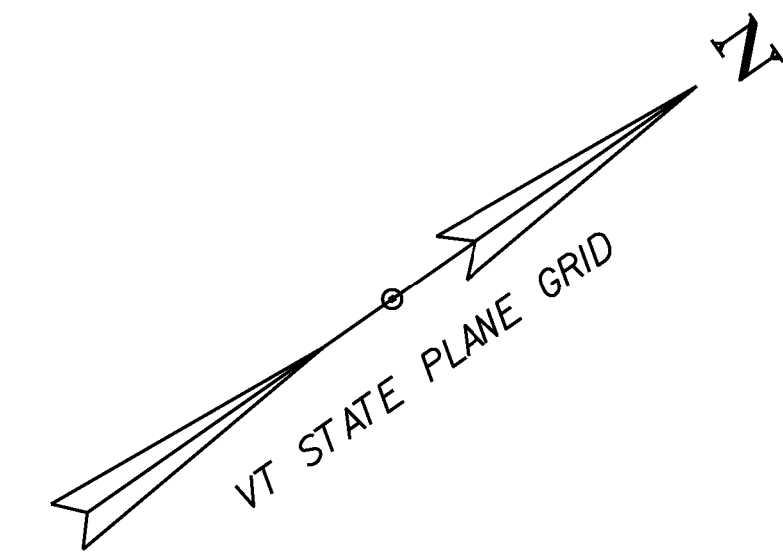

KEY	DATE	BY	REVISION
▲	10/21/15	CPP	ADDITIONAL DURABLE CROSSWALK MARKING

SCALE 1" = 40' - 0"
 40 0 40

PROJECT LAYOUT SHEET #8

PROJECT NAME: WAITSFIELD-MORETOWN
 PROJECT NUMBER: STP SURF(39)

FILE NAME: pi3bl68bdr.dgn
 PROJECT LEADER: M. FOWLER
 DESIGNED BY: L. BULLOCK
 pi3bl68lay8.i

PLOT DATE: 06-MAY-2014
 DRAWN BY: L. BULLOCK
 CHECKED BY: M. FOWLER
 SHEET 15 OF 26