



DURABLE 4 INCH WHITE LINE, POLYUREA  
 TEMPORARY 4 INCH WHITE LINE, PAINT  
 VT. RTE. 100 STA. 212+00 LT. - STA. 221+94 LT.  
 VT. RTE. 100 STA. 212+00 RT. - STA. 221+94RT.

DURABLE 4 INCH YELLOW LINE, POLYUREA  
 TEMPORARY 4 INCH YELLOW LINE, PAINT  
 VT. RTE. 100 STA. 212+00 C/L - STA. 221+94 C/L

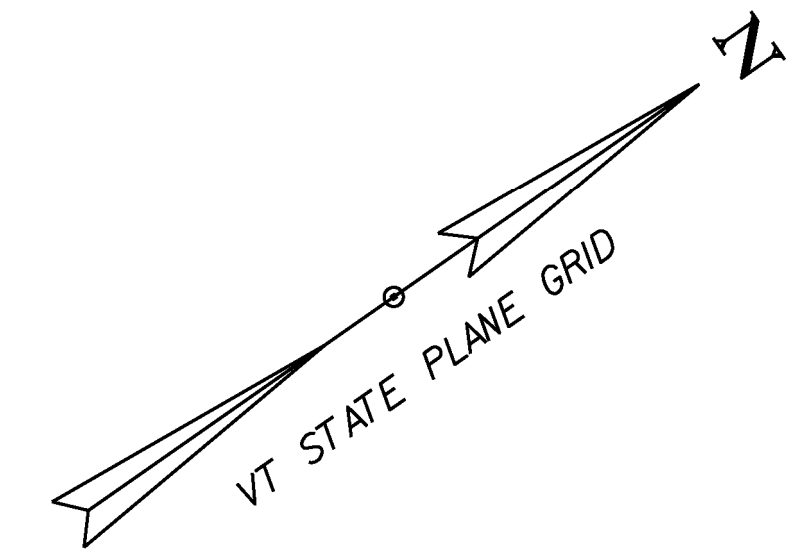

▲ DURABLE LETTER OR SYMBOL, THERMOPLASTIC  
 VT.RTE.100 STA. 220+90 LT "SCHOOL"

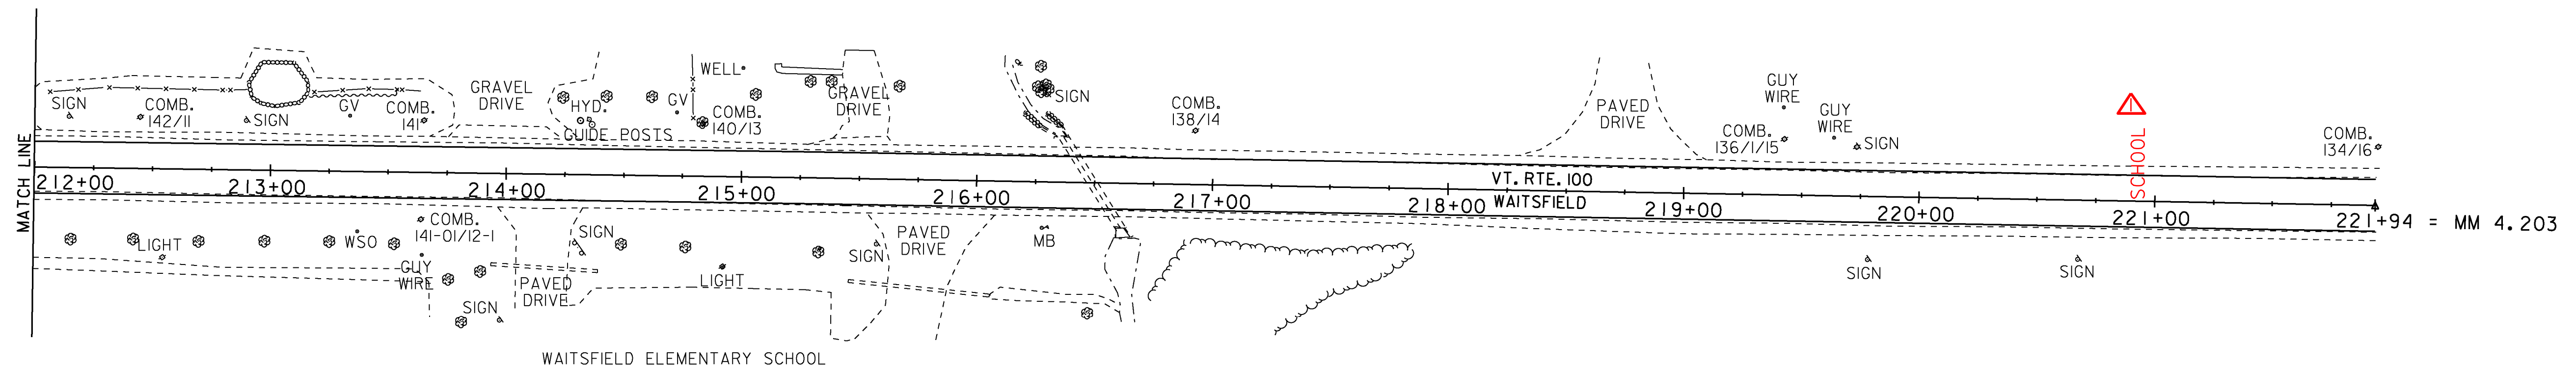

KEY	DATE	BY	REVISION
▲	10/21/15	CPP	ADDITIONAL DURABLE LETTER OR SYMBOL

SCALE 1" = 40'-0"  
 40 0 40

**PROJECT LAYOUT SHEET #9**

PROJECT NAME: WAITSFIELD-MORETOWN  
 PROJECT NUMBER: STP SURF(39)  
 FILE NAME: pi3bi68bdr.dgn  
 PROJECT LEADER: M. FOWLER  
 DESIGNED BY: L. BULLOCK  
 pi3bi68lay9.i  
 PLOT DATE: 06-MAY-2014  
 DRAWN BY: L. BULLOCK  
 CHECKED BY: M. FOWLER  
 SHEET 16 OF 26