

646.404 DURABLE 4 INCH WHITE LINE, POLYUREA
 646.602 TEMPORARY 4 INCH WHITE LINE, PAINT

MORETOWN:
 MM 0.00 - MM 1.227 LT & RT
 DUXBURY:
 MM 0.000 - MM 2.500 LT & RT
 (WITH BREAKS OR RADII AT TOWN HIGHWAYS)

646.414 DURABLE 4 INCH YELLOW LINE, POLYUREA
 646.612 TEMPORARY 4 INCH YELLOW LINE, PAINT

MORETOWN:
 MM 0.000 - MM 1.227 SOLID LT
 MM 0.000 - MM 1.227 SOLID RT
 DUXBURY:
 MM 0.000 - MM 0.942 SOLID LT
 MM 0.942 - MM 1.07 DASH LT
 MM 1.07 - MM 2.500 SOLID LT
 MM 0.000 - MM 2.500 SOLID RT
 (WITH CENTERLINE BREAKS AT TOWN HIGHWAYS)

646.702 TEMPORARY CROSSWALK MARKING, PAINT

DUXBURY:
 MM 0.50

END PROJECT

646.502 DURABLE CROSSWALK MARKING, THERMOPLASTIC OR
 646.504 DURABLE CROSSWALK MARKING, POLYUREA

DUXBURY:
 MM 0.50

646.482 DURABLE 24 INCH STOP BAR, THERMOPLASTIC OR
 646.484 DURABLE 24 INCH STOP BAR, POLYUREA

MORETOWN:
 MM 0.457 SB
 MM 1.226 NB

646.682 TEMPORARY 24 INCH STOP BAR, PAINT

MORETOWN:
 MM 0.457 SB
 MM 1.226 NB

646.492 DURABLE LETTER OR SYMBOL, THERMOPLASTIC OR
 646.494 DURABLE LETTER OR SYMBOL, POLYUREA

MORETOWN:
 MM 0.458 SB "STOP"
 MM 0.599 SB "AHEAD"
 MM 0.605 SB "STOP"
 MM 1.224 NB "STOP"

DUXBURY:
 MM 0.321 NB "SCHOOL"
 MM 0.685 SB "SCHOOL"

646.692 TEMPORARY LETTER OR SYMBOL, PAINT

MORETOWN:
 MM 0.458 SB "STOP"
 MM 0.599 SB "AHEAD"
 MM 0.605 SB "STOP"
 MM 1.224 NB "STOP"


DUXBURY:
 MM 0.321 NB "SCHOOL"
 MM 0.685 SB "SCHOOL"

LEGEND

TWBH-THROUGHWAY BEGINS HERE
 TWEH-THROUGHWAY ENDS HERE
 SHB-STATE HIGHWAY BEGINS
 SHE-STATE HIGHWAY ENDS
 SL-SPEED LIMIT
 C/4 TH- CLASS 4 TOWN HIGHWAY
 T/L-TOWN LINE

NOTE:

1. THIS SHEET TO BE USED FOR THE LAYOUT OF ALL CENTERLINE PAVEMENT MARKINGS.
 THE RESIDENT ENGINEER MAY CONTACT KEITH SWEET, PAVEMENT MARKING SUPERVISOR
 AT (802) 828-5573 FOR ASSISTANCE LAYING OUT THE CENTERLINE DURING CONSTRUCTION.

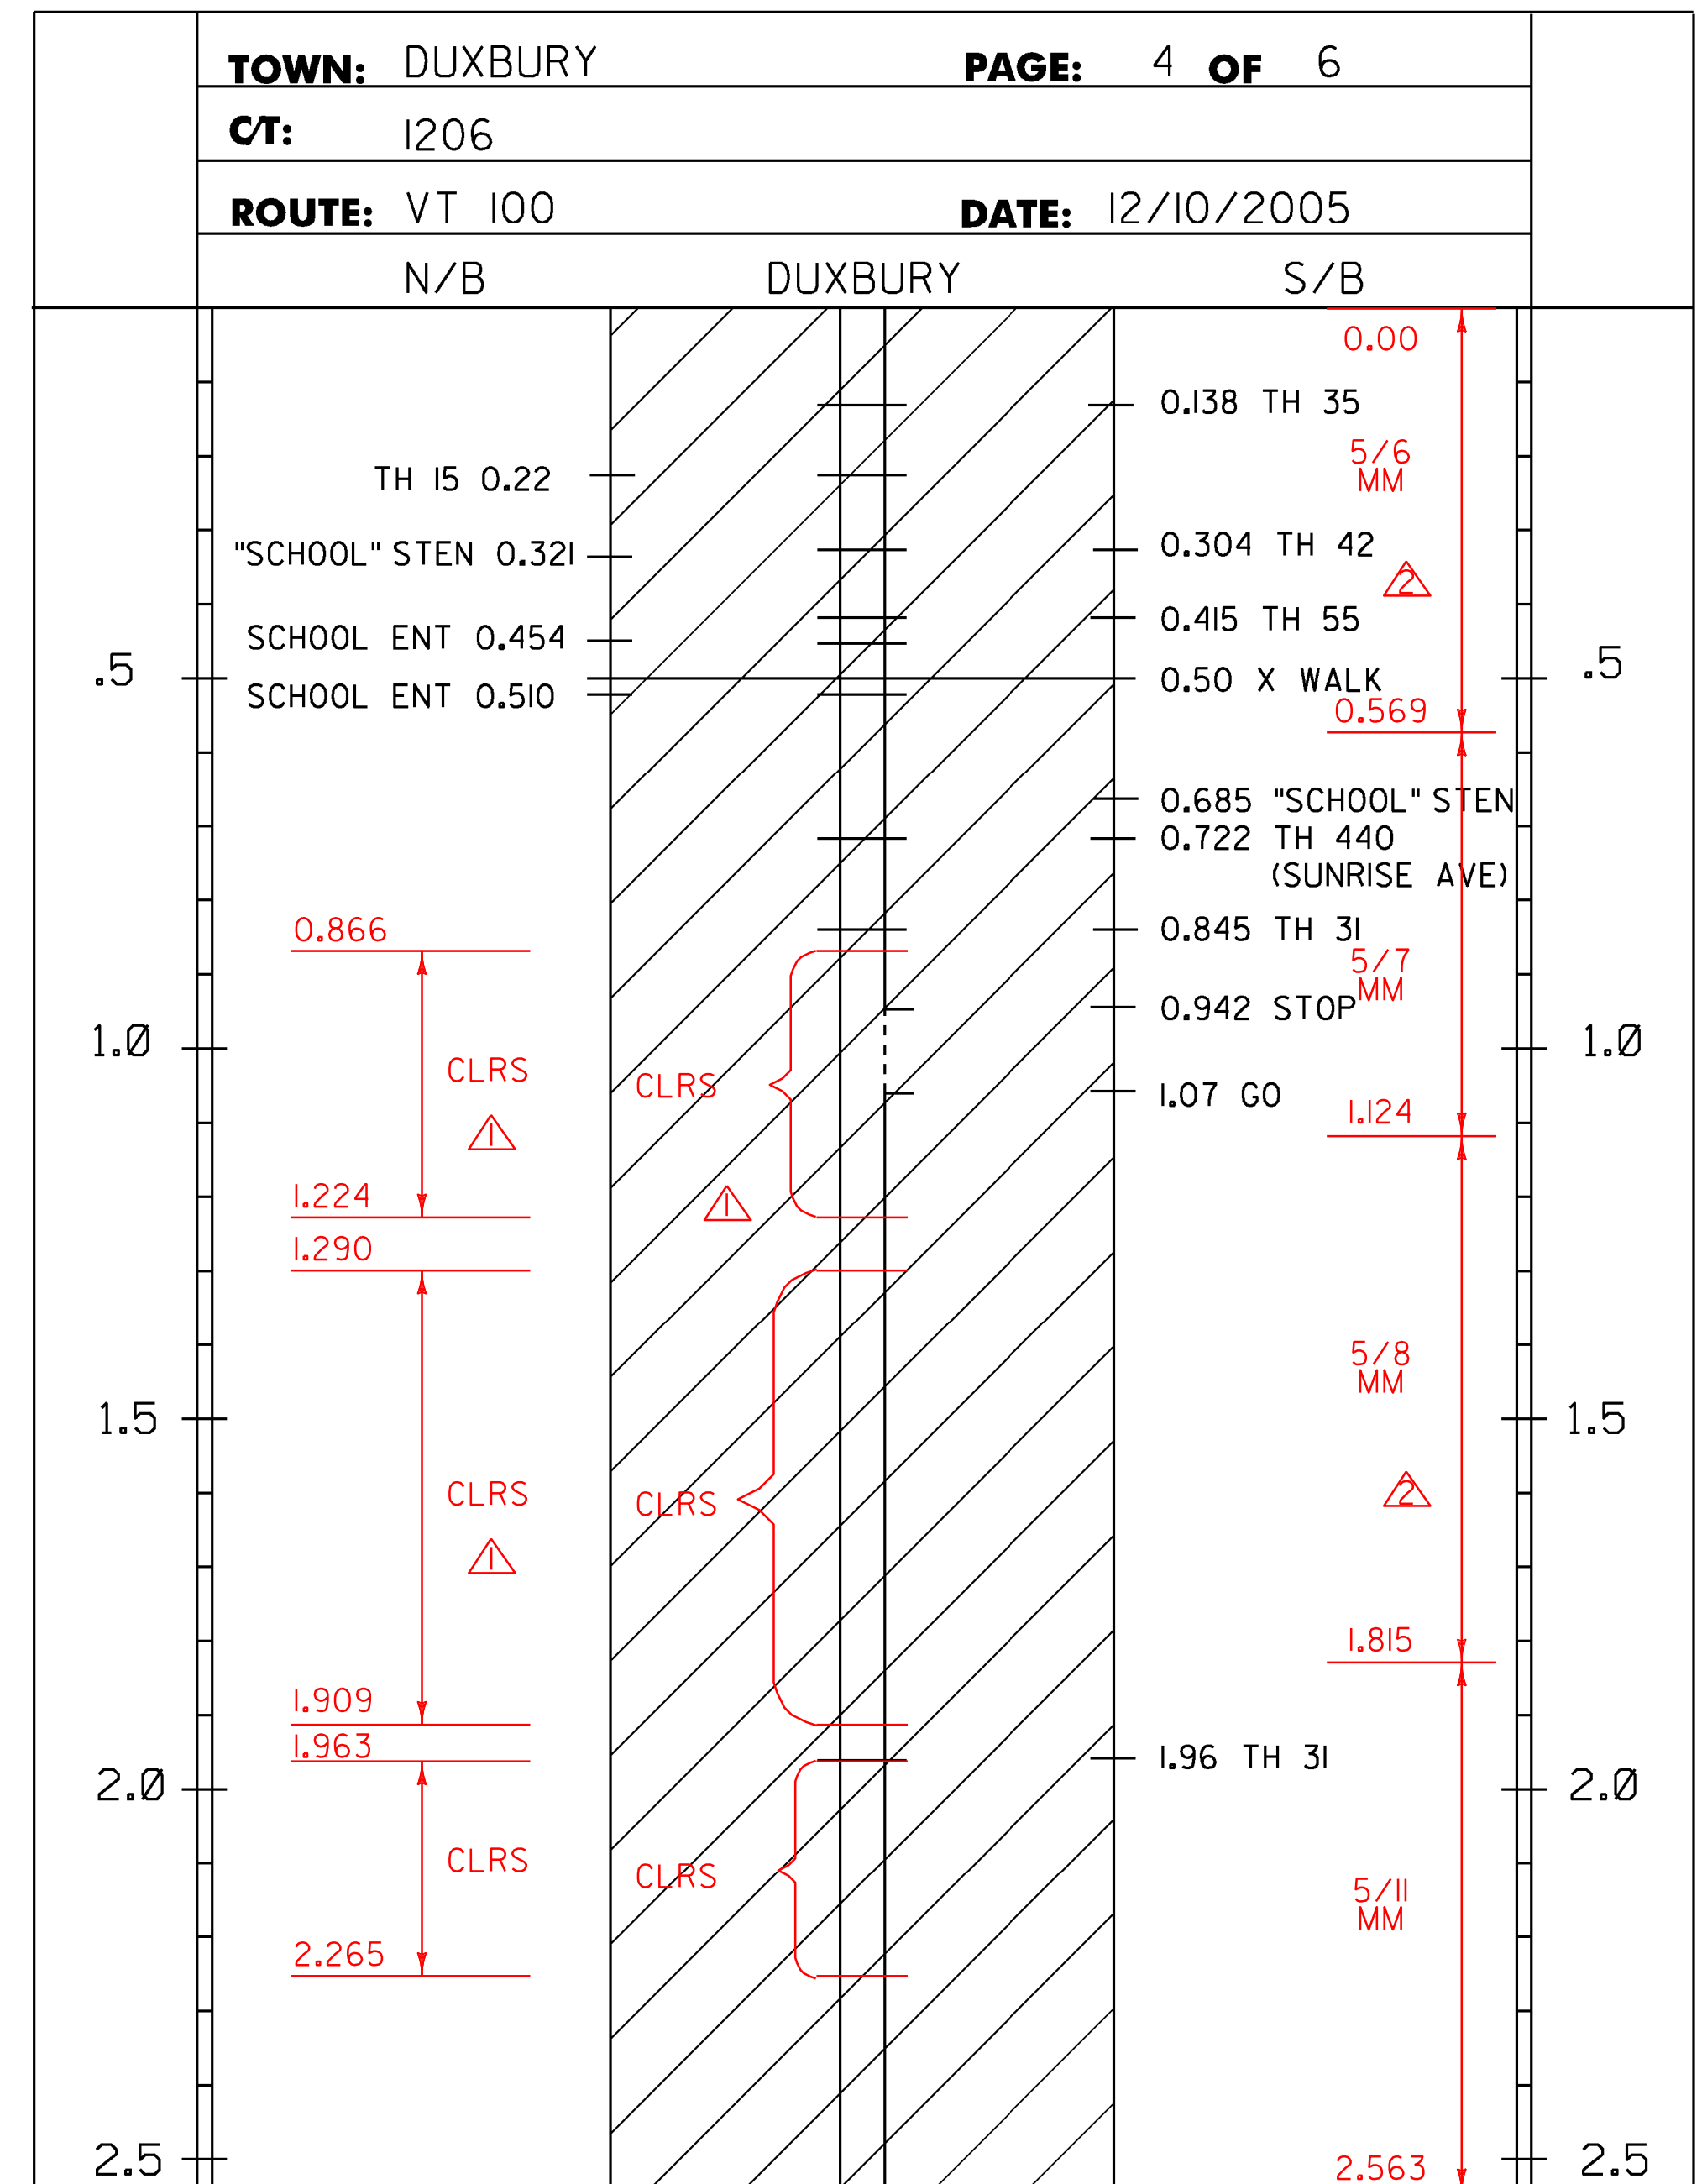

NOT TO SCALE

PROJECT LAYOUT SHEET #11

KEY	DATE	BY	REVISION
△	10/20/15	CPP	REVISED CL RUMBLE STRIP LOCATIONS
△	10/20/15	CPP	NEW MICROMILL LOCATIONS

PROJECT NAME:	WAITSFIELD-MORETOWN
PROJECT NUMBER:	STP SURF(39)
FILE NAME:	I3bl68\pl3bl68.dgn
PROJECT LEADER:	FOWLER
DESIGNED BY:	BULLOCK
IPARM FILE NAME:	pl3bl68lay11.l
PLOT DATE:	06-MAY-2014
DRAWN BY:	BULLOCK
CHECKED BY:	M. FOWLER
SHEET 18	OF 26