

646.404 DURABLE 4 INCH WHITE LINE, POLYUREA
 646.602 TEMPORARY 4 INCH WHITE LINE, PAINT

DUXBURY:
 MM 2.500 - MM 6.234 LT & RT
 (WITH BREAKS OR RADII AT TOWN HIGHWAYS)

646.414 DURABLE 4 INCH YELLOW LINE, POLYUREA
 646.612 TEMPORARY 4 INCH YELLOW LINE, PAINT


DUXBURY:
 MM 2.500 - MM 6.234 SOLID LT
 MM 2.500 - MM 6.234 SOLID RT
 (WITH CENTERLINE BREAKS AT TOWN HIGHWAYS)

646.492 DURABLE LETTER OR SYMBOL, THERMOPLASTIC
 646.494 DURABLE LETTER OR SYMBOL, POLYUREA

DUXBURY:
 MM 5.485 NB "SCHOOL"
 MM 5.780 SB "SCHOOL"
 MM 6.160 NB "STOP"
 MM 6.166 NB "AHEAD"

646.692 TEMPORARY LETTER OR SYMBOL, PAINT

DUXBURY:
 MM 5.485 NB "SCHOOL"
 MM 5.780 SB "SCHOOL"
 MM 6.160 NB "STOP"
 MM 6.166 NB "AHEAD"

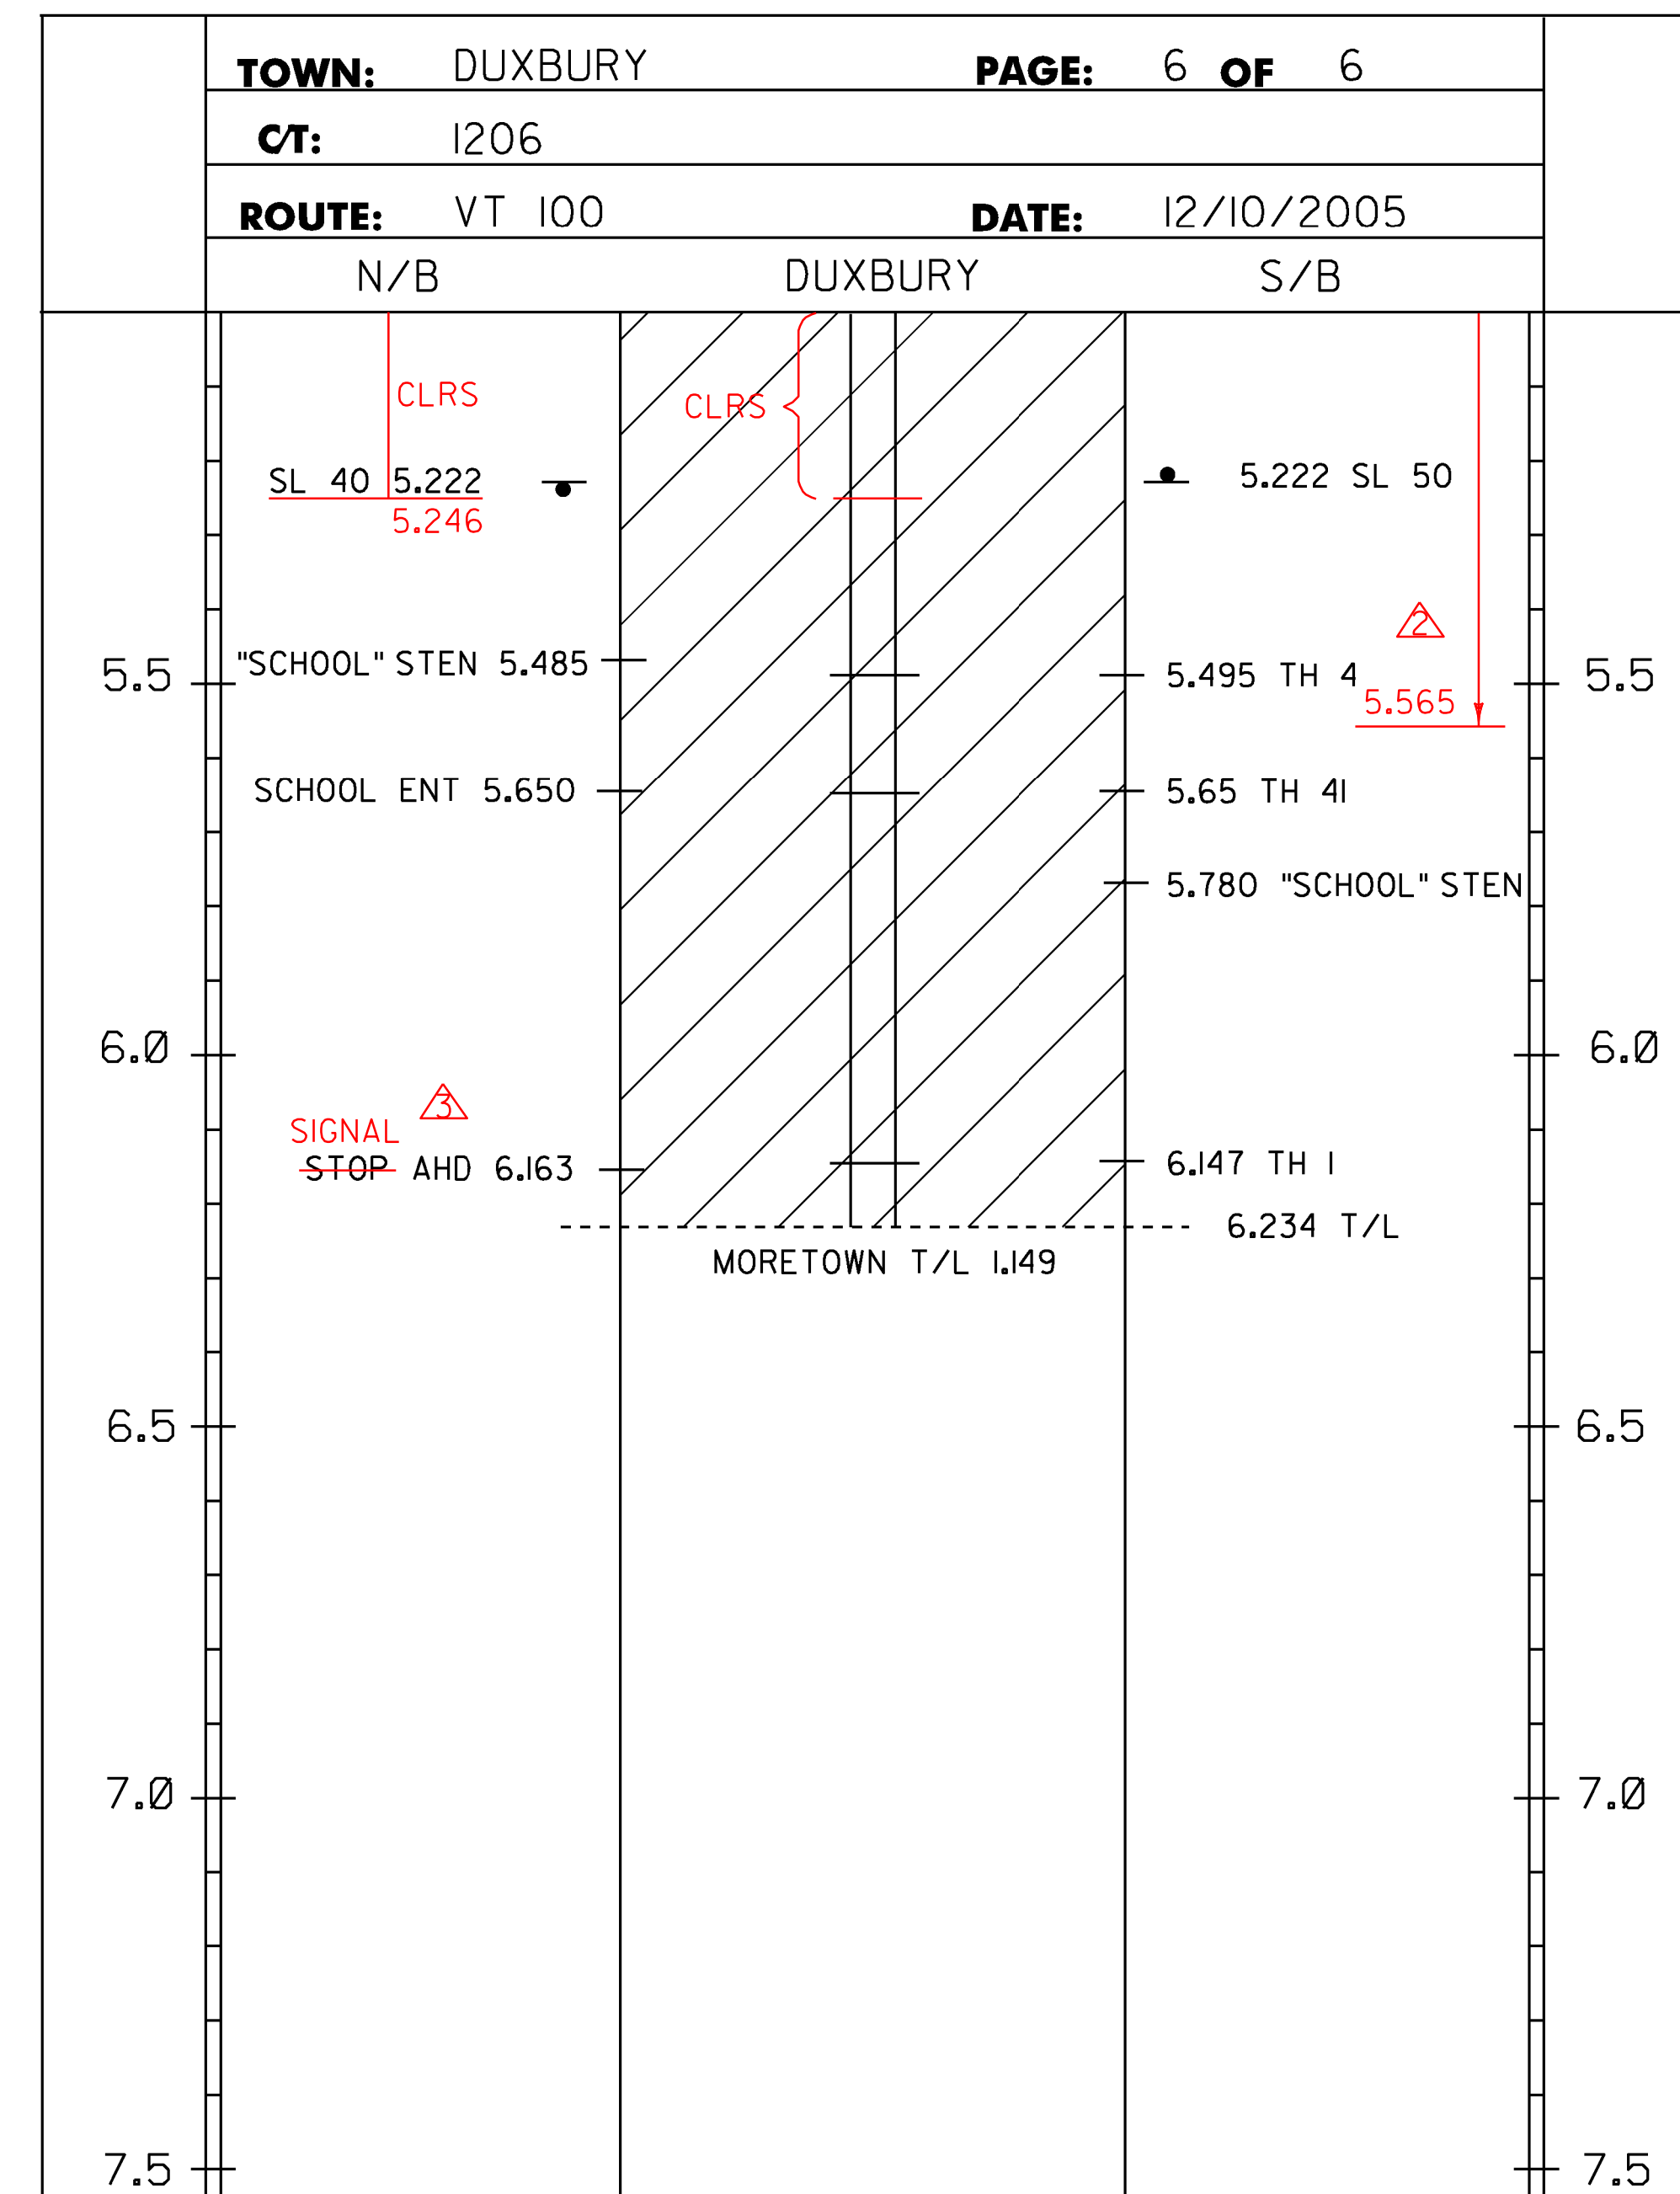

LEGEND
 TWBH-THROUGHWAY BEGINS HERE
 TWEH-THROUGHWAY ENDS HERE
 SHB-STATE HIGHWAY BEGINS
 SHE-STATE HIGHWAY ENDS
 SL-SPEED LIMIT
 C/4 TH- CLASS 4 TOWN HIGHWAY
 T/L-TOWN LINE

NOTE:
 1. THIS SHEET TO BE USED FOR THE LAYOUT OF ALL CENTERLINE PAVEMENT MARKINGS.
 THE RESIDENT ENGINEER MAY CONTACT KEITH SWEET, PAVEMENT MARKING SUPERVISOR
 AT (802) 828-5573 FOR ASSISTANCE LAYING OUT THE CENTERLINE DURING CONSTRUCTION.

NOT TO SCALE

PROJECT LAYOUT SHEET #12

KEY	DATE	BY	REVISION
△	10/20/15	CPP	REVISED CLRS LOCATIONS
△	10/20/15	CPP	NEW MICROMILL LOCATIONS
△	10/20/15	CPP	PAVEMENT MARKING SYMBOL/LETTER CHANGE

PROJECT NAME: WAITSFIELD-MORETOWN
PROJECT NUMBER: STP SURF(39)
FILE NAME: I3bl68\pl3bl68.dgn **PLOT DATE:** 06-MAY-2014
PROJECT LEADER: FOWLER **DRAWN BY:** BULLOCK
DESIGNED BY: BULLOCK **CHECKED BY:** M. FOWLER
IPARM FILE NAME: pl3bl68lay12.l **SHEET 19 OF 26**