



TYPICAL SECTIONS RAVINE

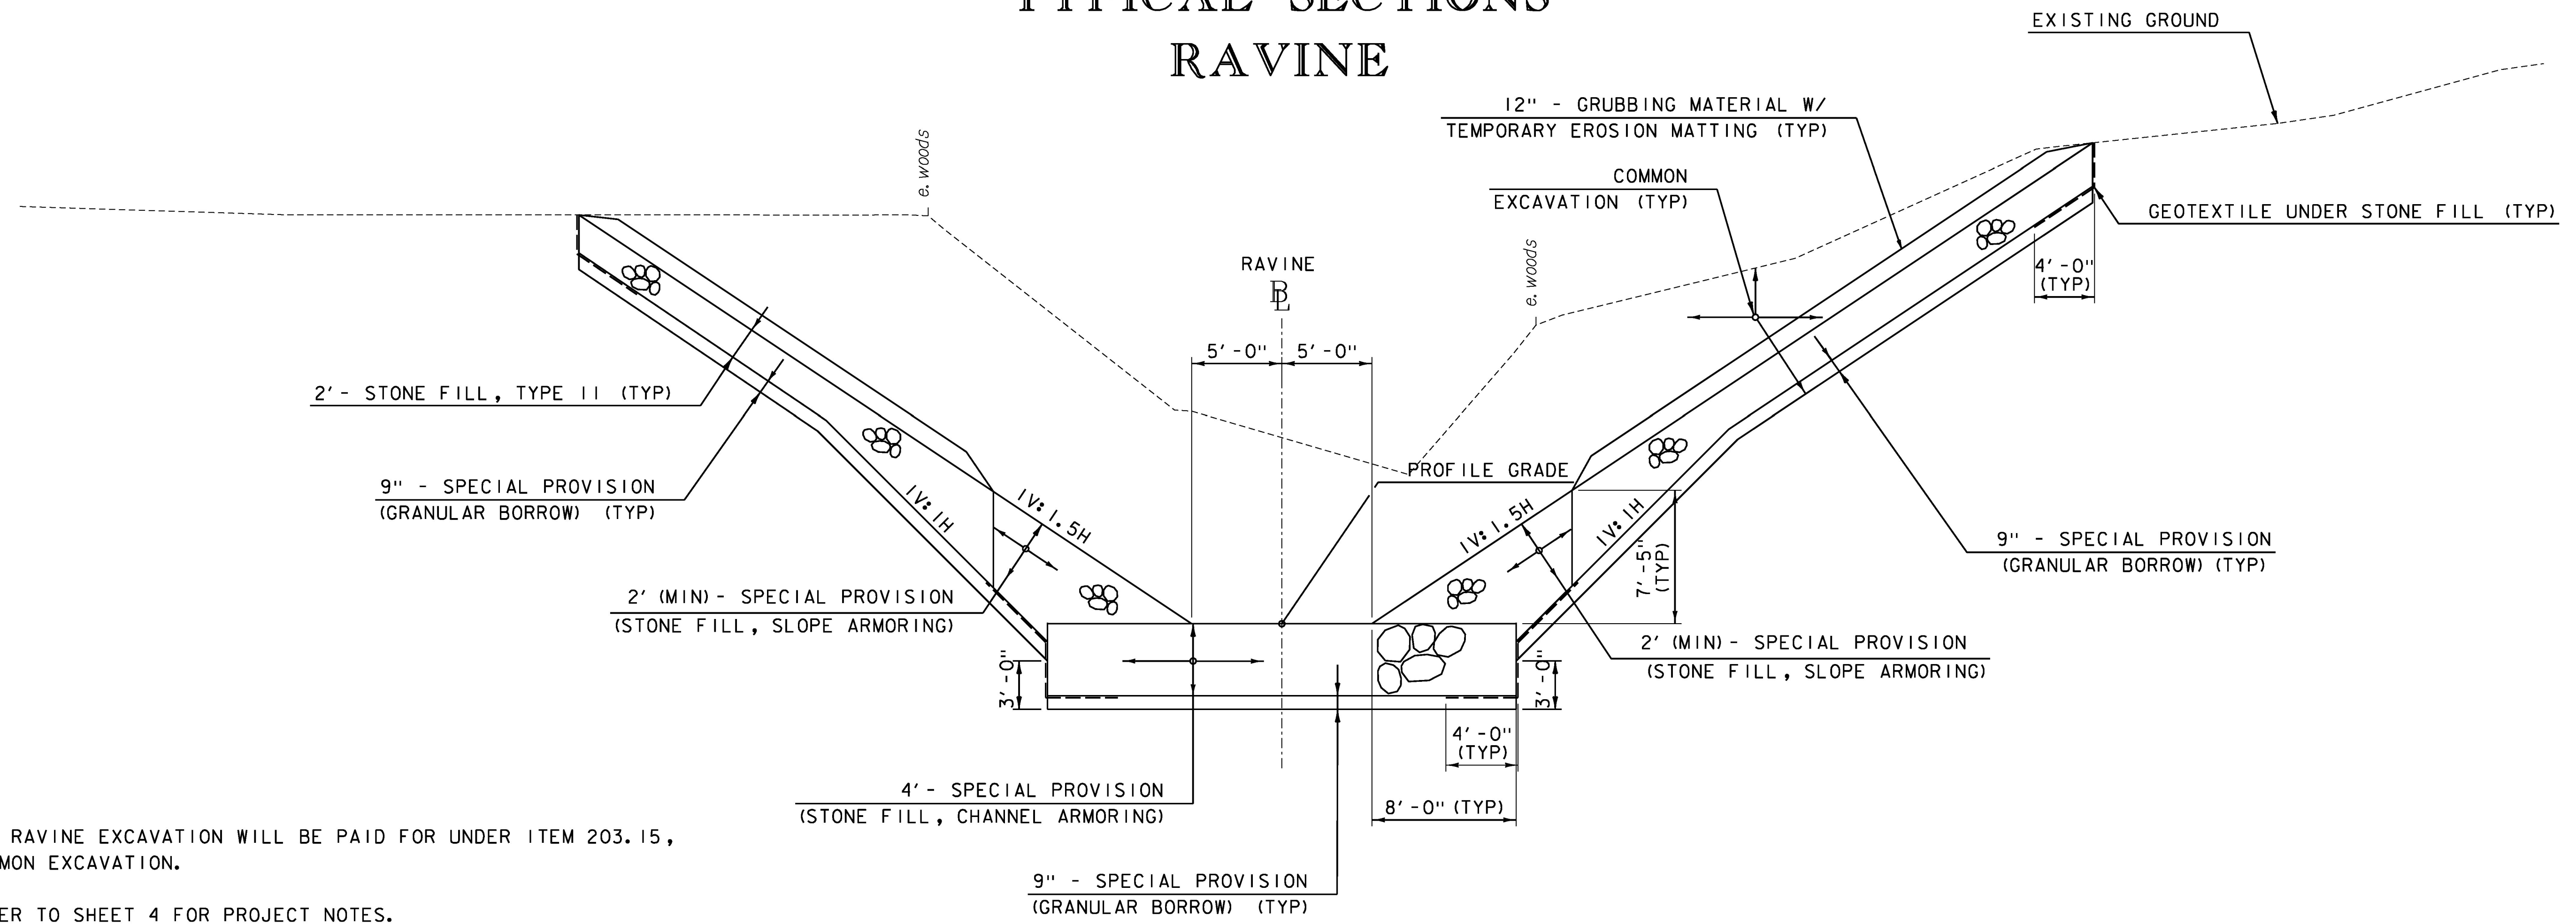

NOTES:

1. ALL RAVINE EXCAVATION WILL BE PAID FOR UNDER ITEM 203.15, COMMON EXCAVATION.
2. REFER TO SHEET 4 FOR PROJECT NOTES.

**TYPICAL SECTION
STA. 201+75.00-203+25.00**
NOT TO SCALE

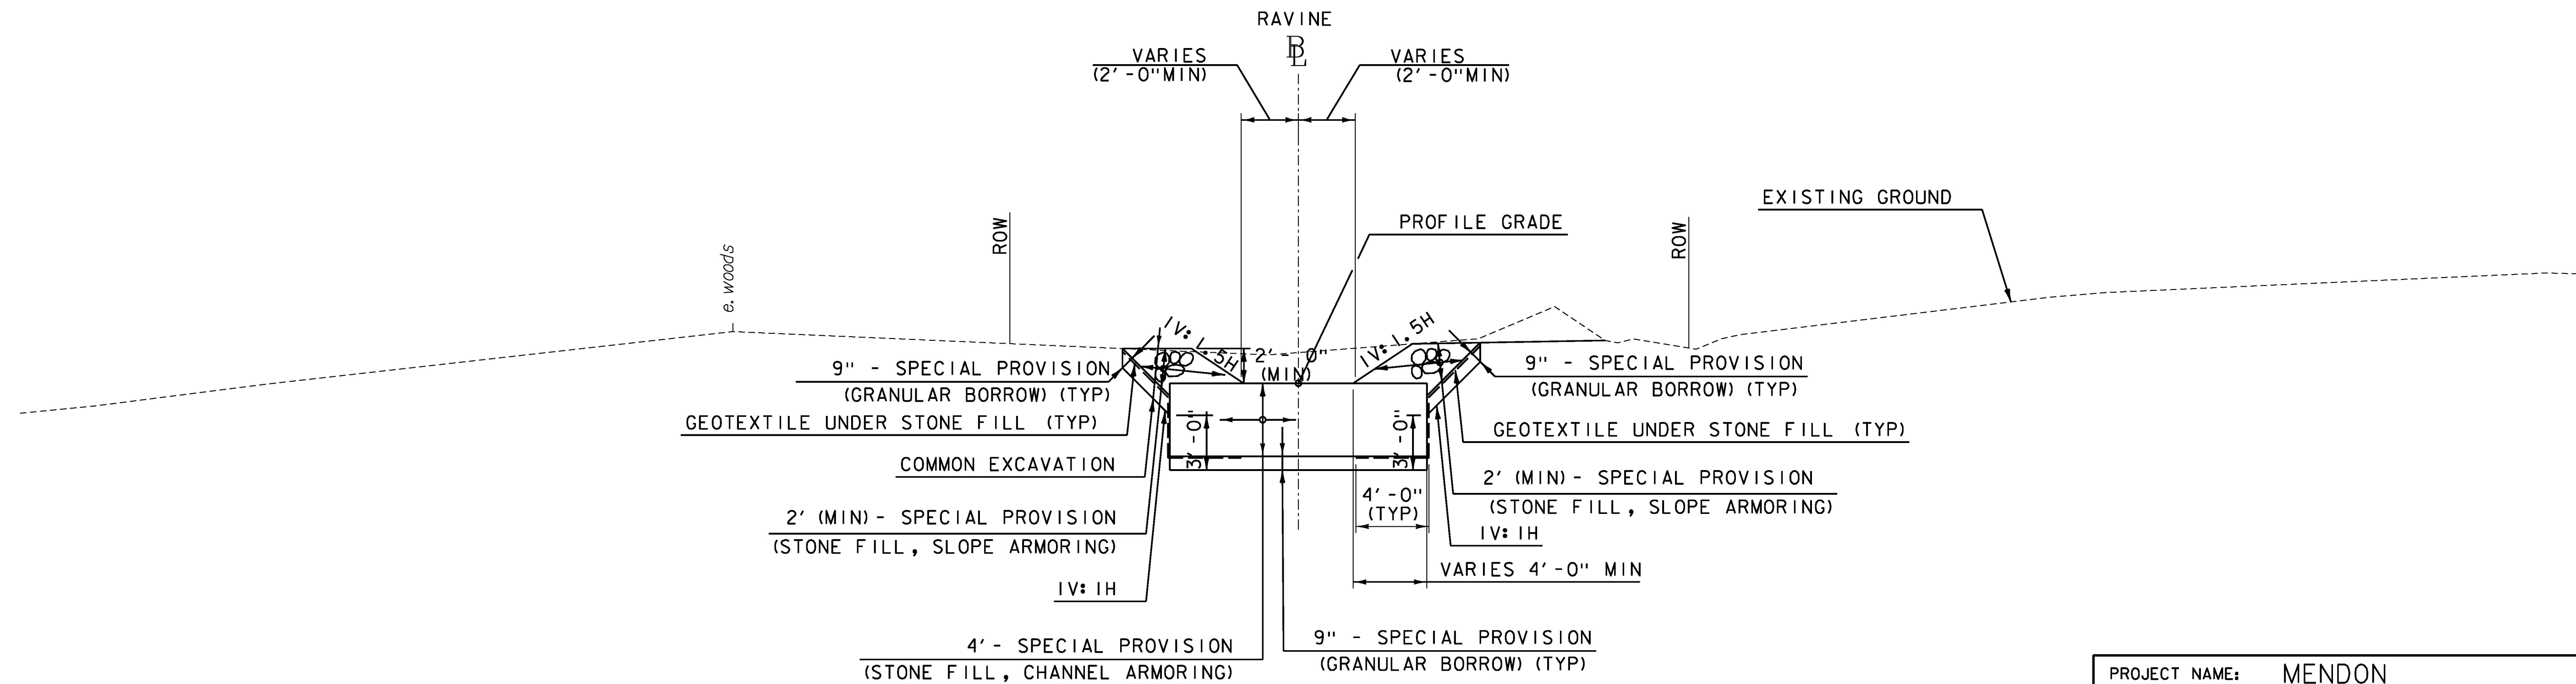

**TYPICAL SECTION
STA. 200+75.00-201+75.00**
NOT TO SCALE

PROJECT NAME:	MENDON	PLOT DATE:	11/13/2015
PROJECT NUMBER:	ER 020-2(39)	DRAWN BY:	M. BRADLEY
FILE NAME:	z13b188typ.dgn	DESIGNED BY:	M. BRADLEY
PROJECT LEADER:	E. ATKINS	CHECKED BY:	E. ATKINS
TYPICAL SECTIONS SHEET 4		SHEET	8 OF 72