


TYPICAL OVERFLOW SWALE SECTION
NOT TO SCALE

OVERFLOW SWALE PROFILE

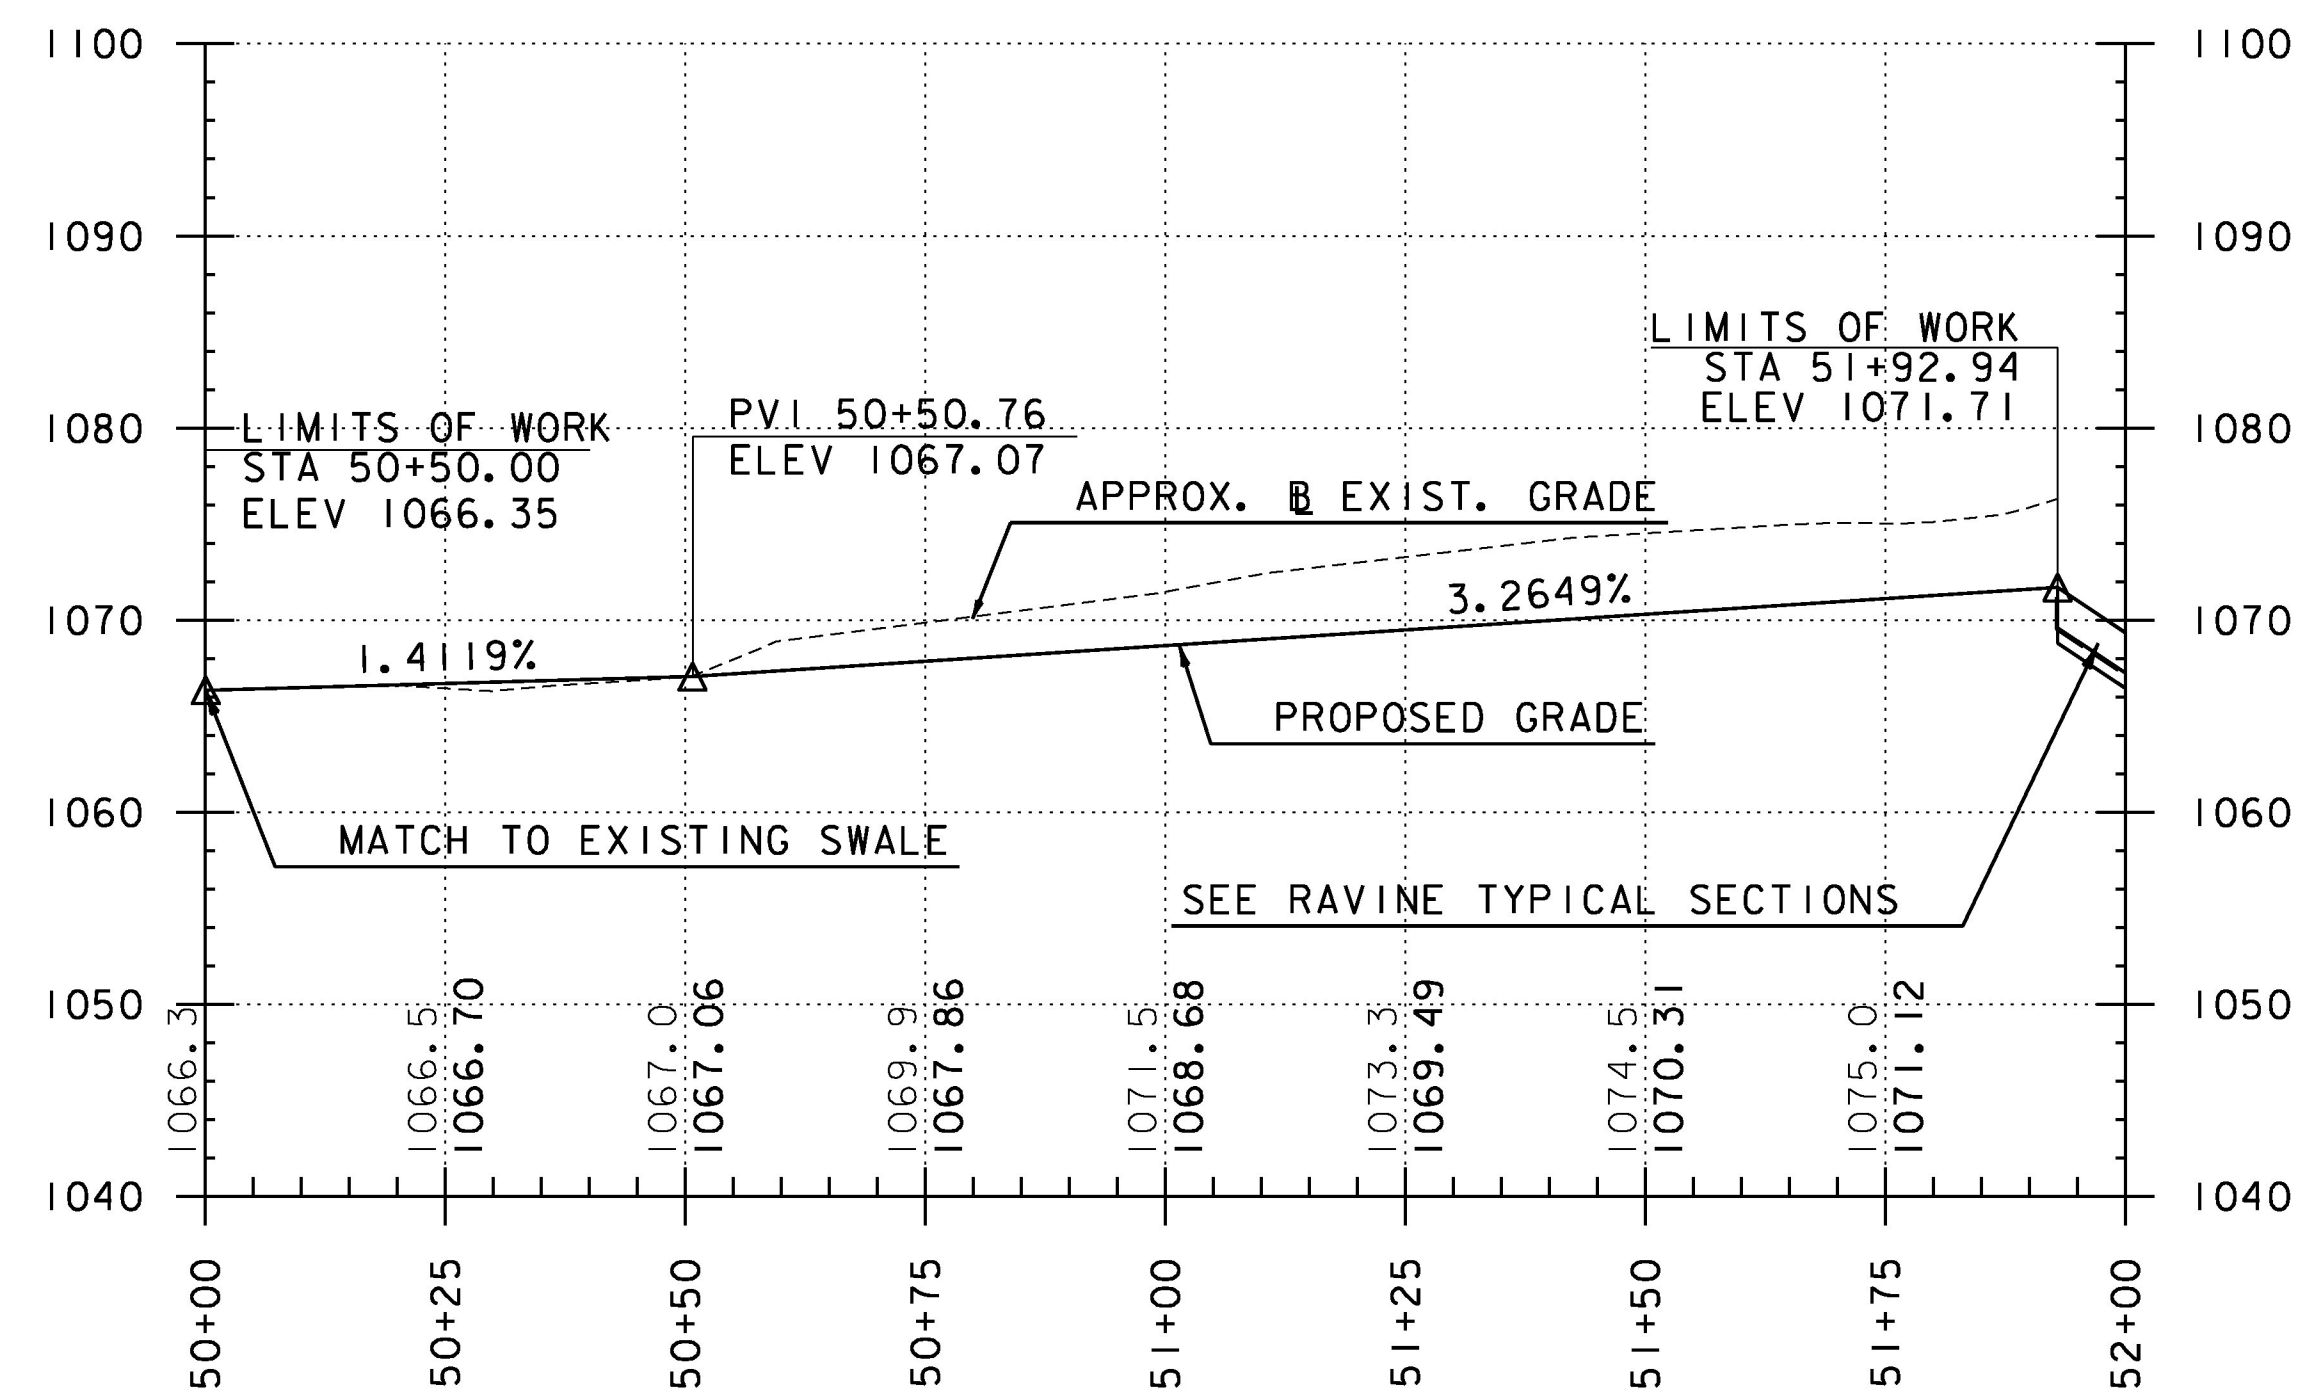

ALL STATIONS AND ELEVATIONS ARE SHOWN IN FEET.



PROJECT NAME: MENDON	PLOT DATE: 11/13/2015
PROJECT NUMBER: ER 020-2(39)	DRAWN BY: M. BRADLEY
FILE NAME: z13bi88def.dgn	CHECKED BY: E. ATKINS
DESIGNED BY: M. BRADLEY	SHEET 12 OF 72
DETAIL SHEET 2	