

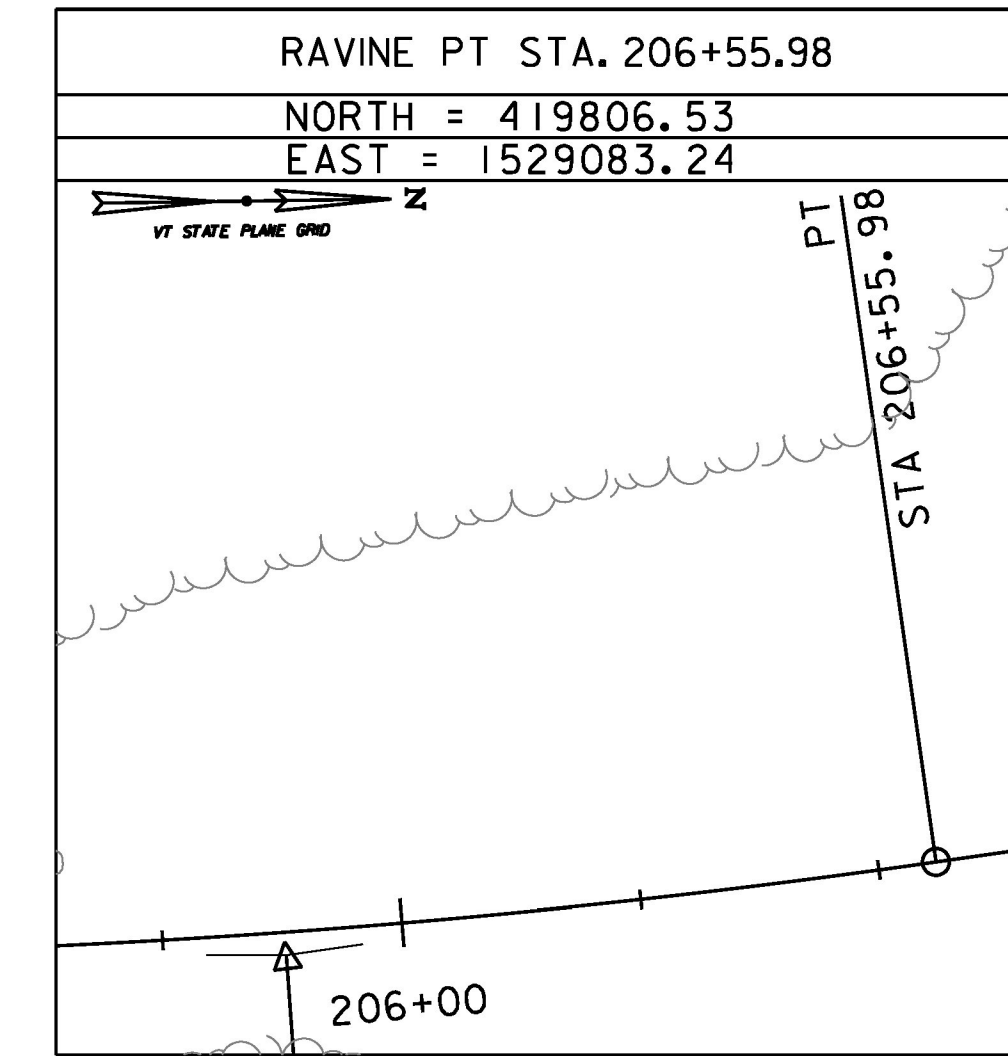
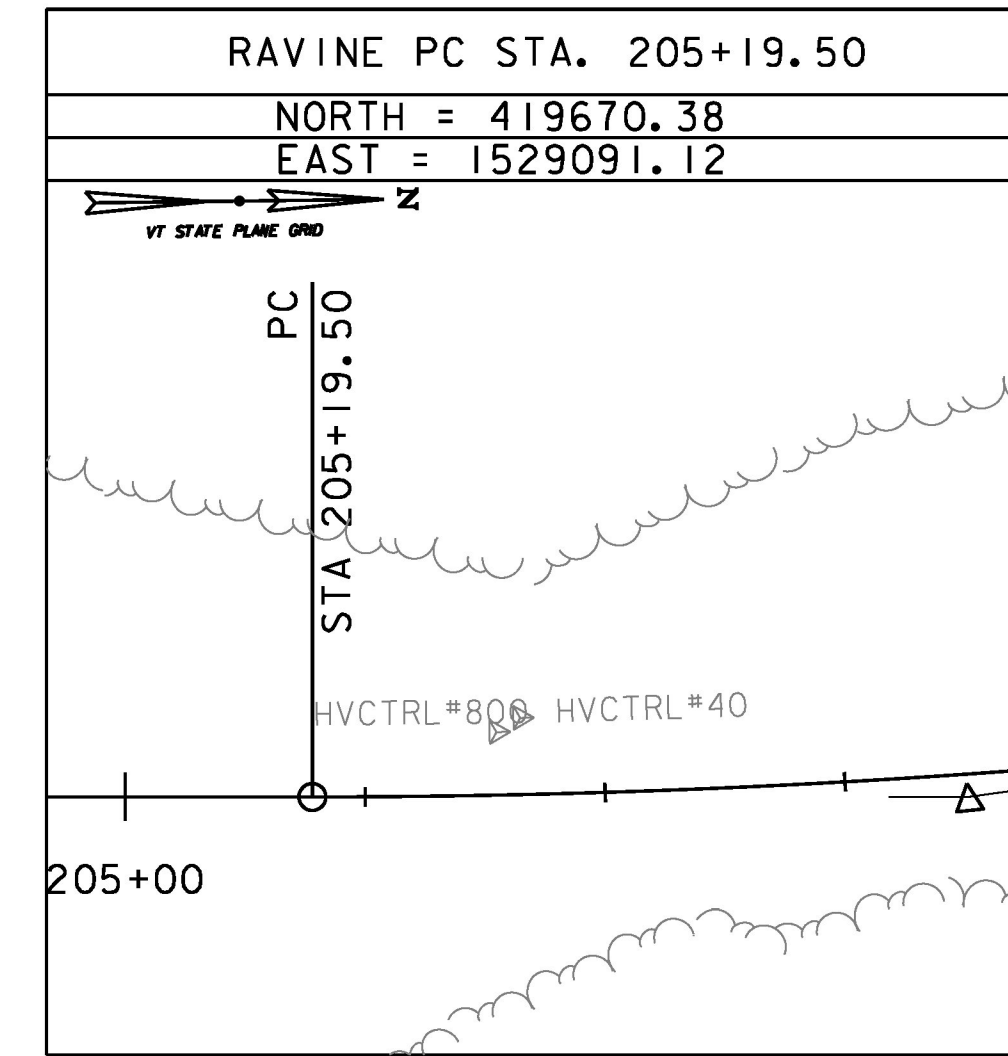
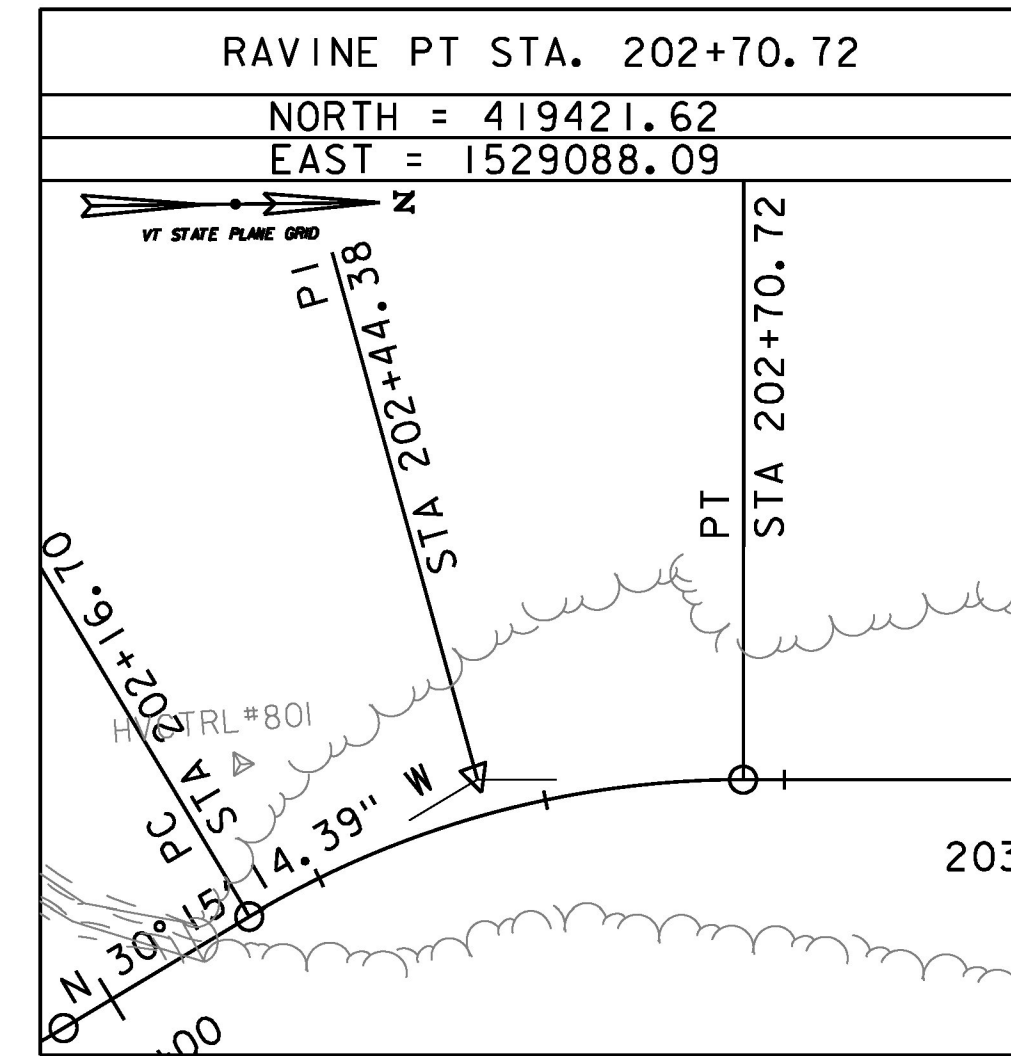
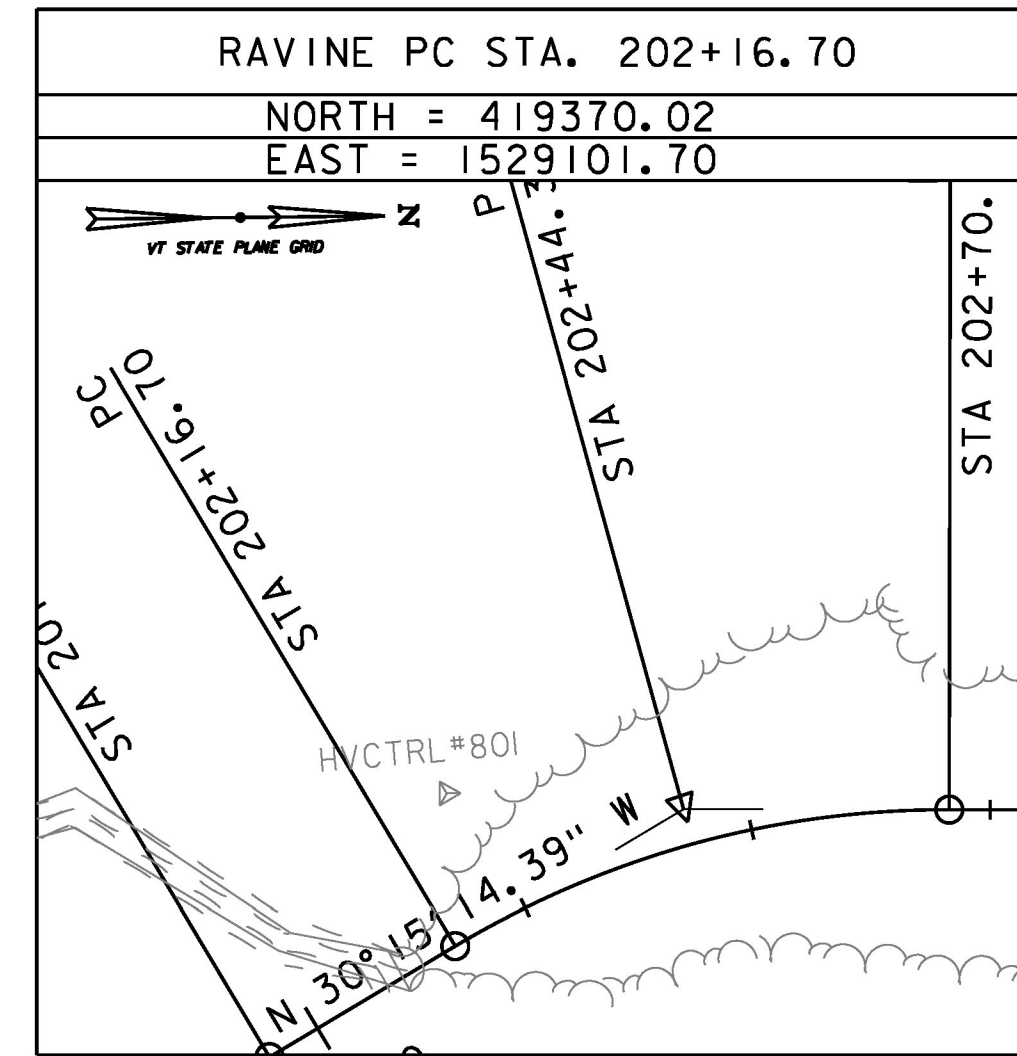
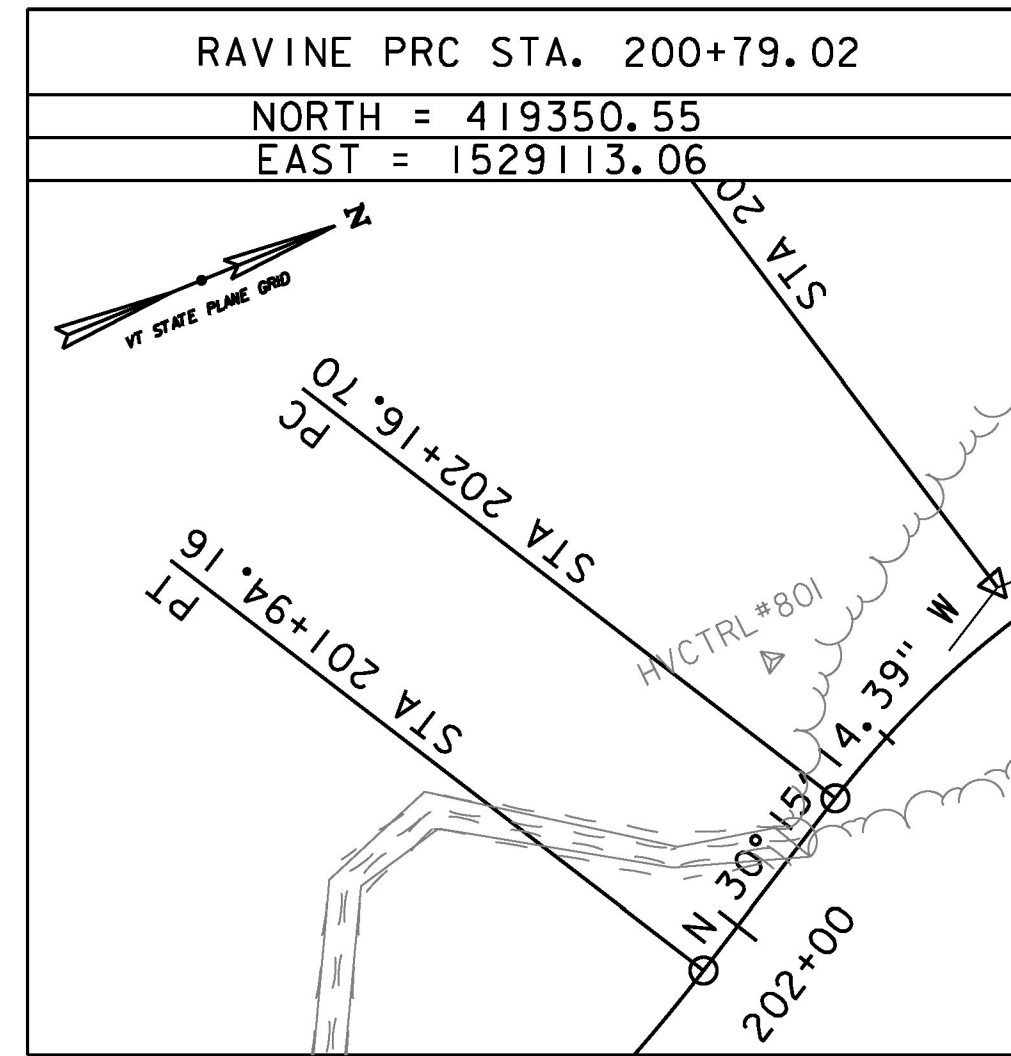
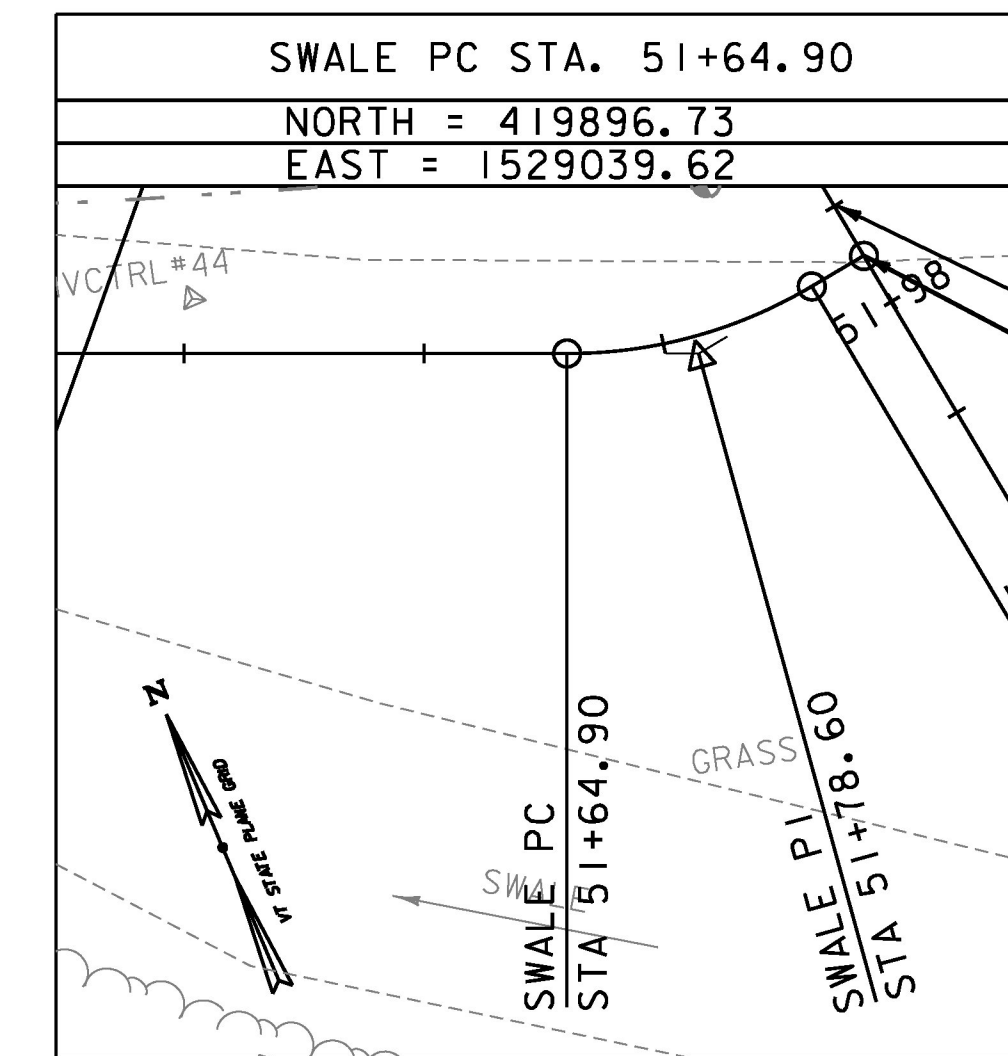
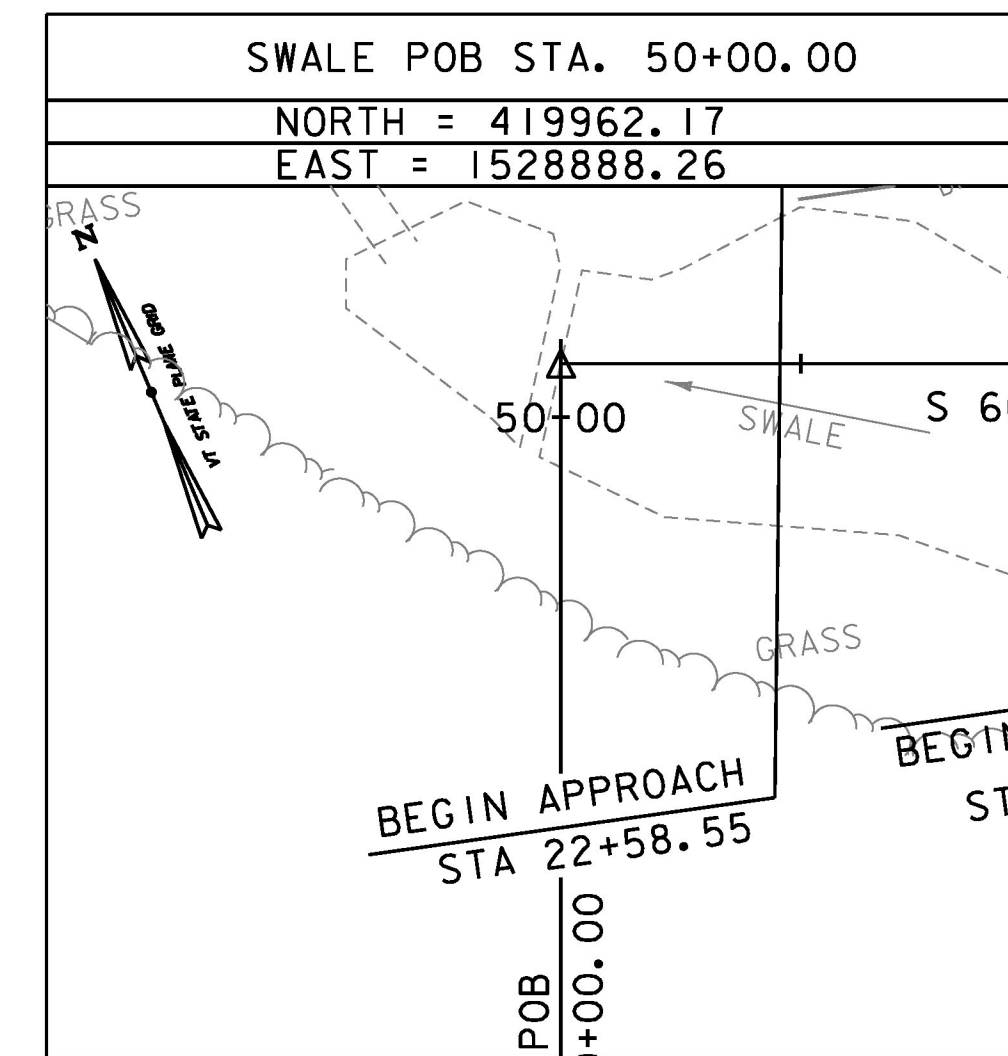
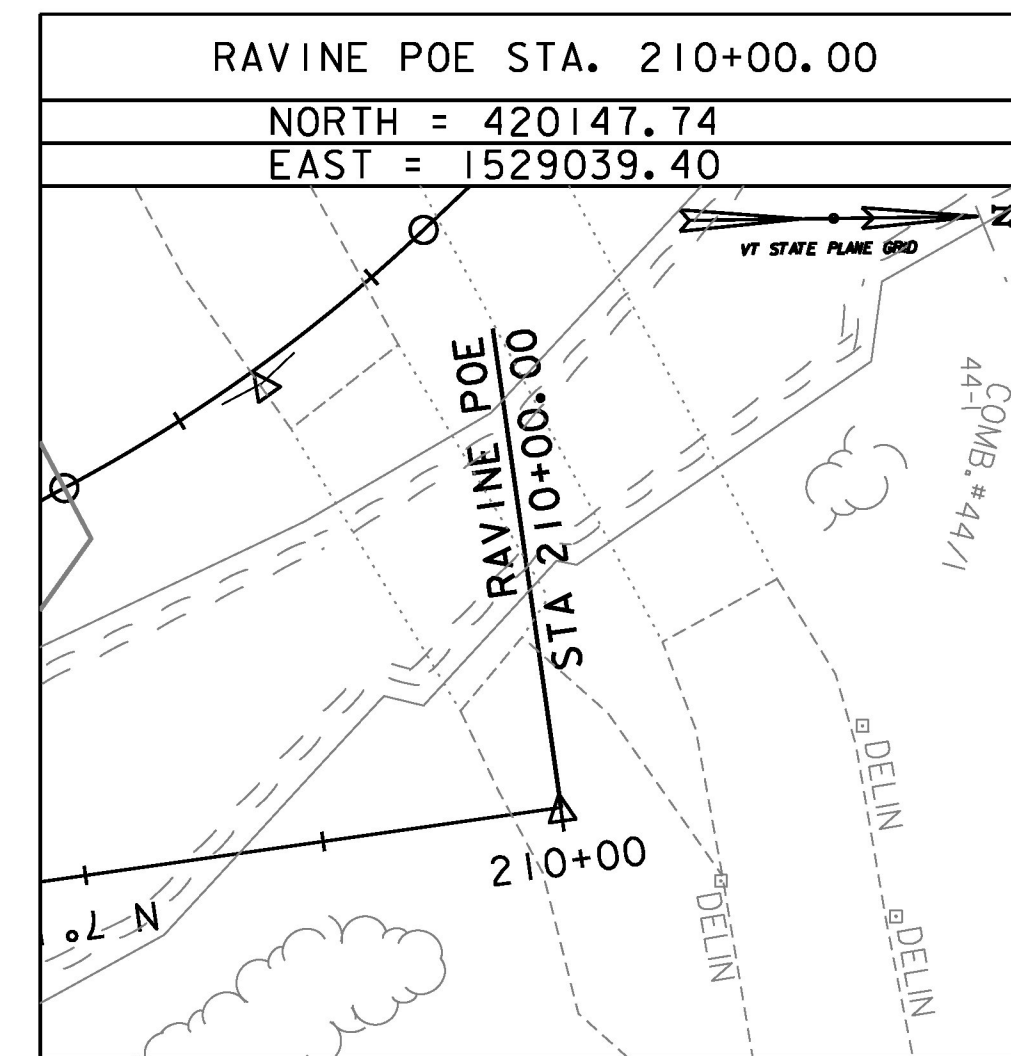







ALIGNMENT TIES

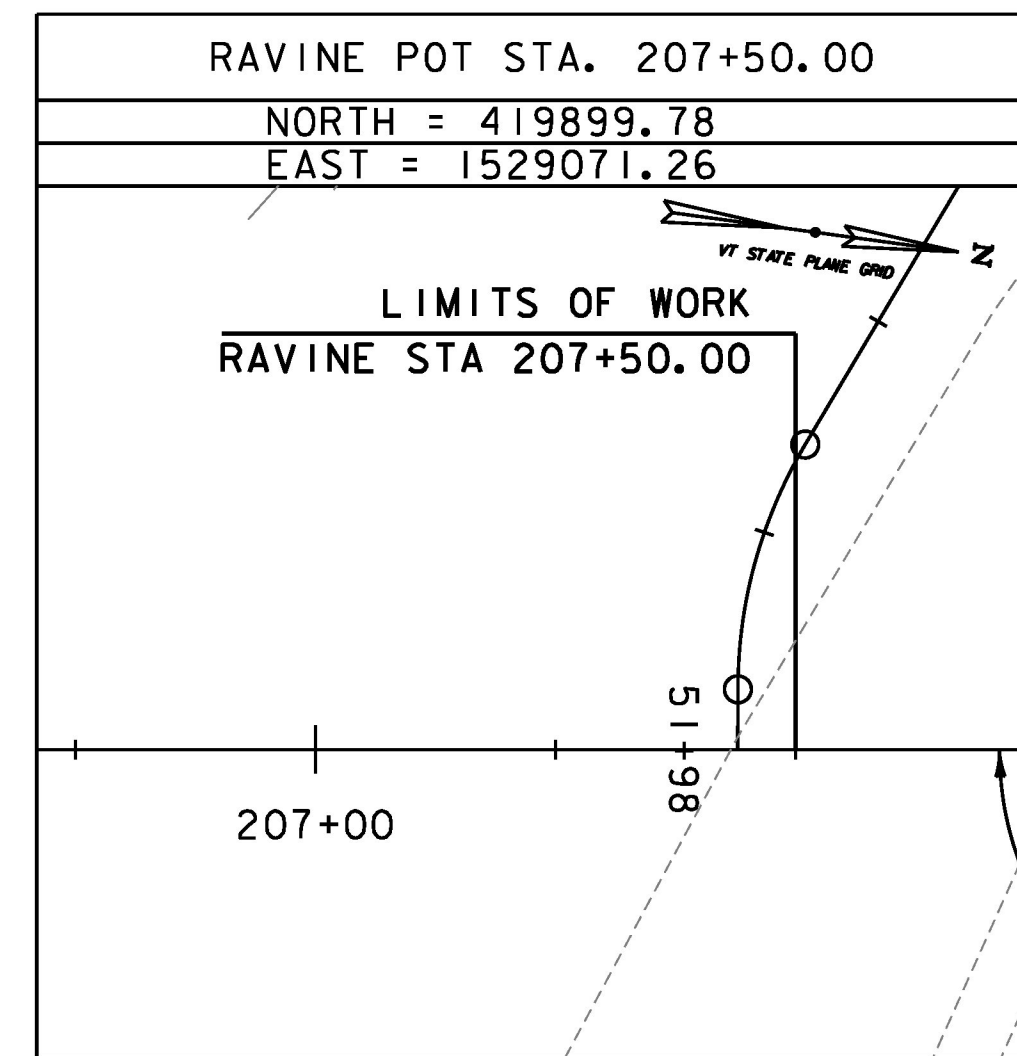

ALIGNMENT TIES

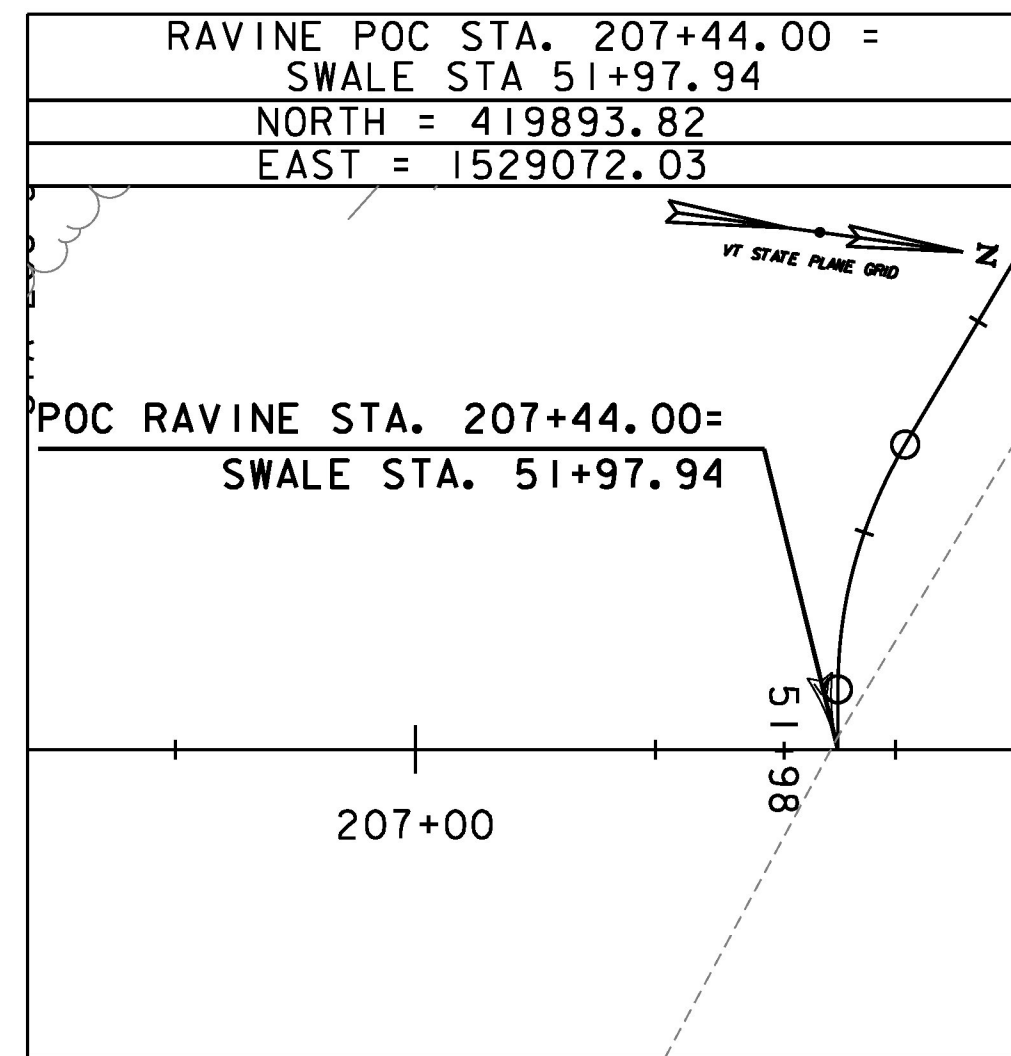

ALIGNMENT TIES

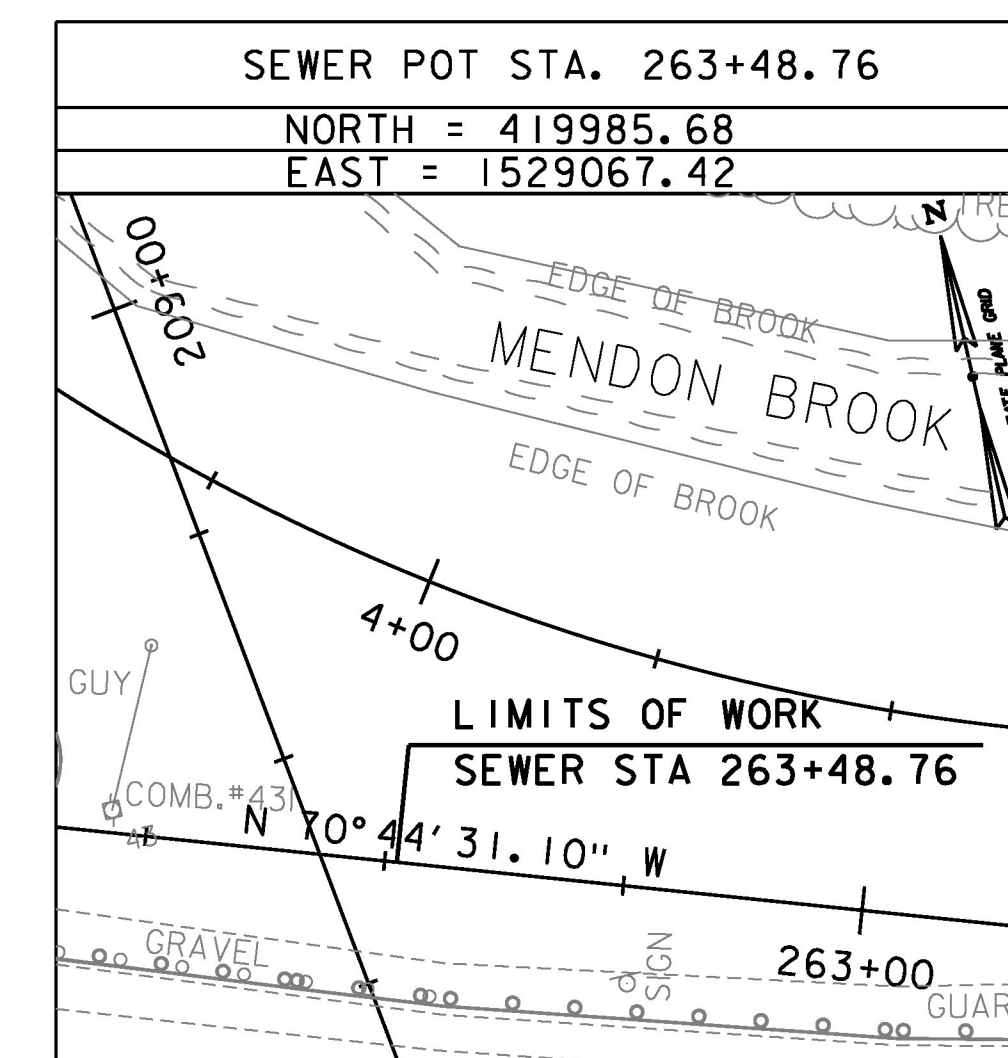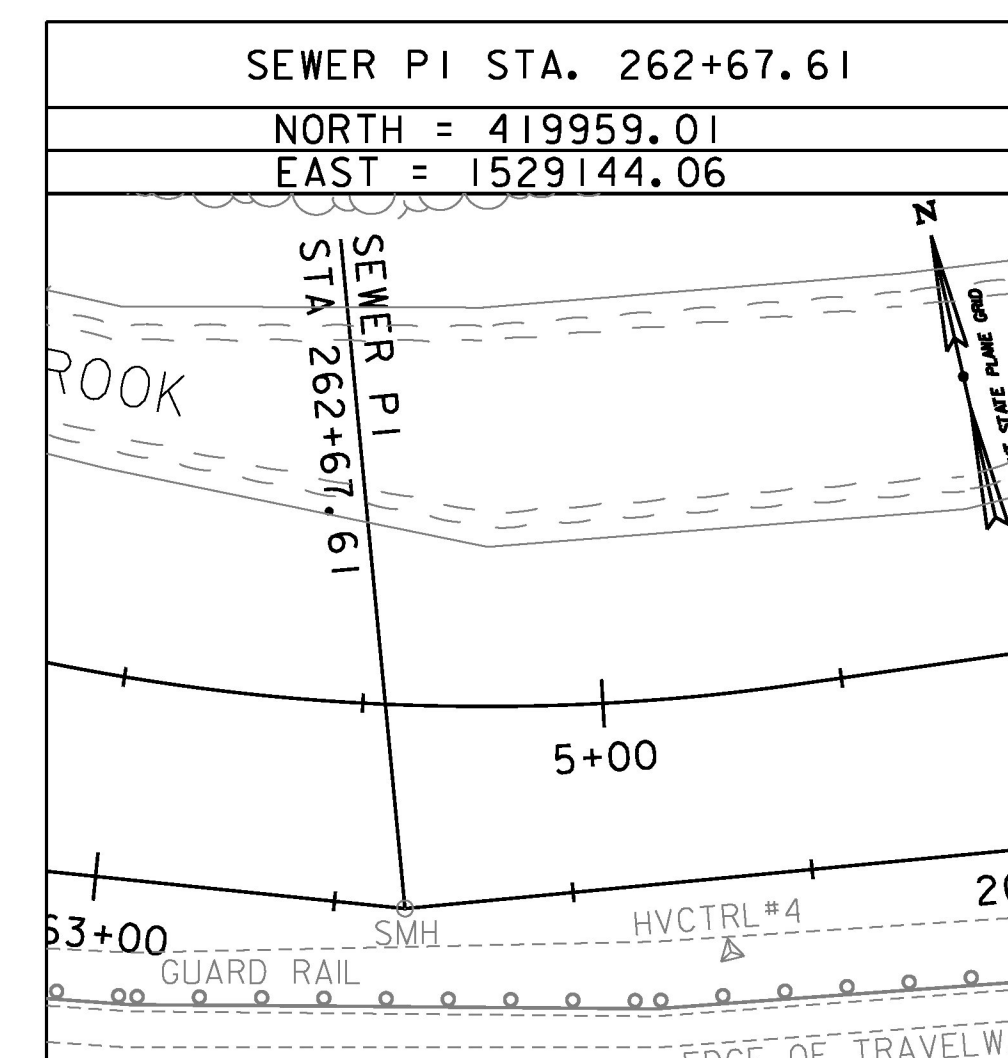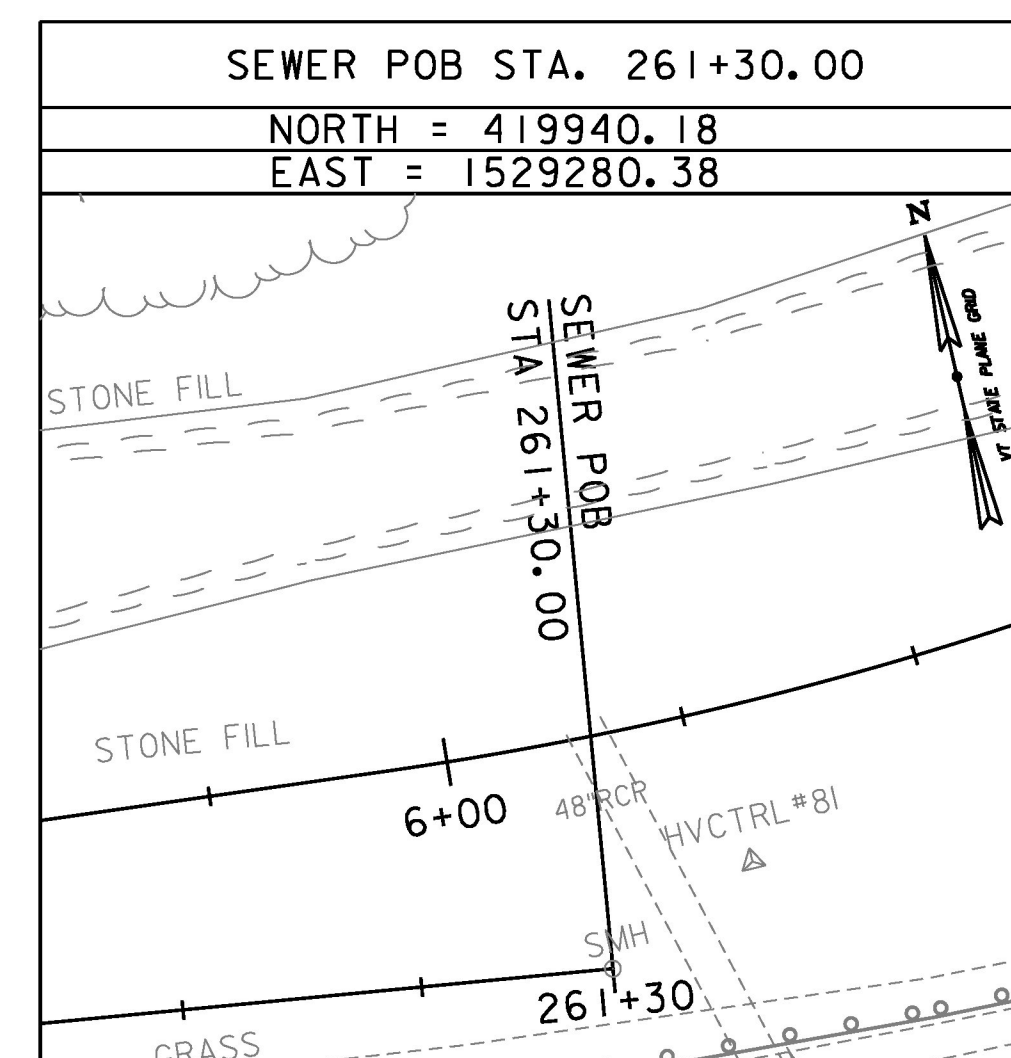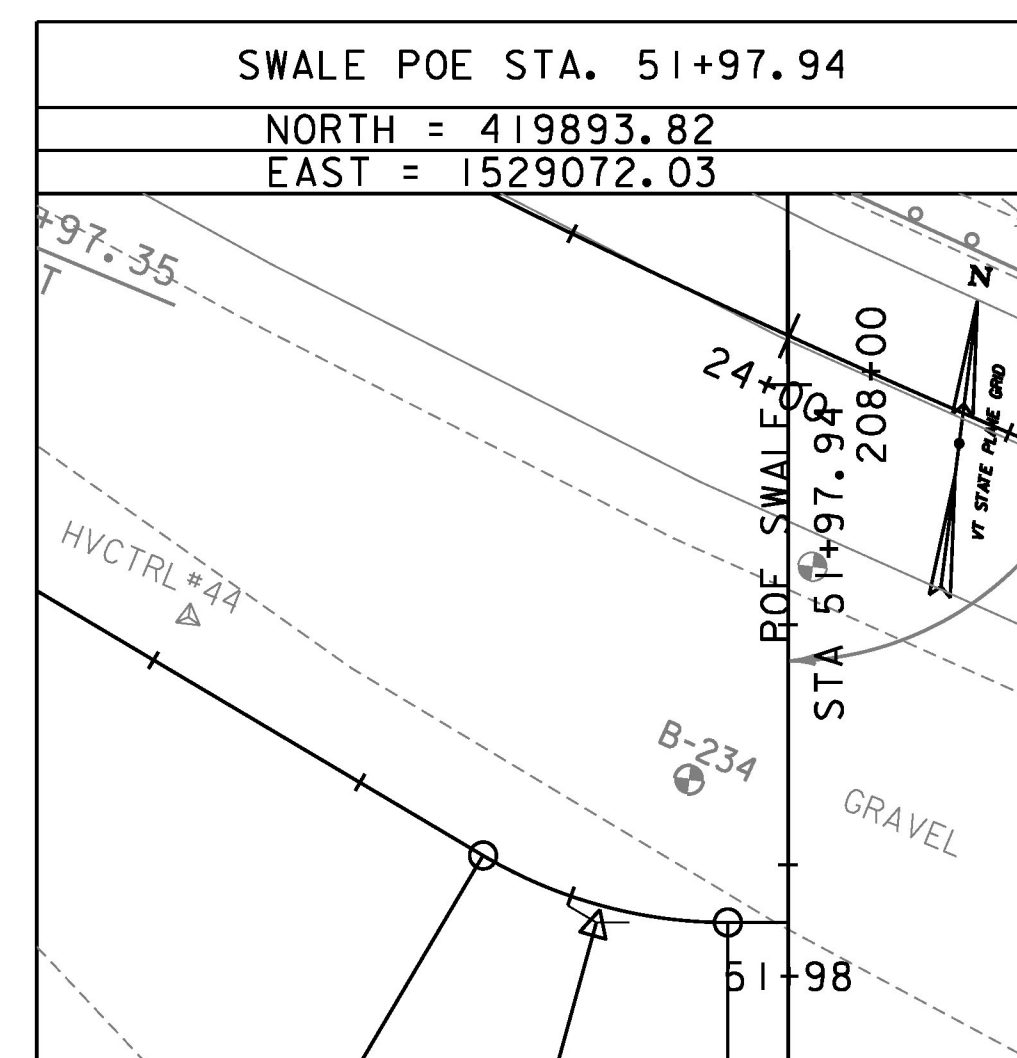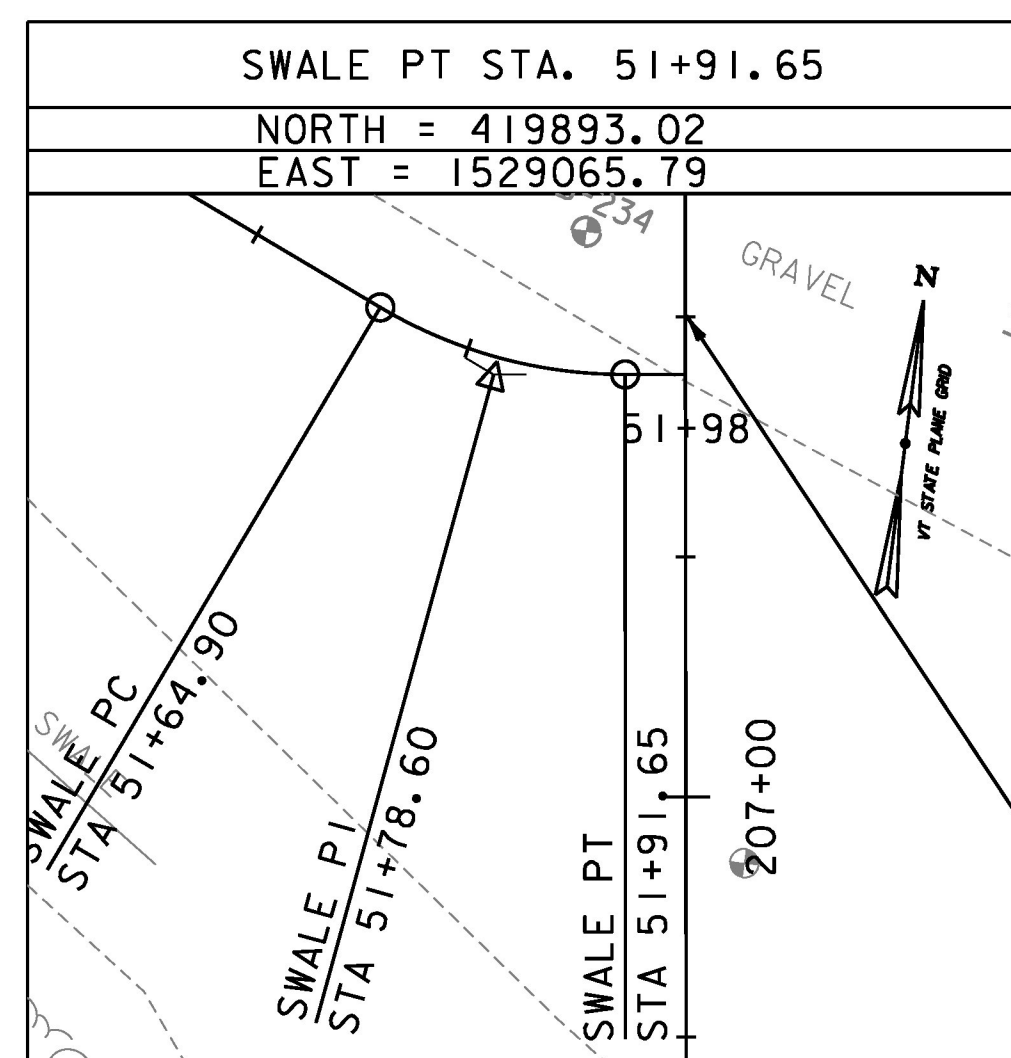

DATUM	
VERTICAL	NAVD 88 FT
HORIZONTAL	NAD 83(2011) sFT
ADJUSTMENT	LSO

PROJECT NAME:	MENDON
PROJECT NUMBER:	ER 020-2(39)
FILE NAME:	z13bi88+1.dgn
PROJECT LEADER:	E. ATKINS
DESIGNED BY:	C. MORIN
TIE SHEET 3	
PLOT DATE:	11/13/2015
DRAWN BY:	C. MORIN
CHECKED BY:	E. ATKINS
SHEET	18 OF 72

NOT TO SCALE

