 
 


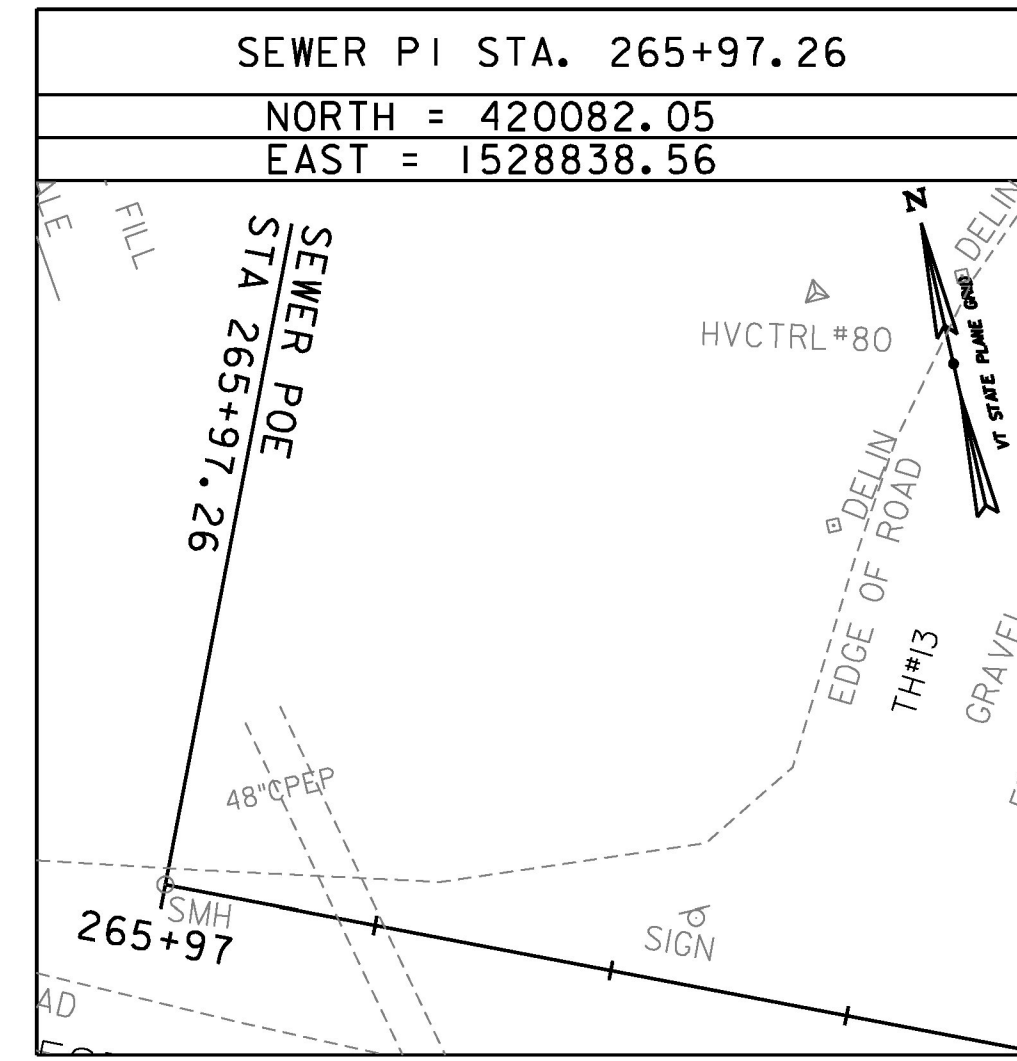 
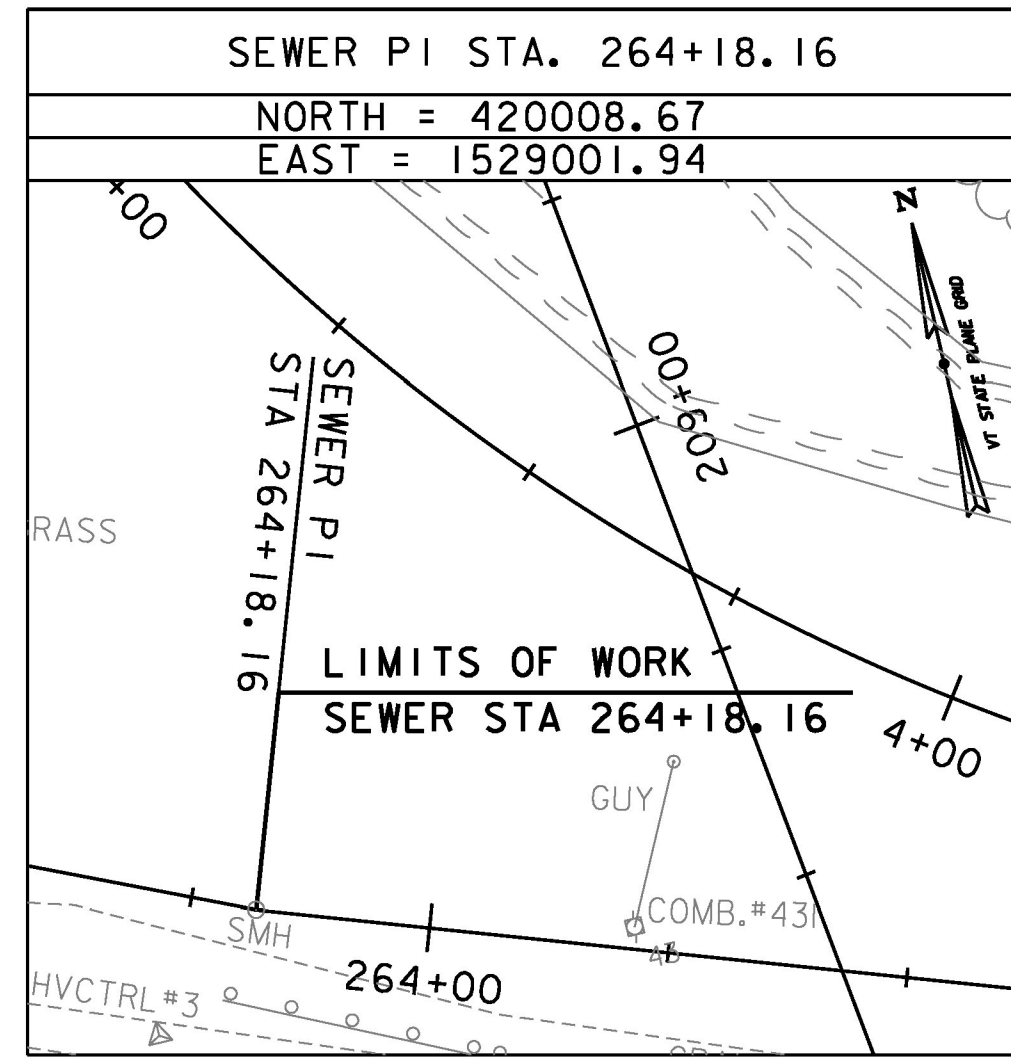 
 
 
 







ALIGNMENT TIES



ALIGNMENT TIES



     ALIGNMENT TIES



DATUM

VERTICAL NAVD 88 FT

HORIZONTAL NAD 83(2011) SFT

ADJUSTMENT LSO

PROJECT NAME: MENDON

PROJECT NUMBER: ER 020-2(39)

FILE NAME: z13bi88+1.dgn
 PROJECT LEADER: E. ATKINS
 DESIGNED BY: C. MORIN
 TIE SHEET 4

PLOT DATE: 11/13/2015
 DRAWN BY: C. MORIN
 CHECKED BY: E. ATKINS
 SHEET 19 OF 72

NOT TO SCALE

