


MENDON BROOK CURVE #1	MENDON BROOK CURVE #2	MENDON BROOK CURVE #3
DELTA = 15° 34' 39.93"	DELTA = 57° 40' 06.36"	DELTA = 12° 57' 38.54"
D = 33° 42' 12.24"	D = 24° 54' 40.35"	D = 15° 04' 40.21"
R = 170.00'	R = 230.00'	R = 380.00'
T = 23.25'	T = 126.62'	T = 43.16'
L = 46.22'	L = 231.50'	L = 85.96'
E = 1.58'	E = 32.55'	E = 2.44'

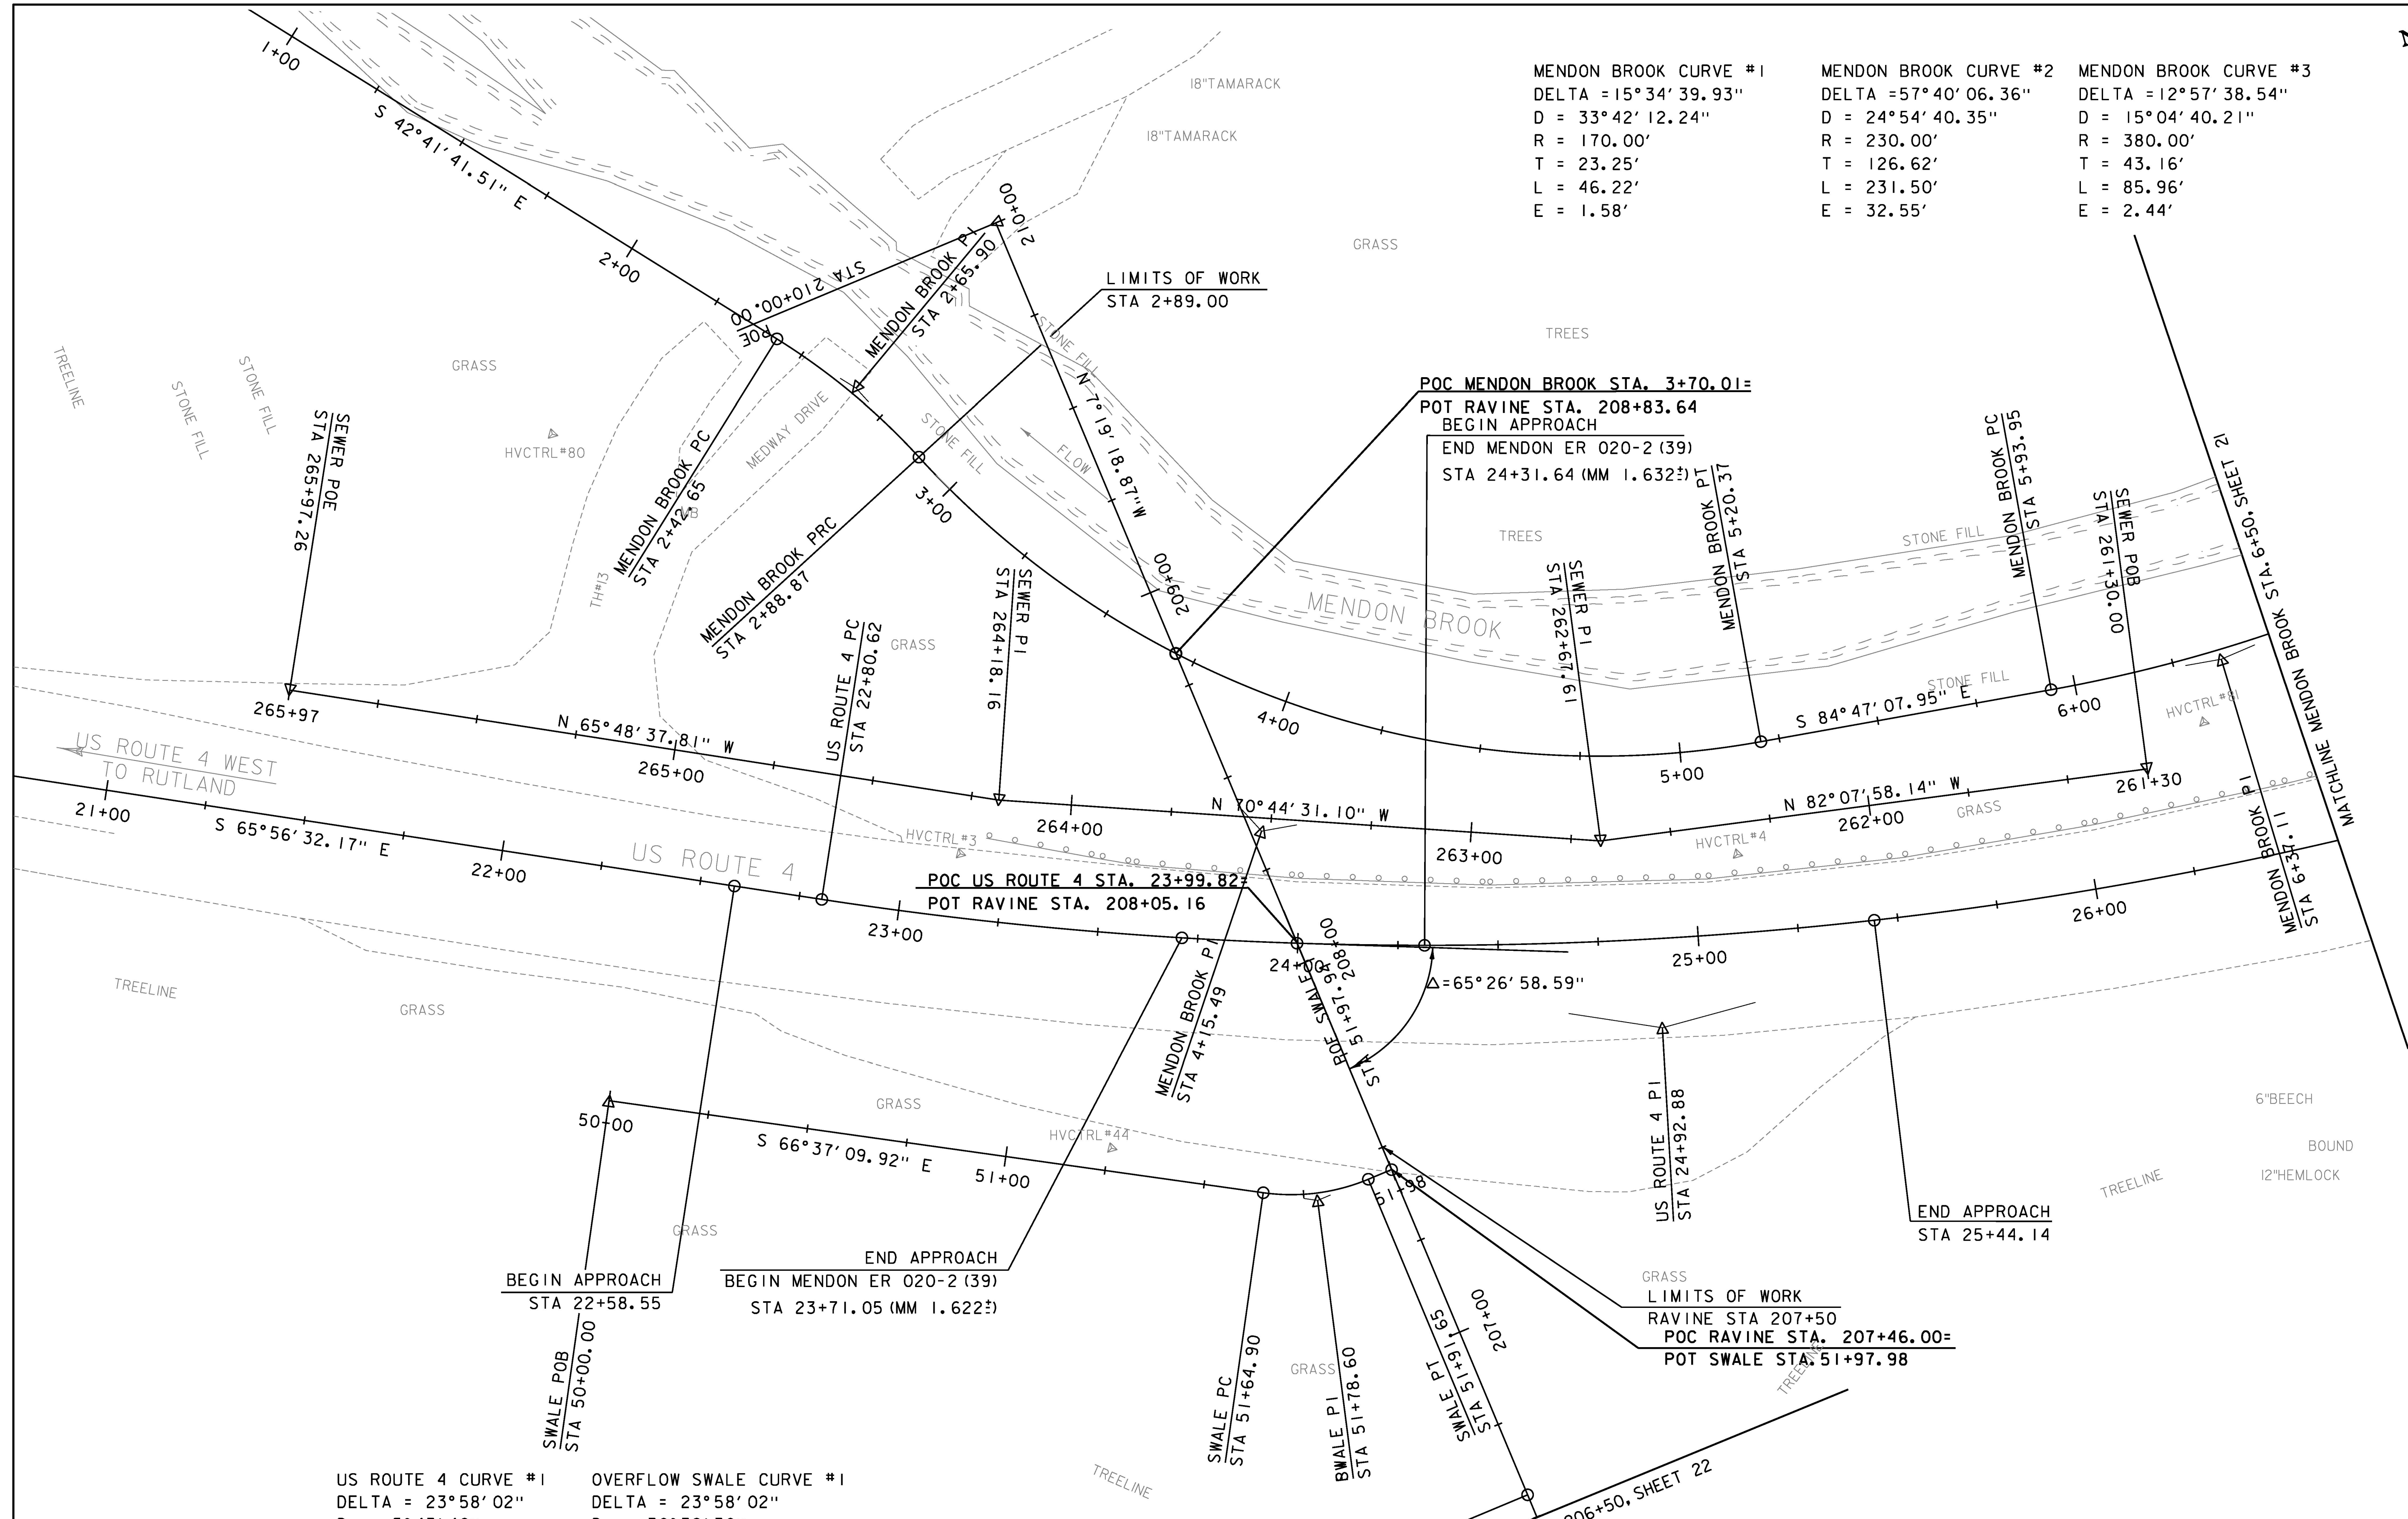

US ROUTE 4 CURVE #1	OVERFLOW SWALE CURVE #1
DELTA = 23° 58' 02"	DELTA = 23° 58' 02"
D = 5° 43' 46"	D = 30° 39' 30"
R = 1000.00'	R = 50.00'
T = 212.26'	T = 13.71'
L = 418.31'	L = 26.75'
E = 22.28'	E = 1.84'
BANKING = 0.083	

DATUM	
VERTICAL	NAVD 88 FT
HORIZONTAL	NAD 83(2011) sFT
ADJUSTMENT	LSO



GREEN INTERNATIONAL AFFILIATES, INC.
CIVIL AND STRUCTURAL ENGINEERS

PROJECT NAME:	MENDON	PLOT DATE:	11/13/2015
PROJECT NUMBER:	ER 020-2(39)	DRAWN BY:	M. BRADLEY
FILE NAME:	z13bi88algnbdr.dgn	CHECKED BY:	E. ATKINS
DESIGNED BY:	M. BRADLEY	SHEET	20 OF 72
ALIGNMENT SHEET	1		